
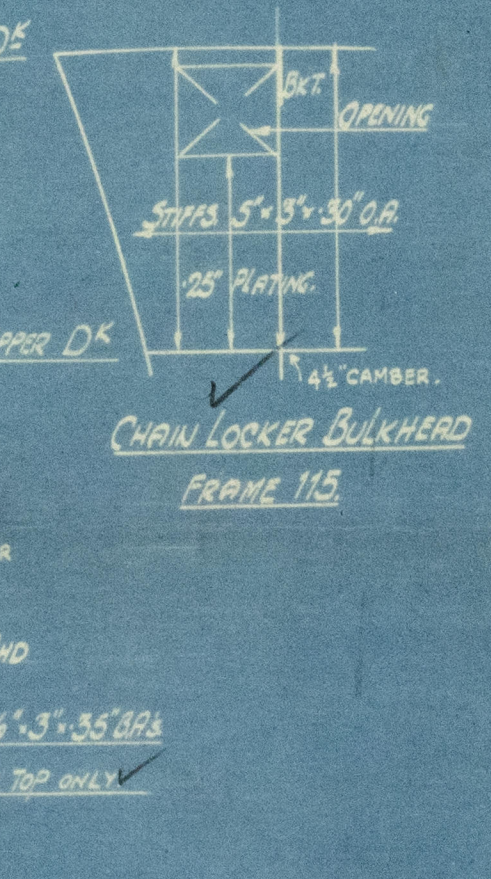
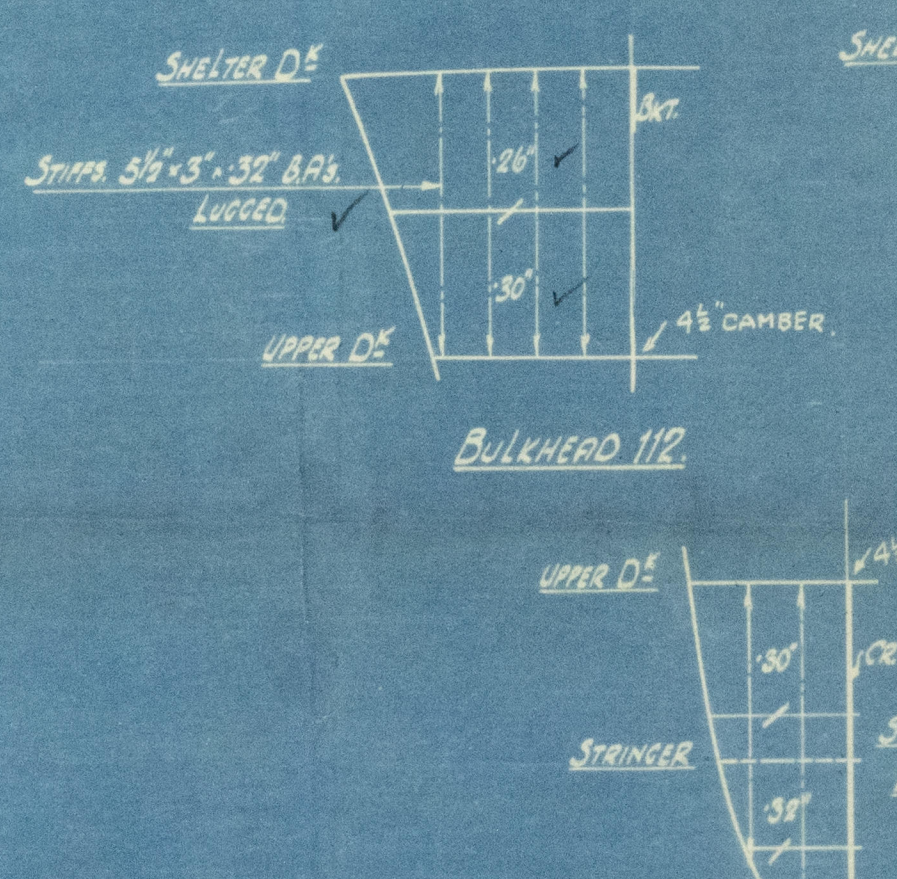
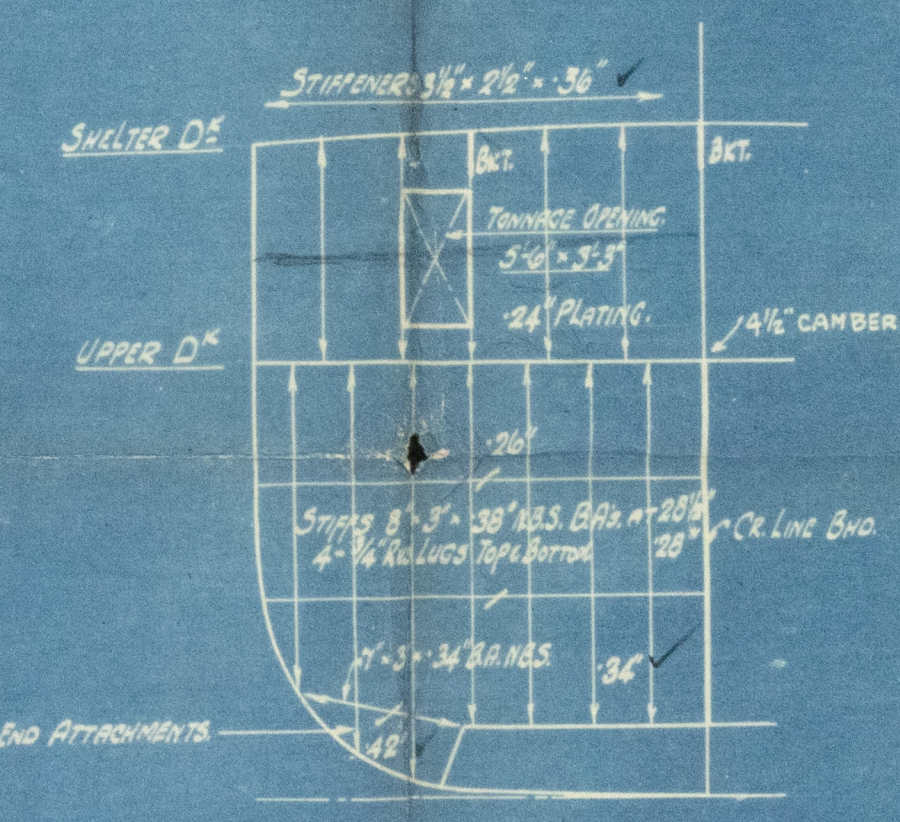
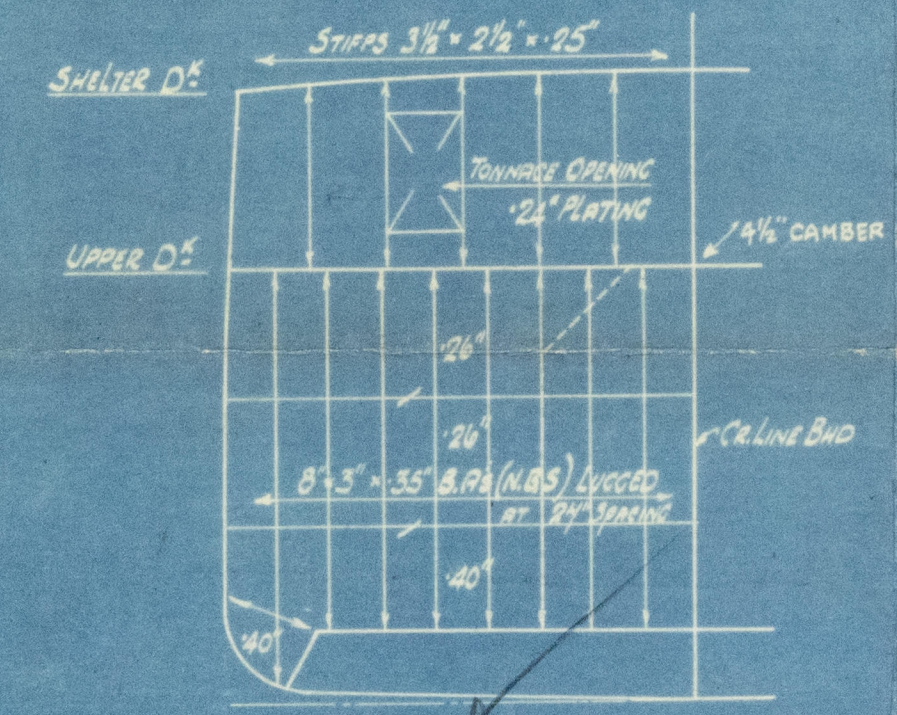
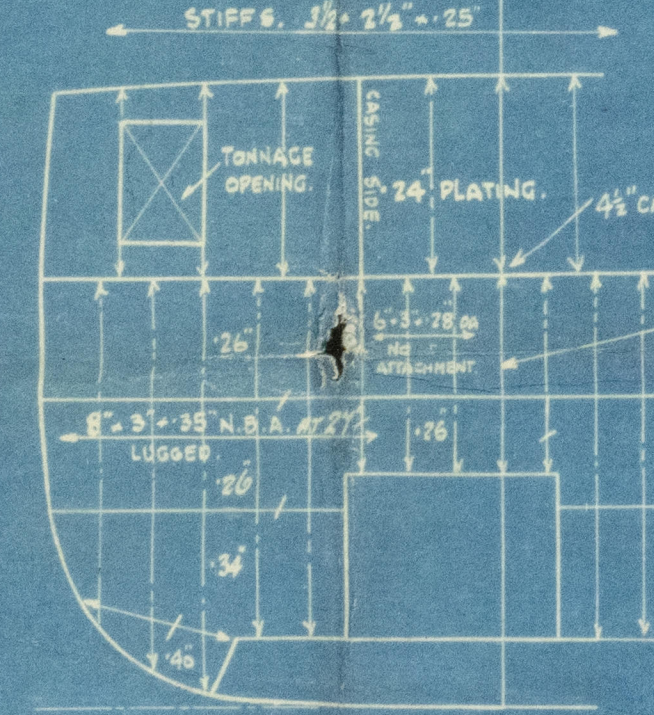
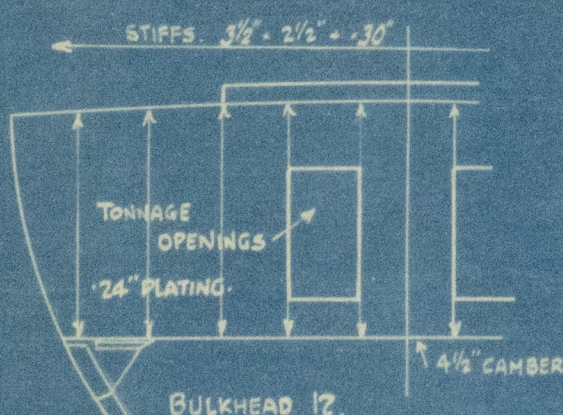
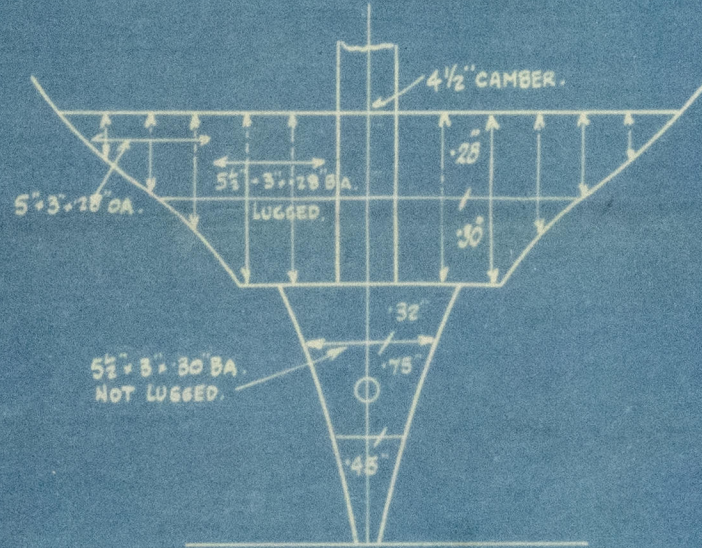


N<sup>o</sup> 346.











# PROFILE & DECKS.

260' . 40' . 26' To SHELTER D<sup>o</sup>  
16' 6" To UPPER D<sup>o</sup>.

SCALE 1/8" = 1 FOOT.

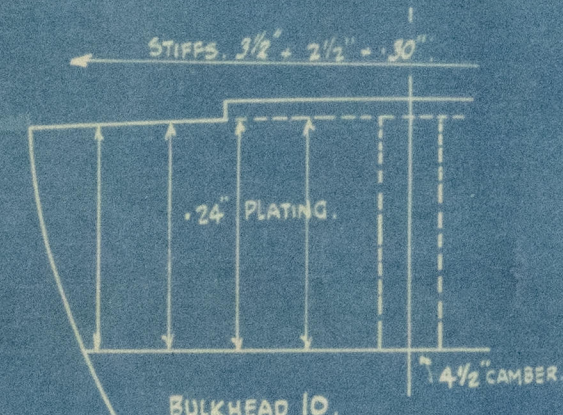

Approved 28.2.24  
(See letter) 6.

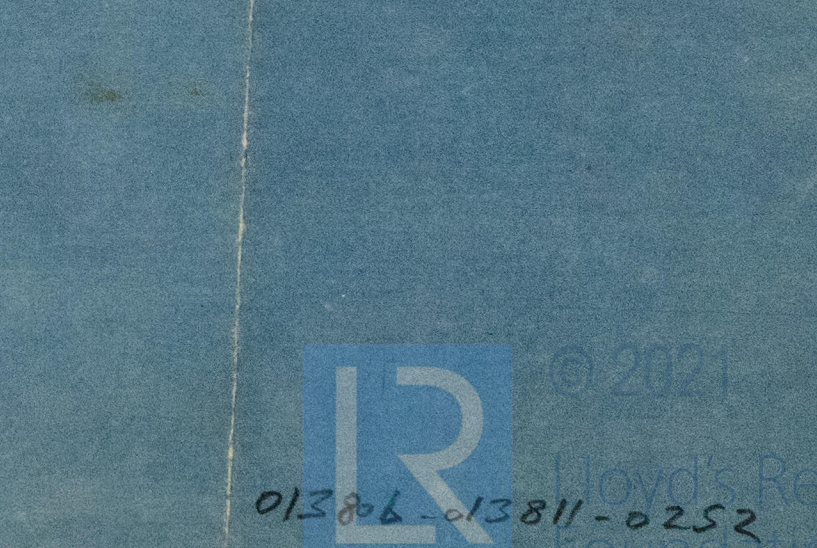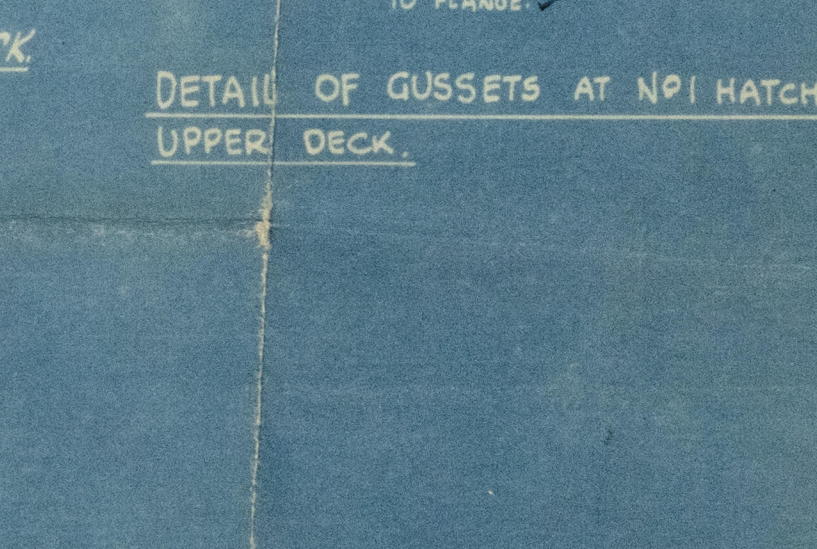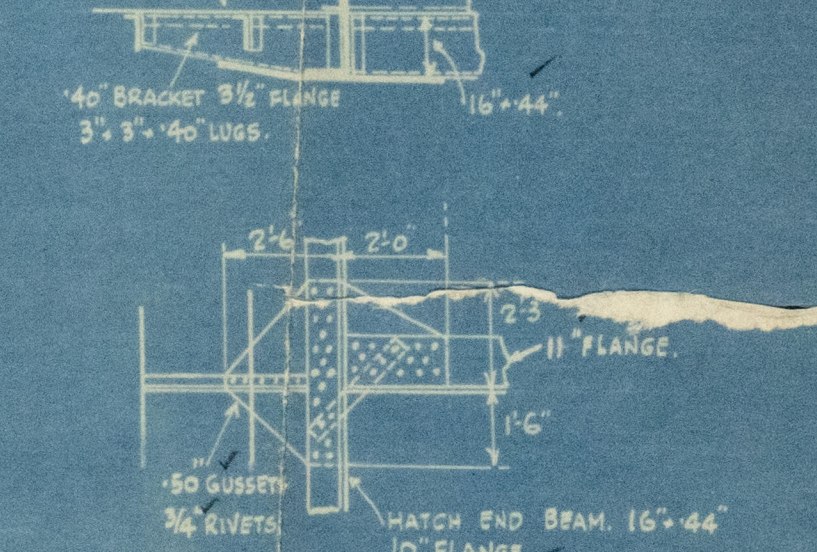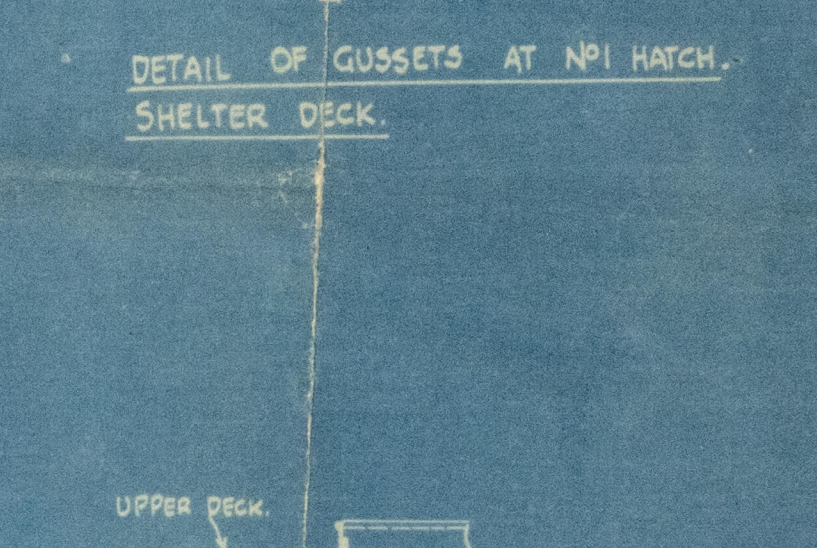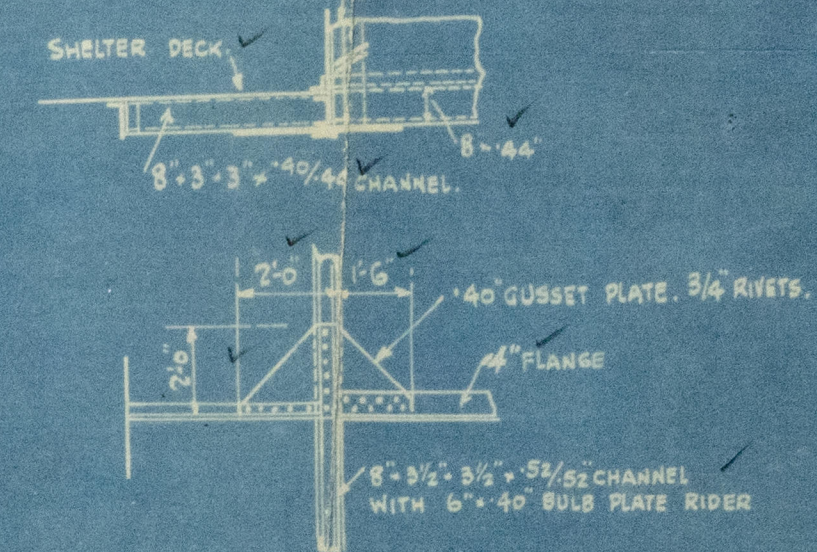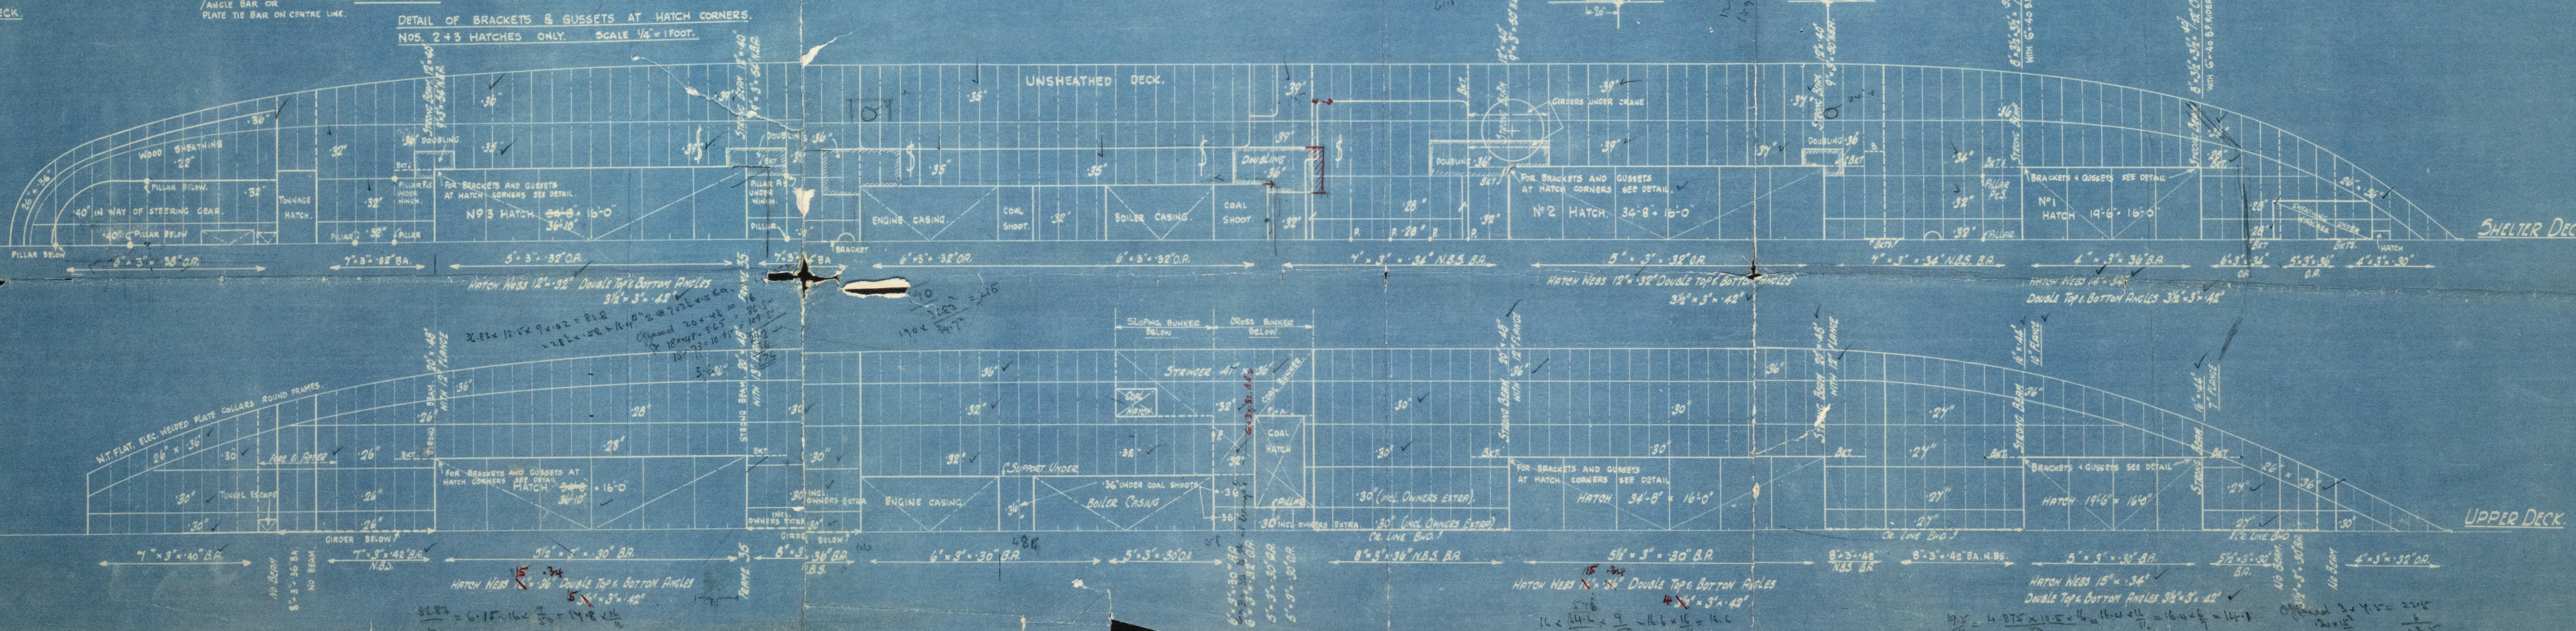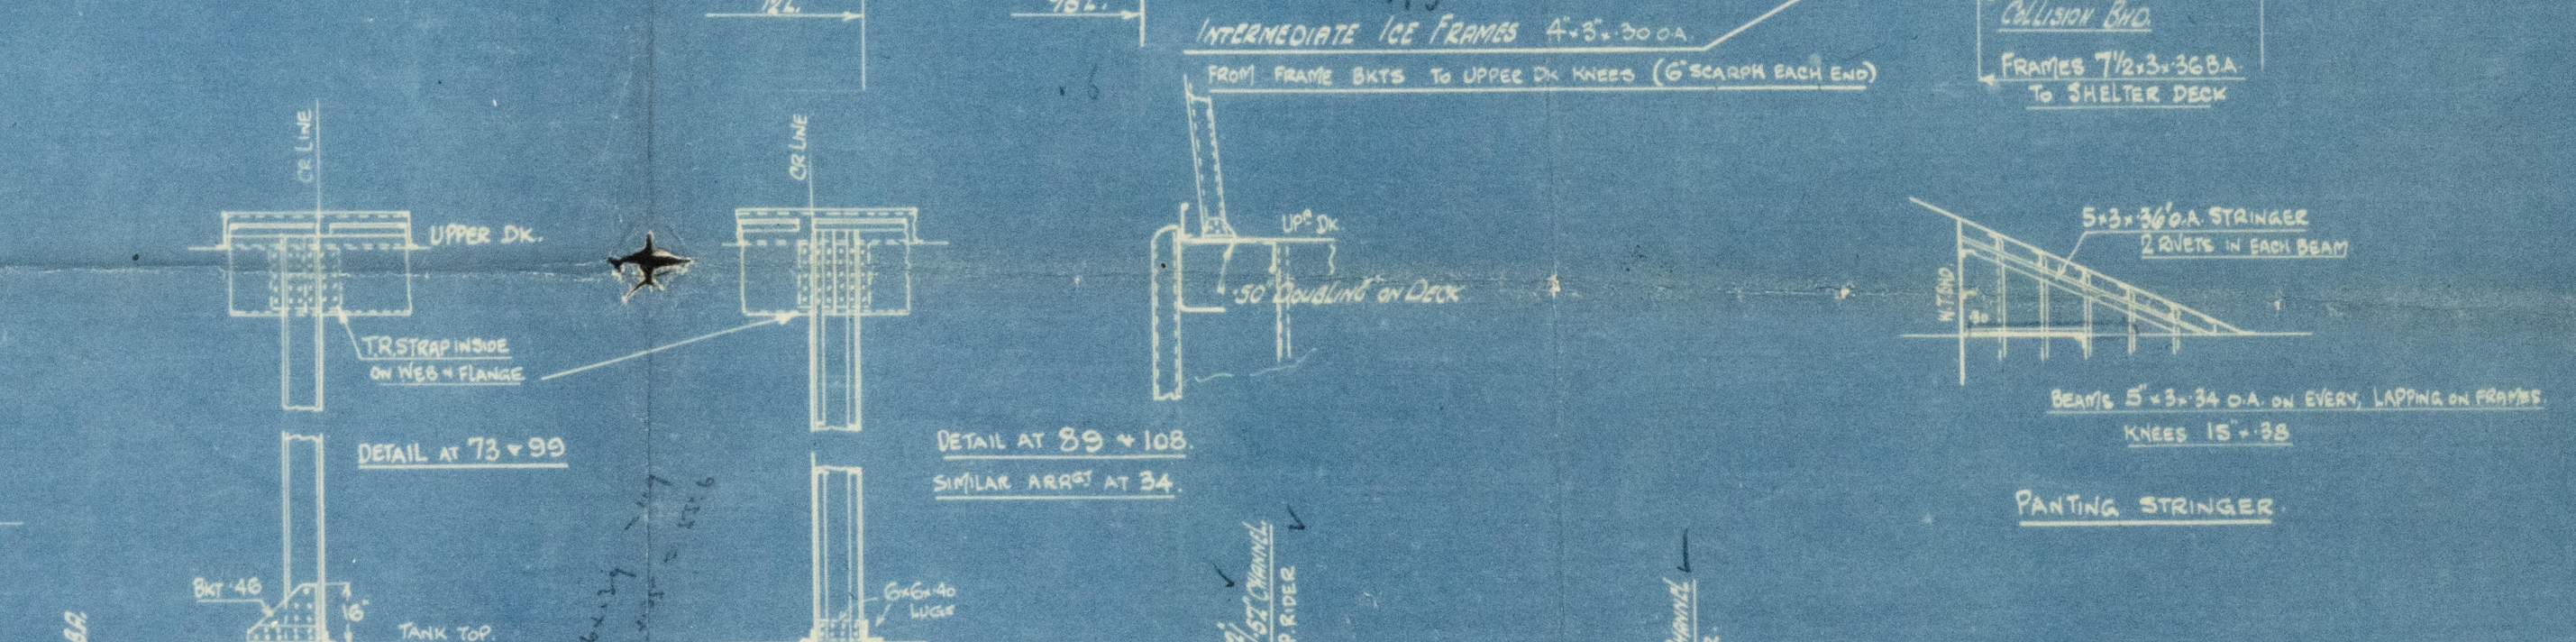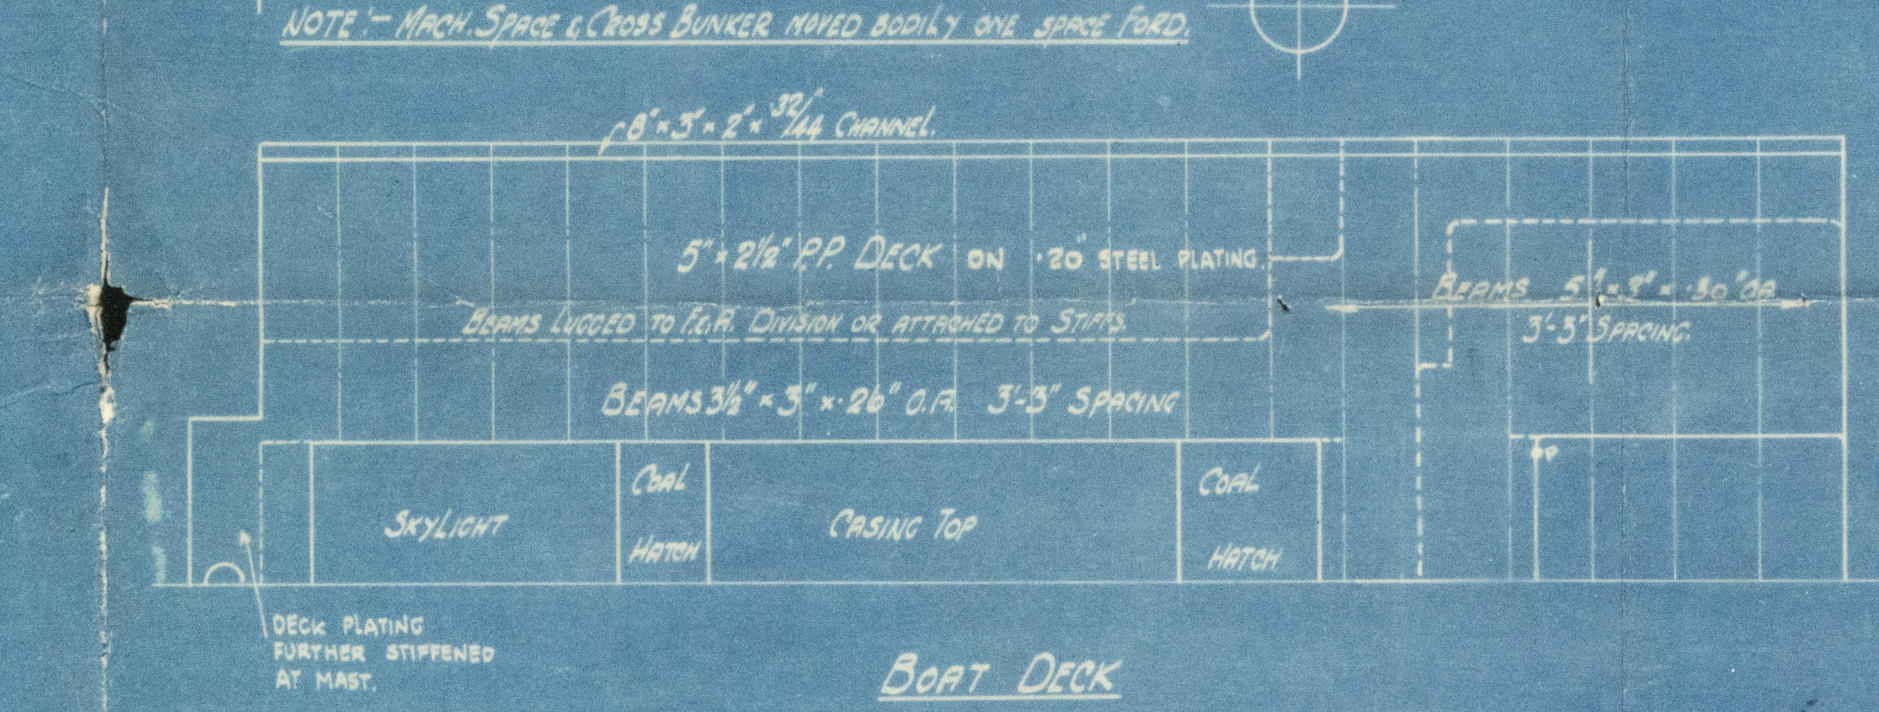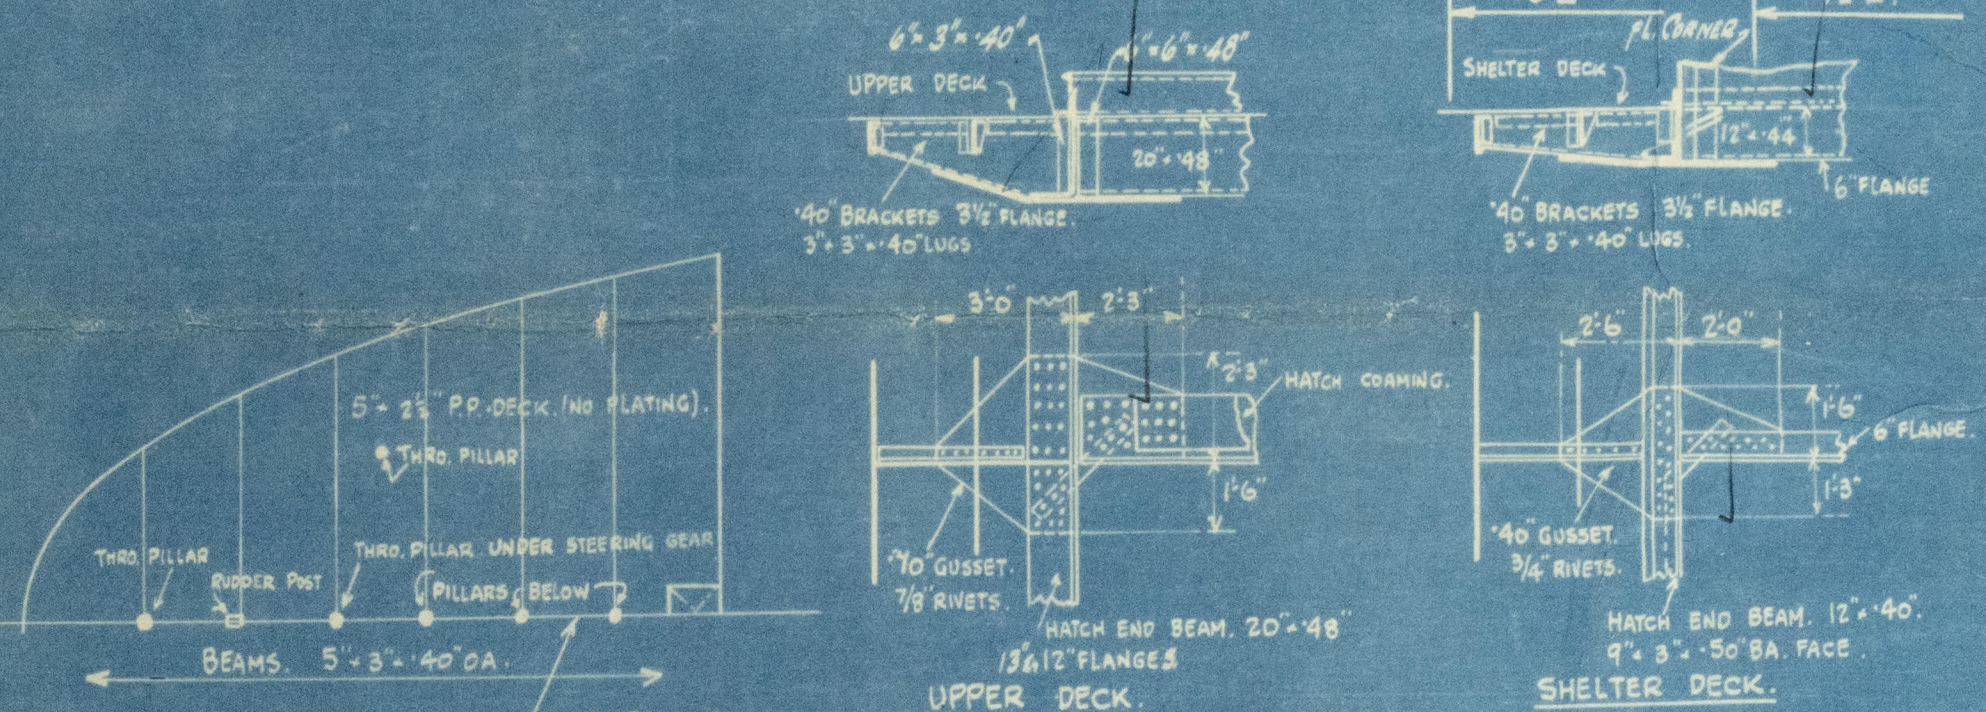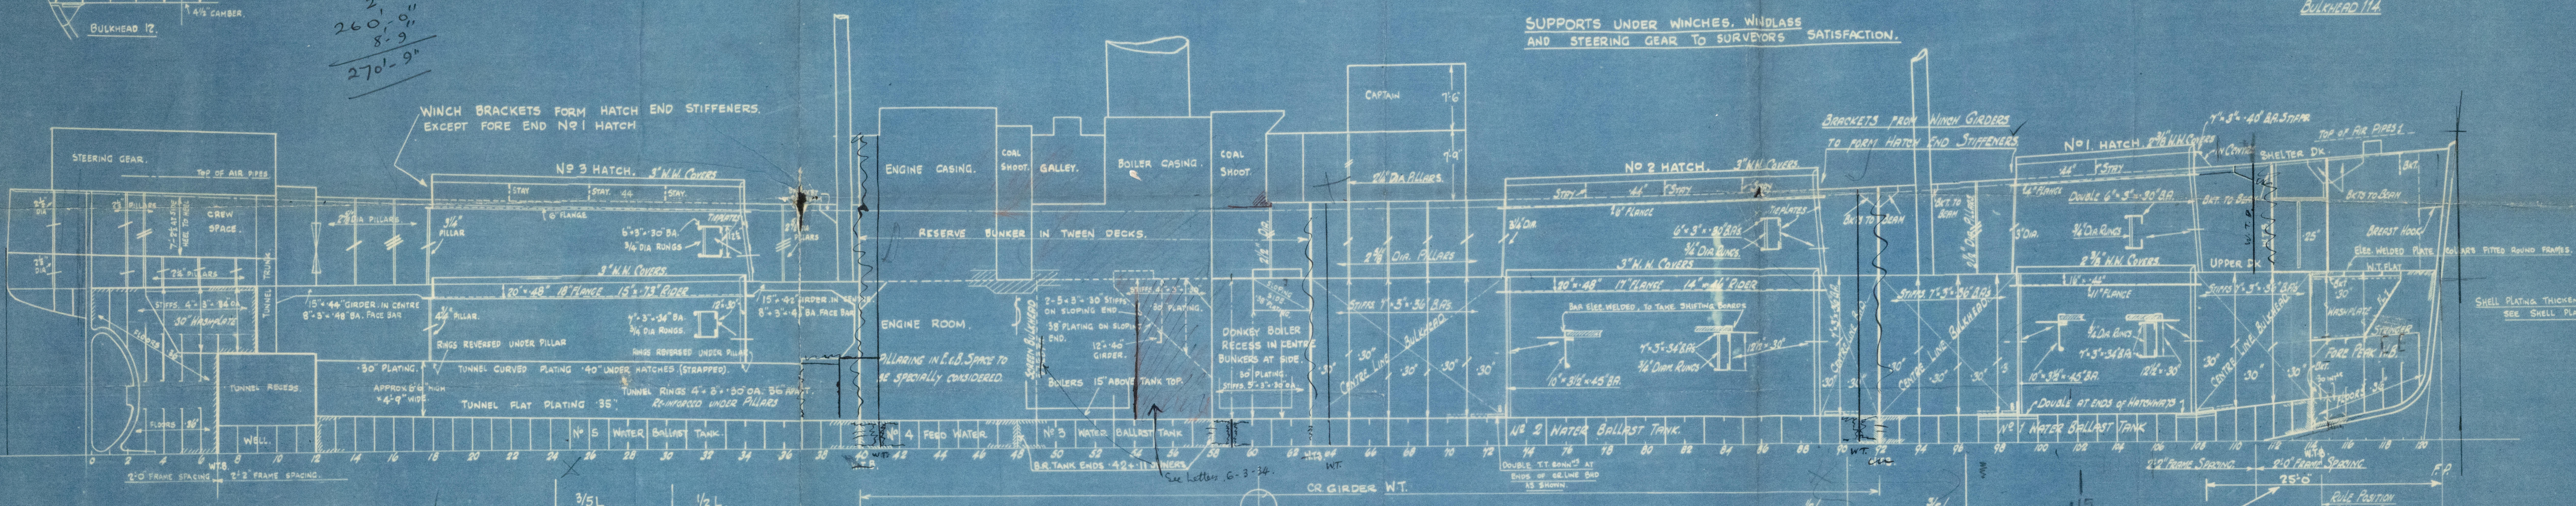



3

And. Profile & Deck.

Haledon & Co. Co.

No. 346.

28. 2. 24.

Also for Barclay Curle & Co. No. 652.

346. KIRKLAND ~~✱~~

652. MERKLAND ✱

GUERNSEY



© 2021

Lloyd's Register  
Foundation

013806-013811-0253



Ind. Single Dick.

Oaledon 346.

Boo.



© 2021

Lloyd's Register  
Foundation

013806 - 013811 - 0252



22

013806-013811-0252

31  
03  
28

21  
18  
1

