
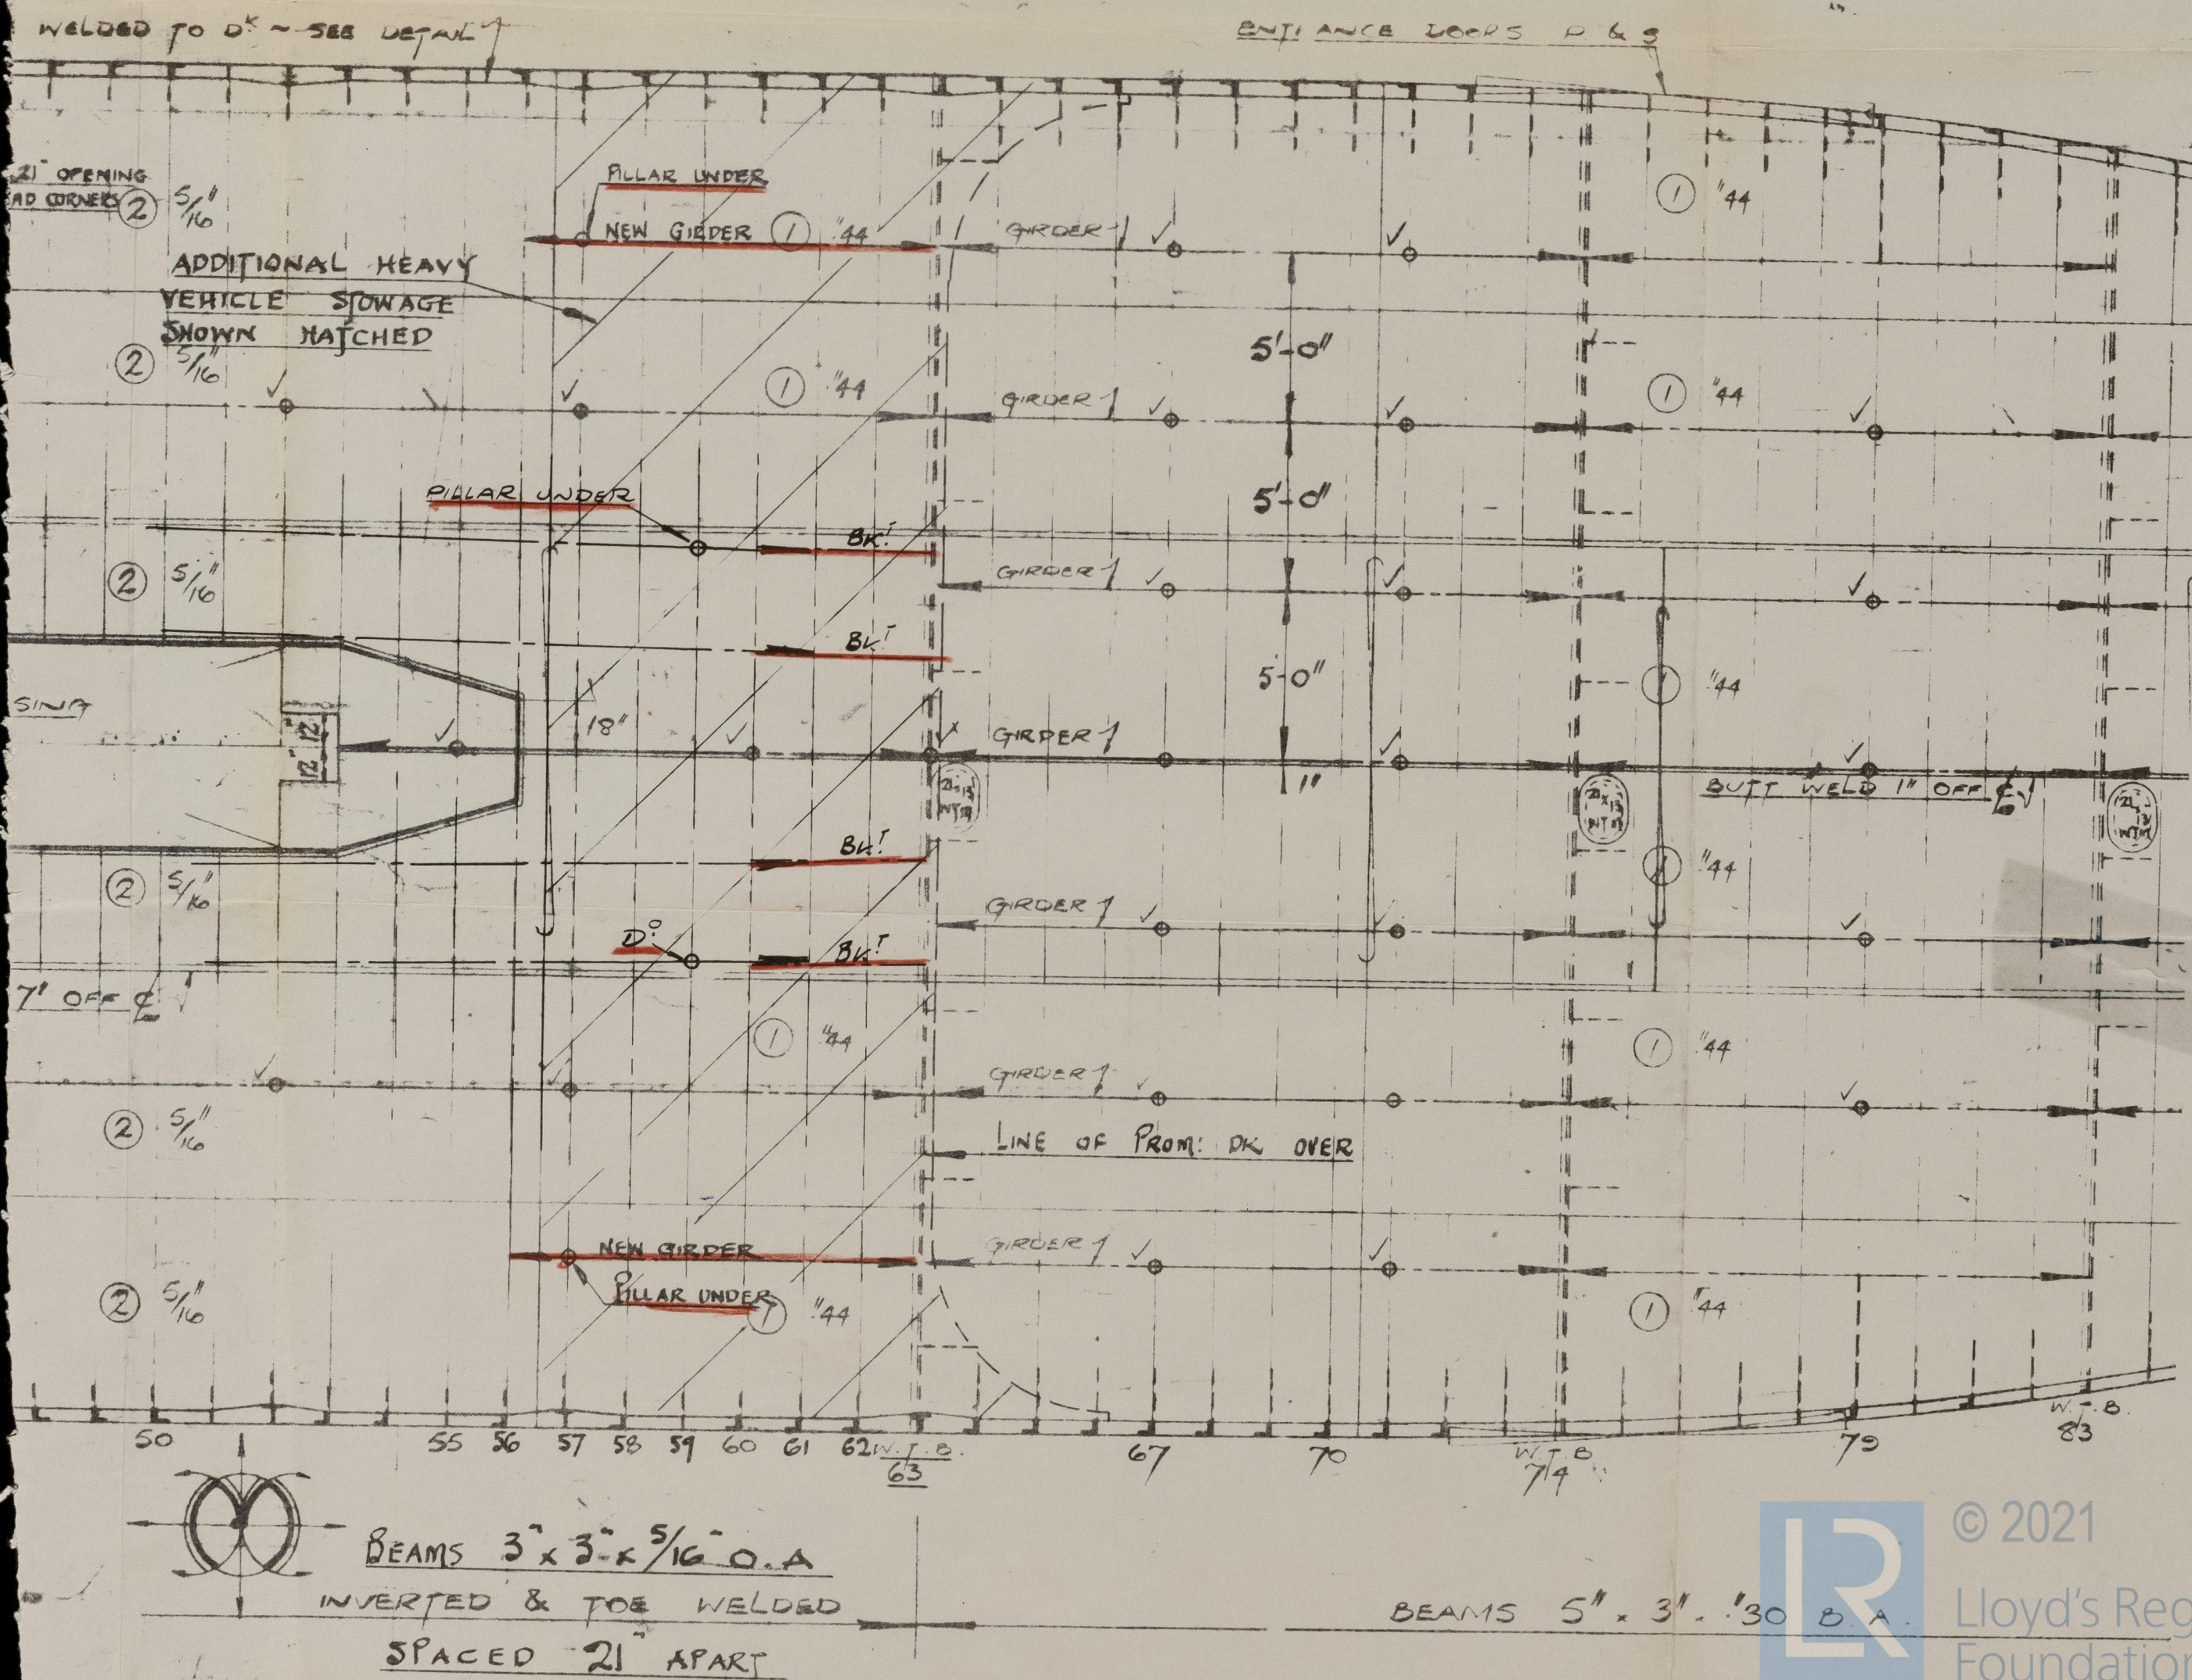



M. V. "CARISBROOKE CASTLE" SRX.17540. JOB N°2.

ADDITIONAL STIFFENING UNDER CAR DECK.

SCALE  $\frac{1}{4}" = 1 \text{ FOOT}$ .

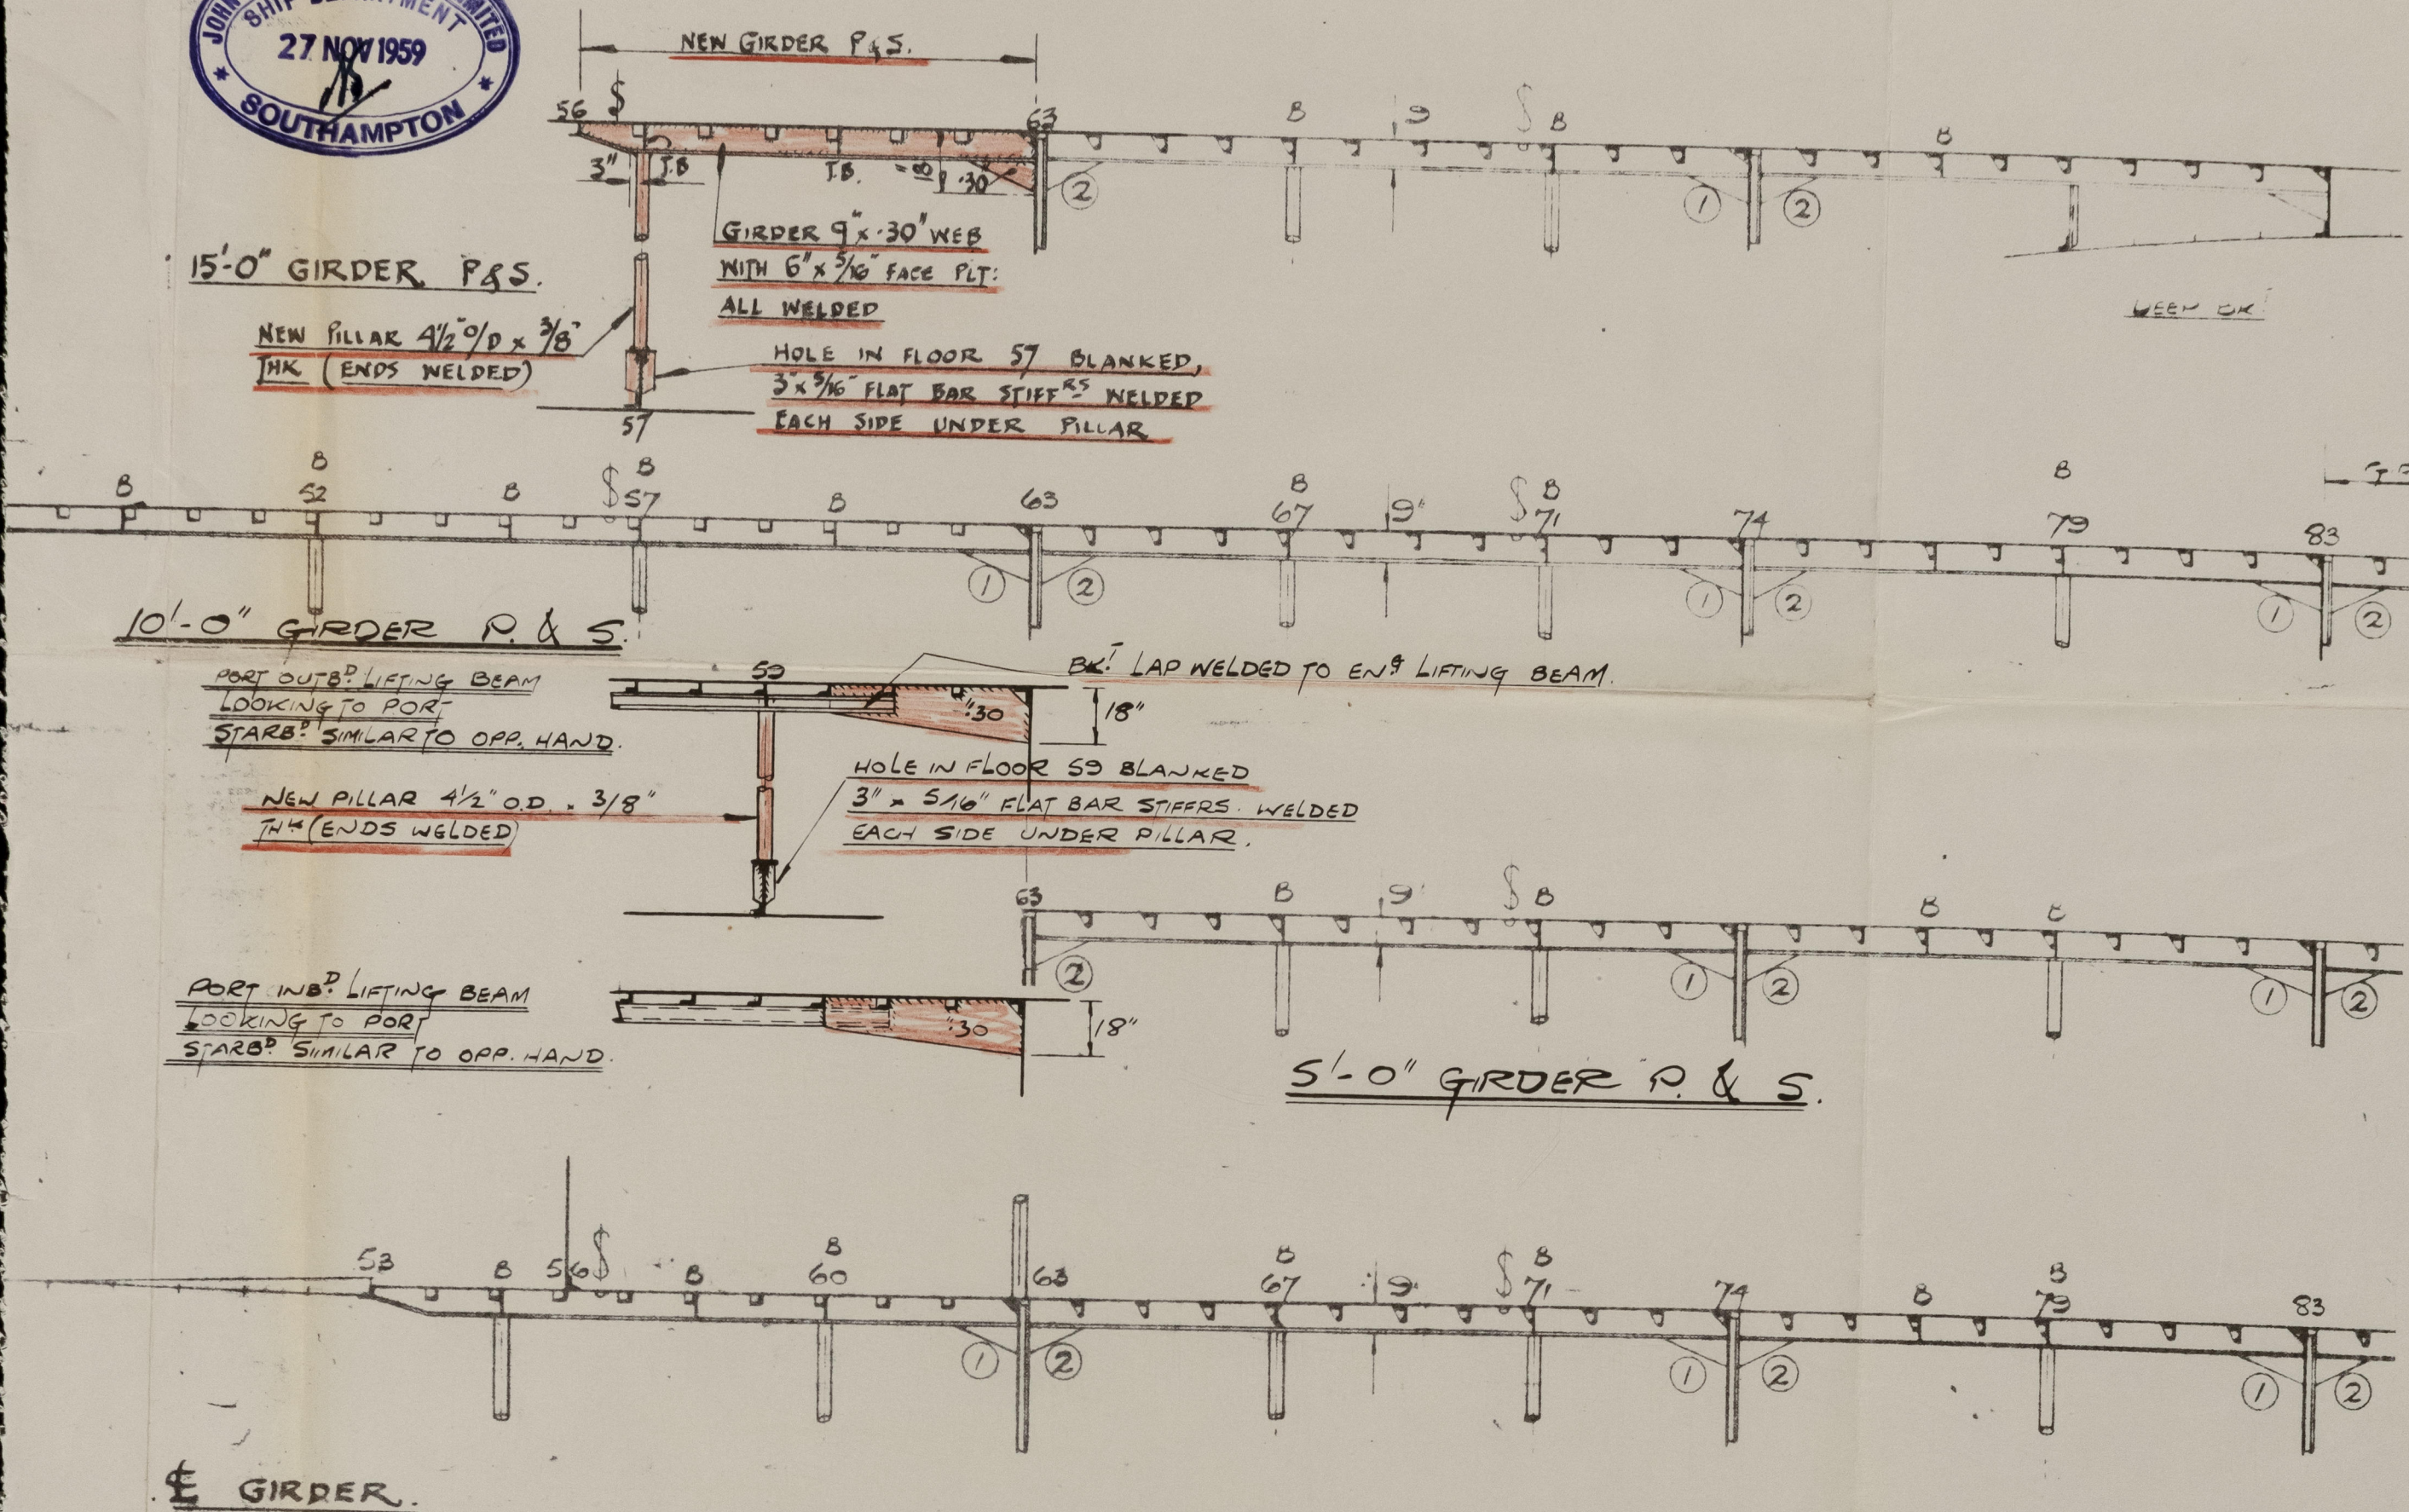

013881-013883-0003

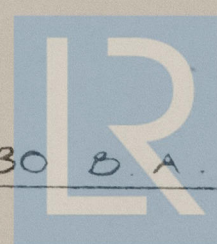

© 2021

Lloyd's Register Foundation



NAME	M.V. Canisbrooke Castle	
SOUTHAMPTON REPORT No.	25860	
PLAN	Additional Stiffening under Car Deck	
BUILDERS	—	
YARD No.	—	12/59.

SS/MS	
TO ADD	Rpt. 1-8
SUBJ	



© 2021

Lloyd's Register  
Foundation

013881-013883-0003