



S/S 'COMMODITY'

ELEVATION OF STB. SIDE LOOKING TO PORT.

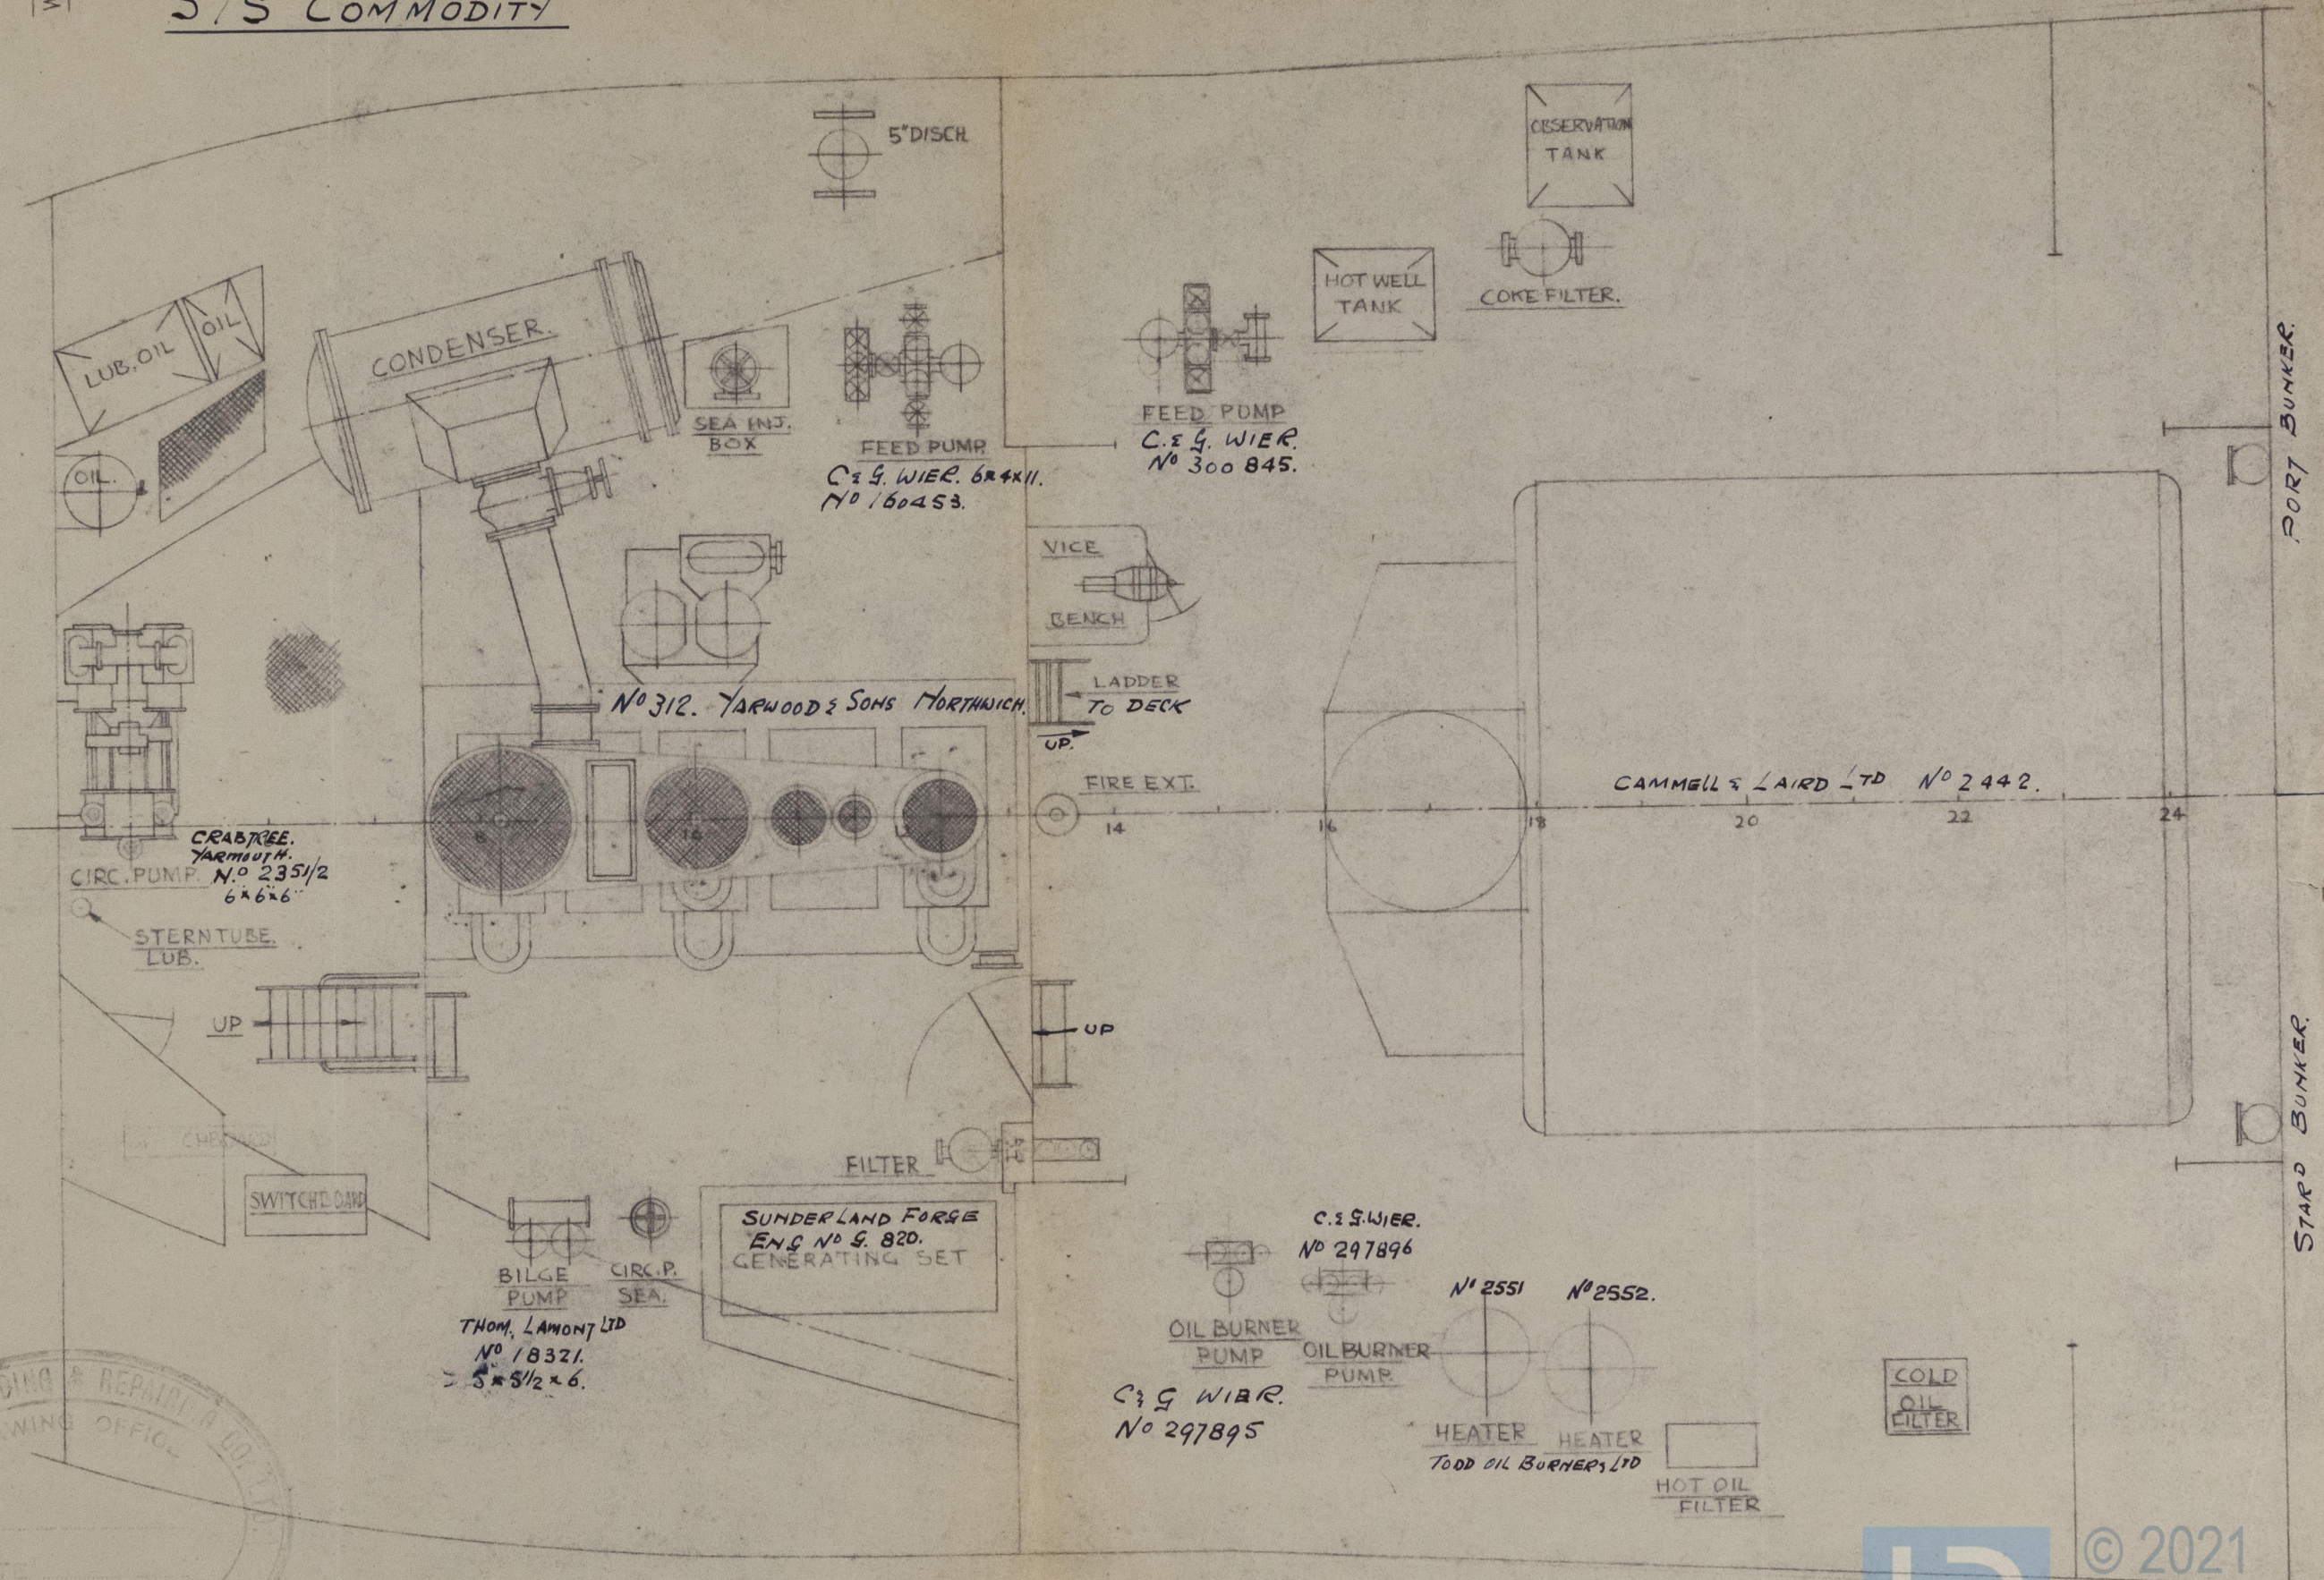

PLAN VIEW OF ENG. ROOM.

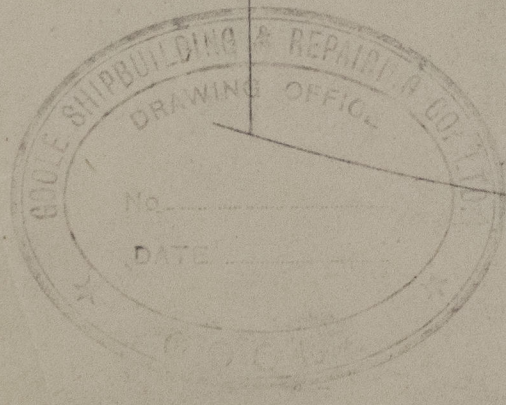

© 2021

Lloyd's Register Foundation

013890-013899-0022

'COMMODITY'

ENG. RM. ARRANGEMENTS.

"AS FITTED"

HUL. RPT. NO. 63524.



© 2021

Lloyd's Register
Foundation

013890 - 013899 - 0022