
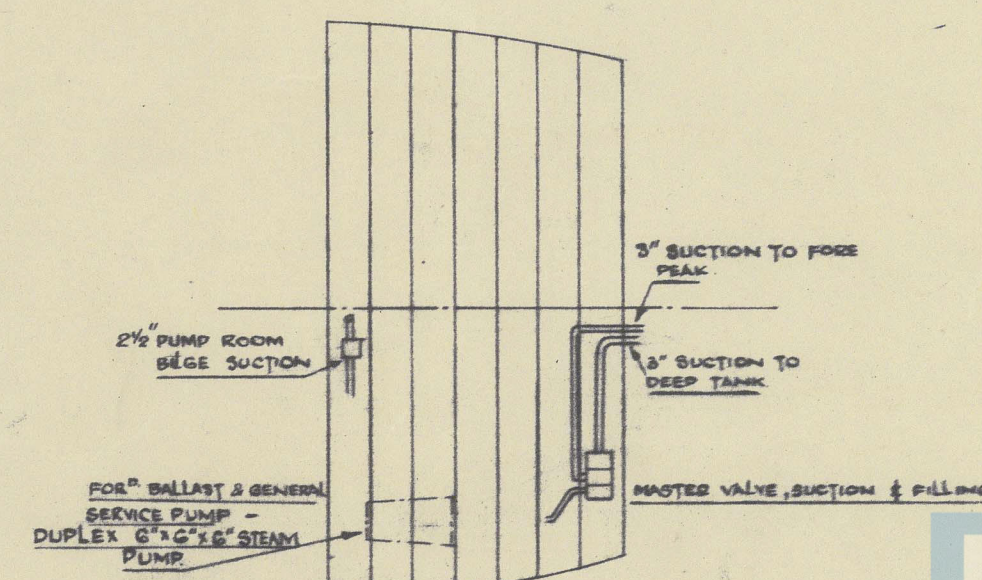
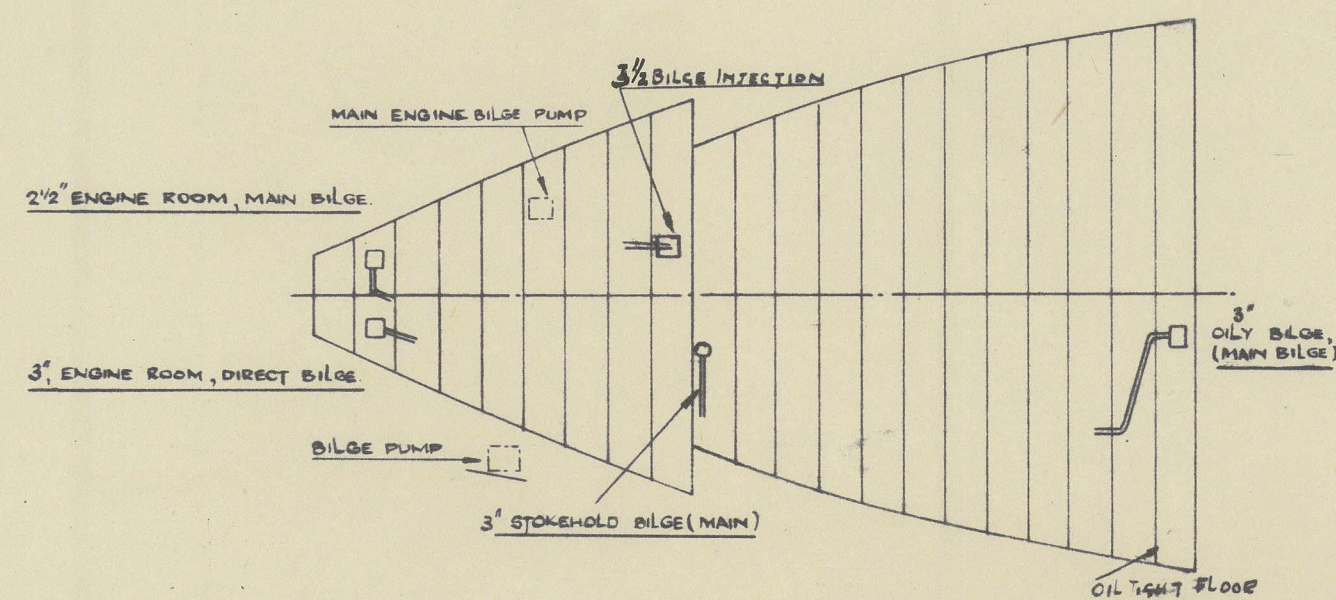


S/S COMMODITY

PUMPING PLAN.

Scale 1/8" = 1 Foot

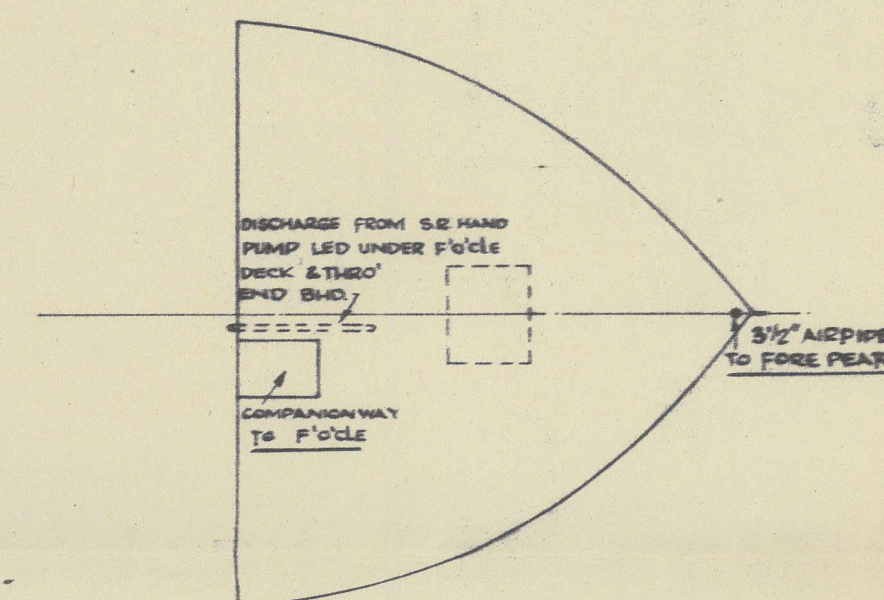

As found
h.c. 1/5/57

'COMMODITY'

PUMPING PLAN "AS FITTED"

Nul. Rpt. No. 63524.



© 2021

Lloyd's Register
Foundation

013890-013899-0023