



141 P 25
utsidan visad

bak

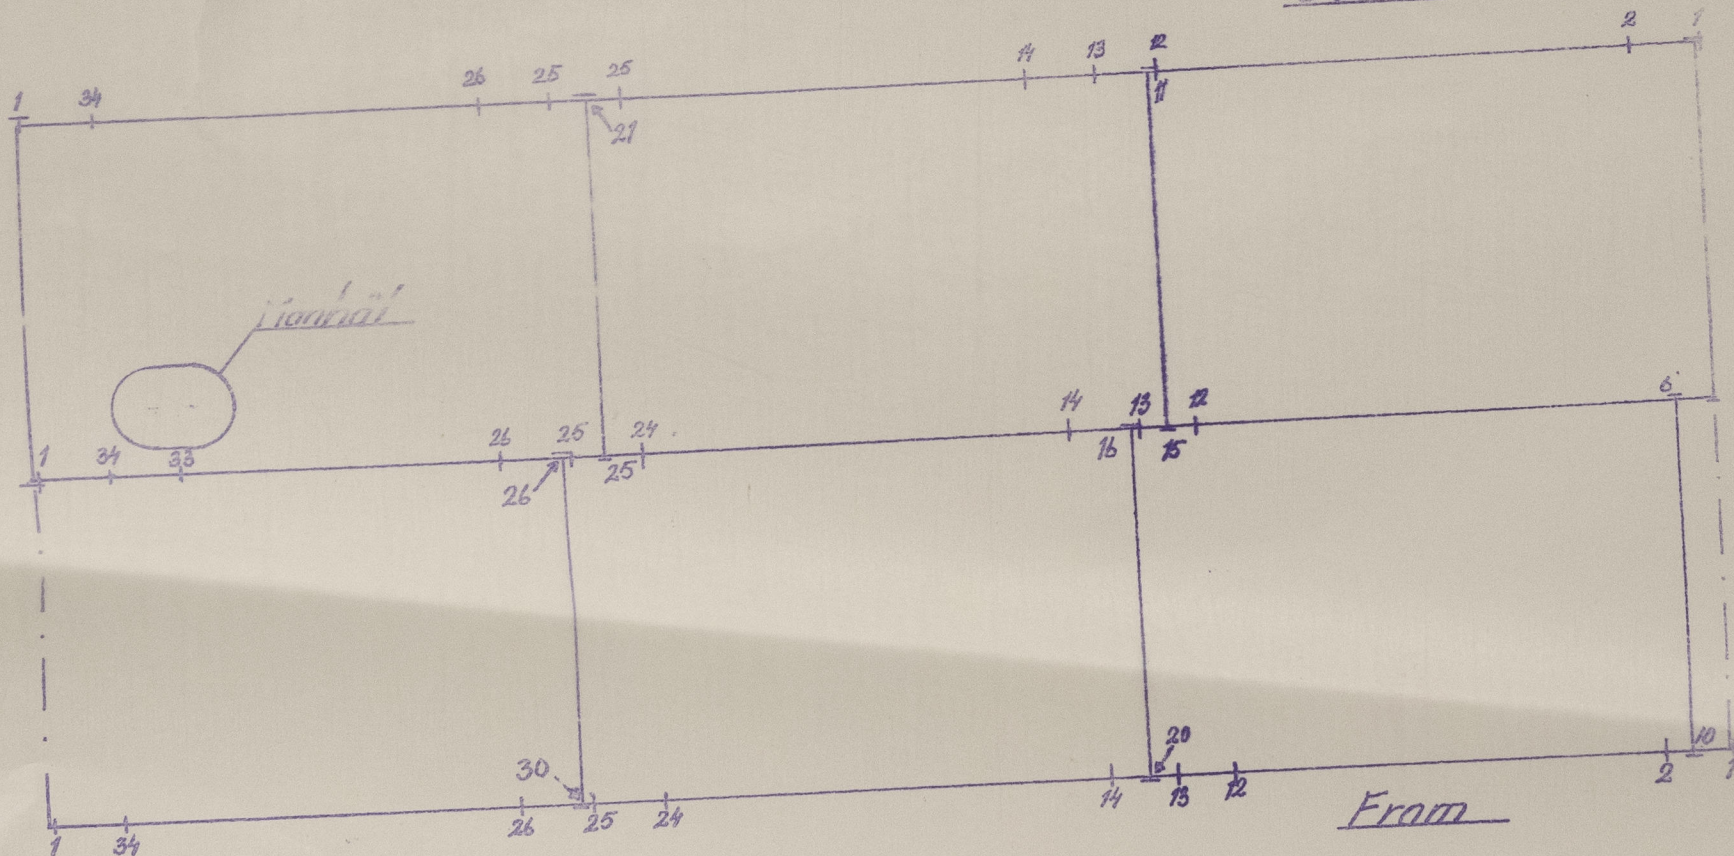

TEKNISKA RÖNTGECENTRALEN AB

Nr 2790

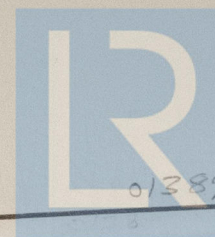

© 2021

Lloyd's Register
Foundation

013890-013899-0104