

## JAN 1998

COOK, WELTON & GEMMELL LTD  
SHIPBUILDERS.  
BEVERLEY



LENGTH OF RAISED QUARTER DECK :- 92' 9"

AS PREVIOUSLY  
APPROVED


N.8 SHEARSTRAKE BUTTS WELDED ALL FORE & AFT

FLOORS TO FRAME, RIVETS SPACED 6 DIAMS APART.  
ENGINE FLOORS & BOILER BEARERS RIVETS SPACED 5 DIAMS APART.  
RIVETS IN CLOSE FRAMING FOR<sup>d</sup> OF  $\frac{3}{4}$  L THRO' FLOORS.  
A SHELL PLATING IN WAY OF GARBORD & THE TWO ADJOINING.  
STAKES TO BE SPACED AT 4" CENTRES.

<u>LLOYDS NUMERALS</u>	
$L \times D$	2848.00
$D$	16.00
$L \times (B+D)$	8277.00
$B \times D$	46.50
$\frac{1}{2}D$	11.12
$\frac{1}{4}B$	5.83
$\frac{1}{4}D$	14.42


EQUIPMENT

1 STOCKLESS ANCHOR	-----	1 1/2 CENTS
1 STOCKLESS ANCHOR	-----	13 CENTS
1 RODGERS ANCHOR	-----	3 1/2 CENTS (EX STOCK)
165 FATHOMS 1/2" STUD LINK CABLE		
60 FATHOMS 6" WARP		OR ALTERNATIVELY 2-60 FATHOMS
60 FATHOMS 6" HANSEK		OF 4" COMBINATION WIRE
		BREAKING STRAIN OF NOT LESS
		THAN 8.9 TONS (AS PREVIOUSLY APPROVED)

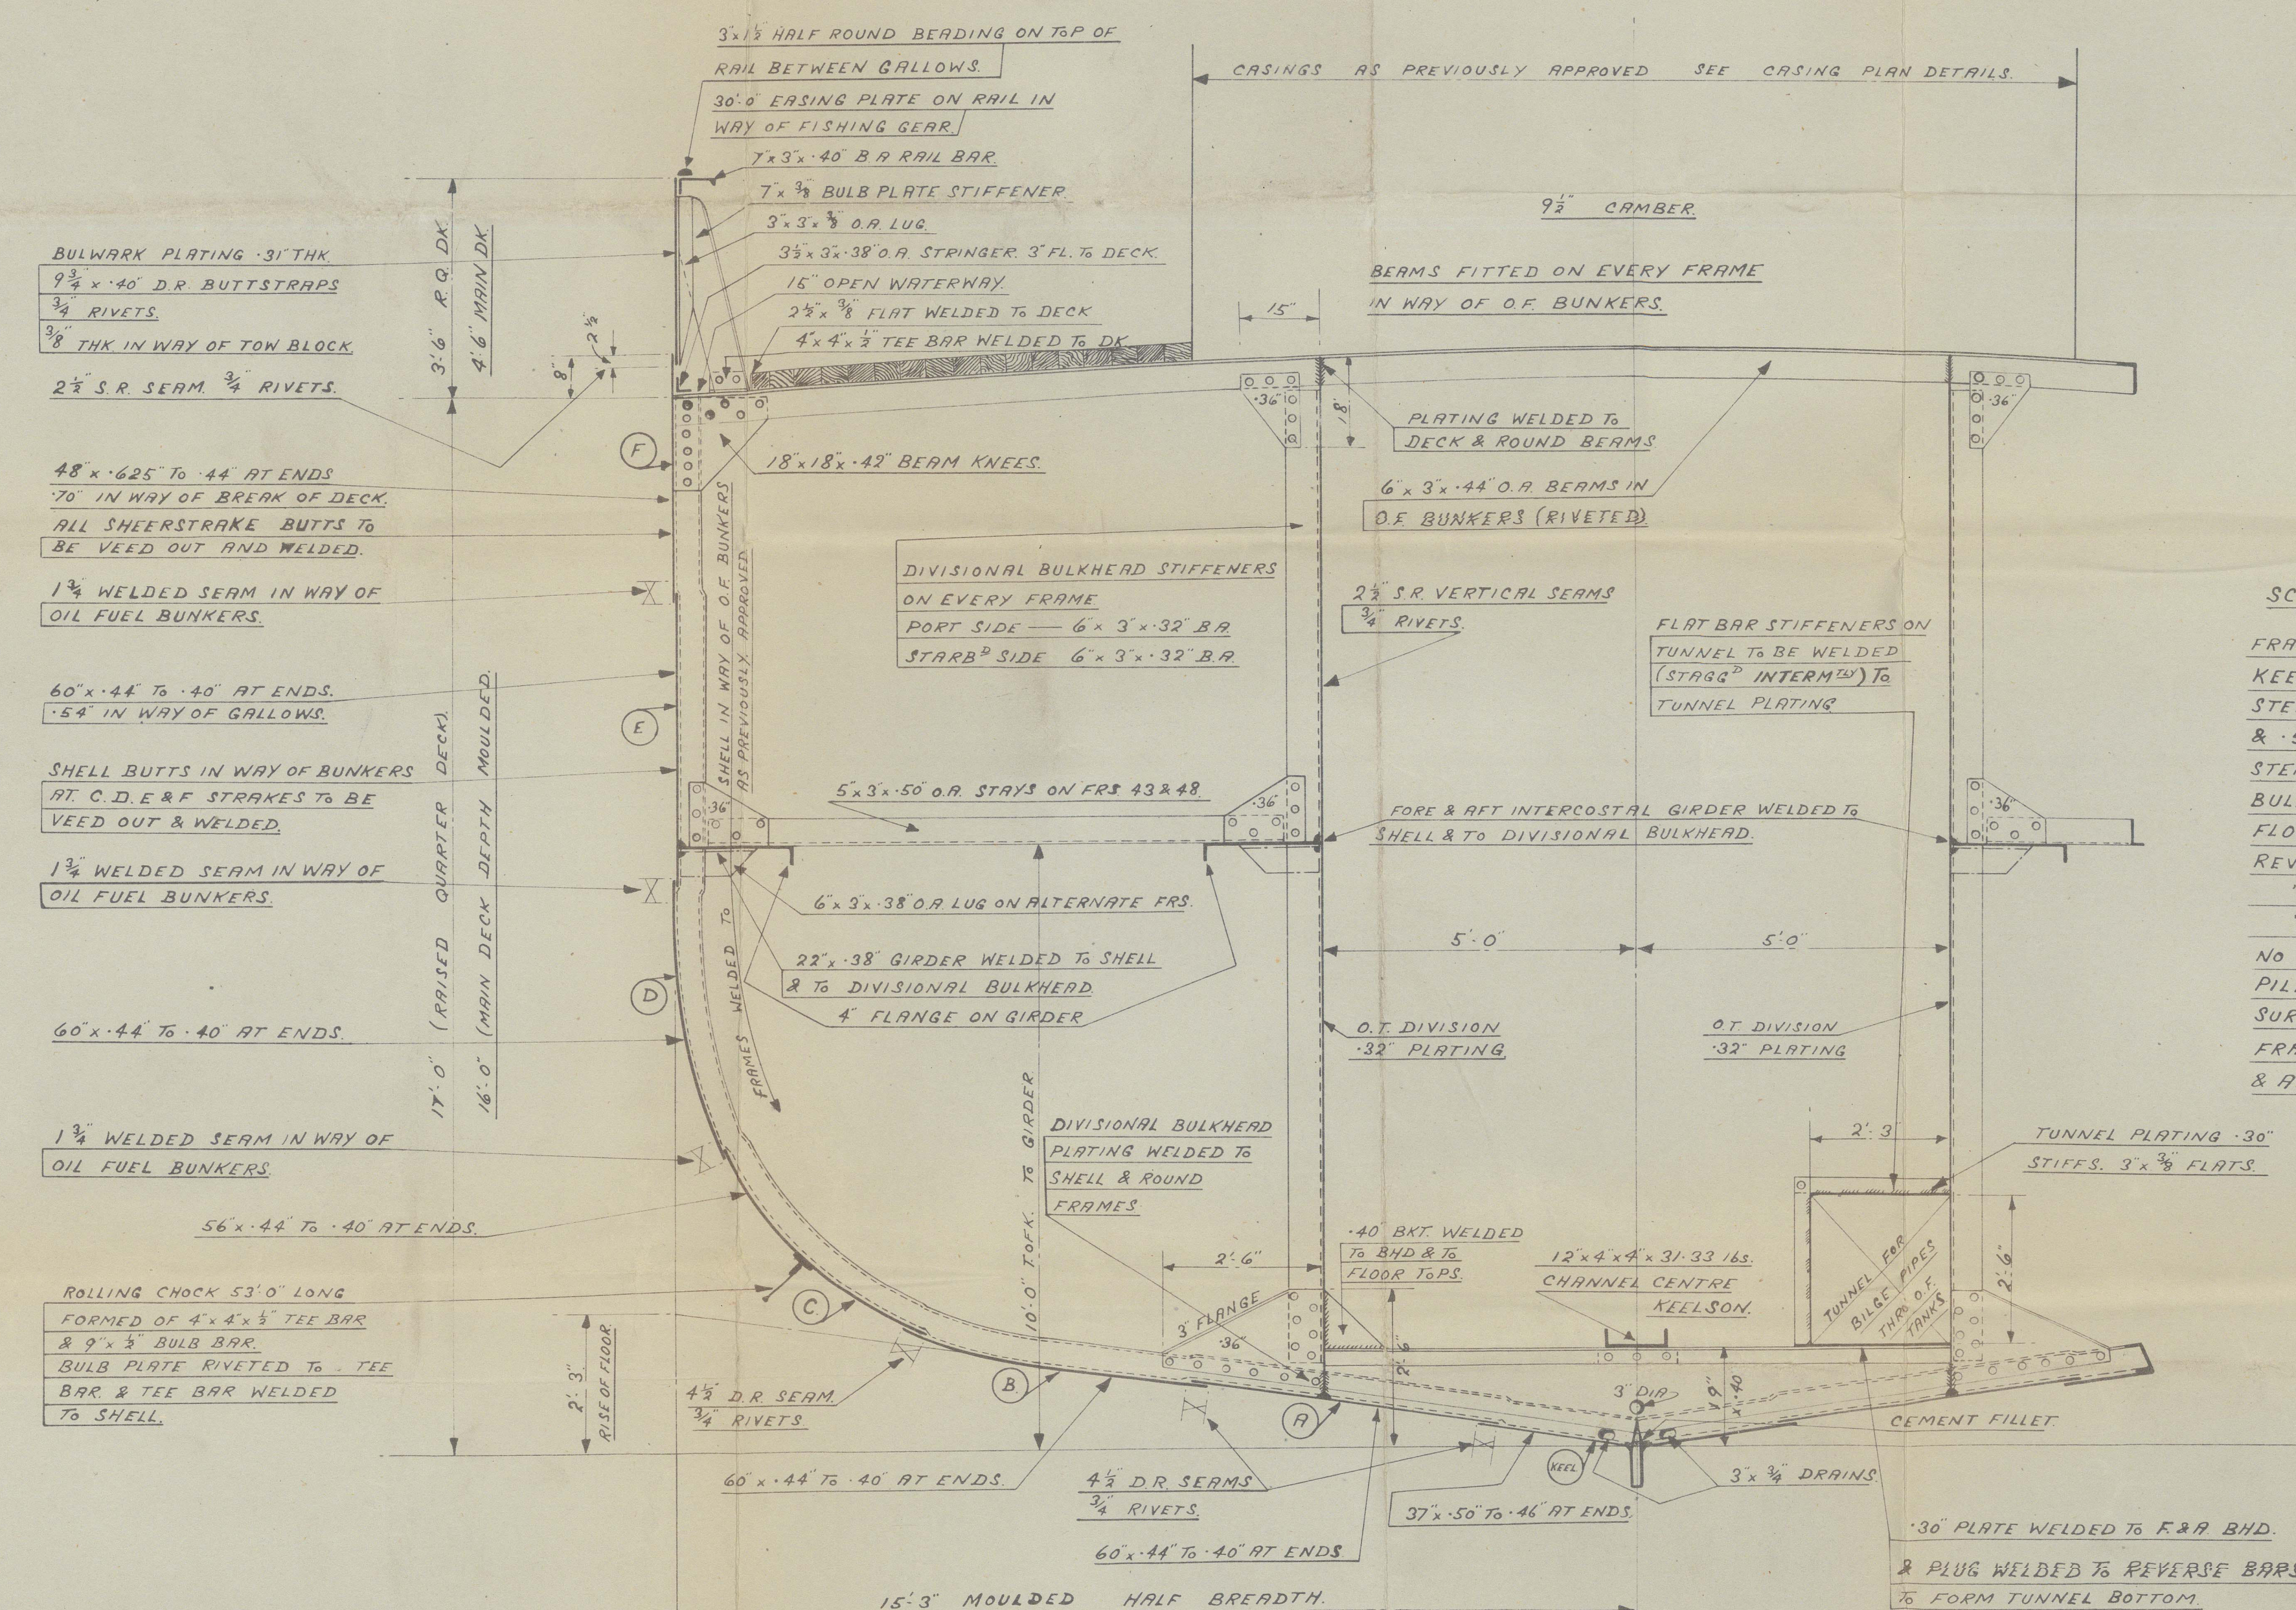

NOTE :- ALL SHELL CHAFING BEADS  
TO BE WELDED ON.

SECTION THRO' O.F. BUNKERS.  
LOOKING RFT.

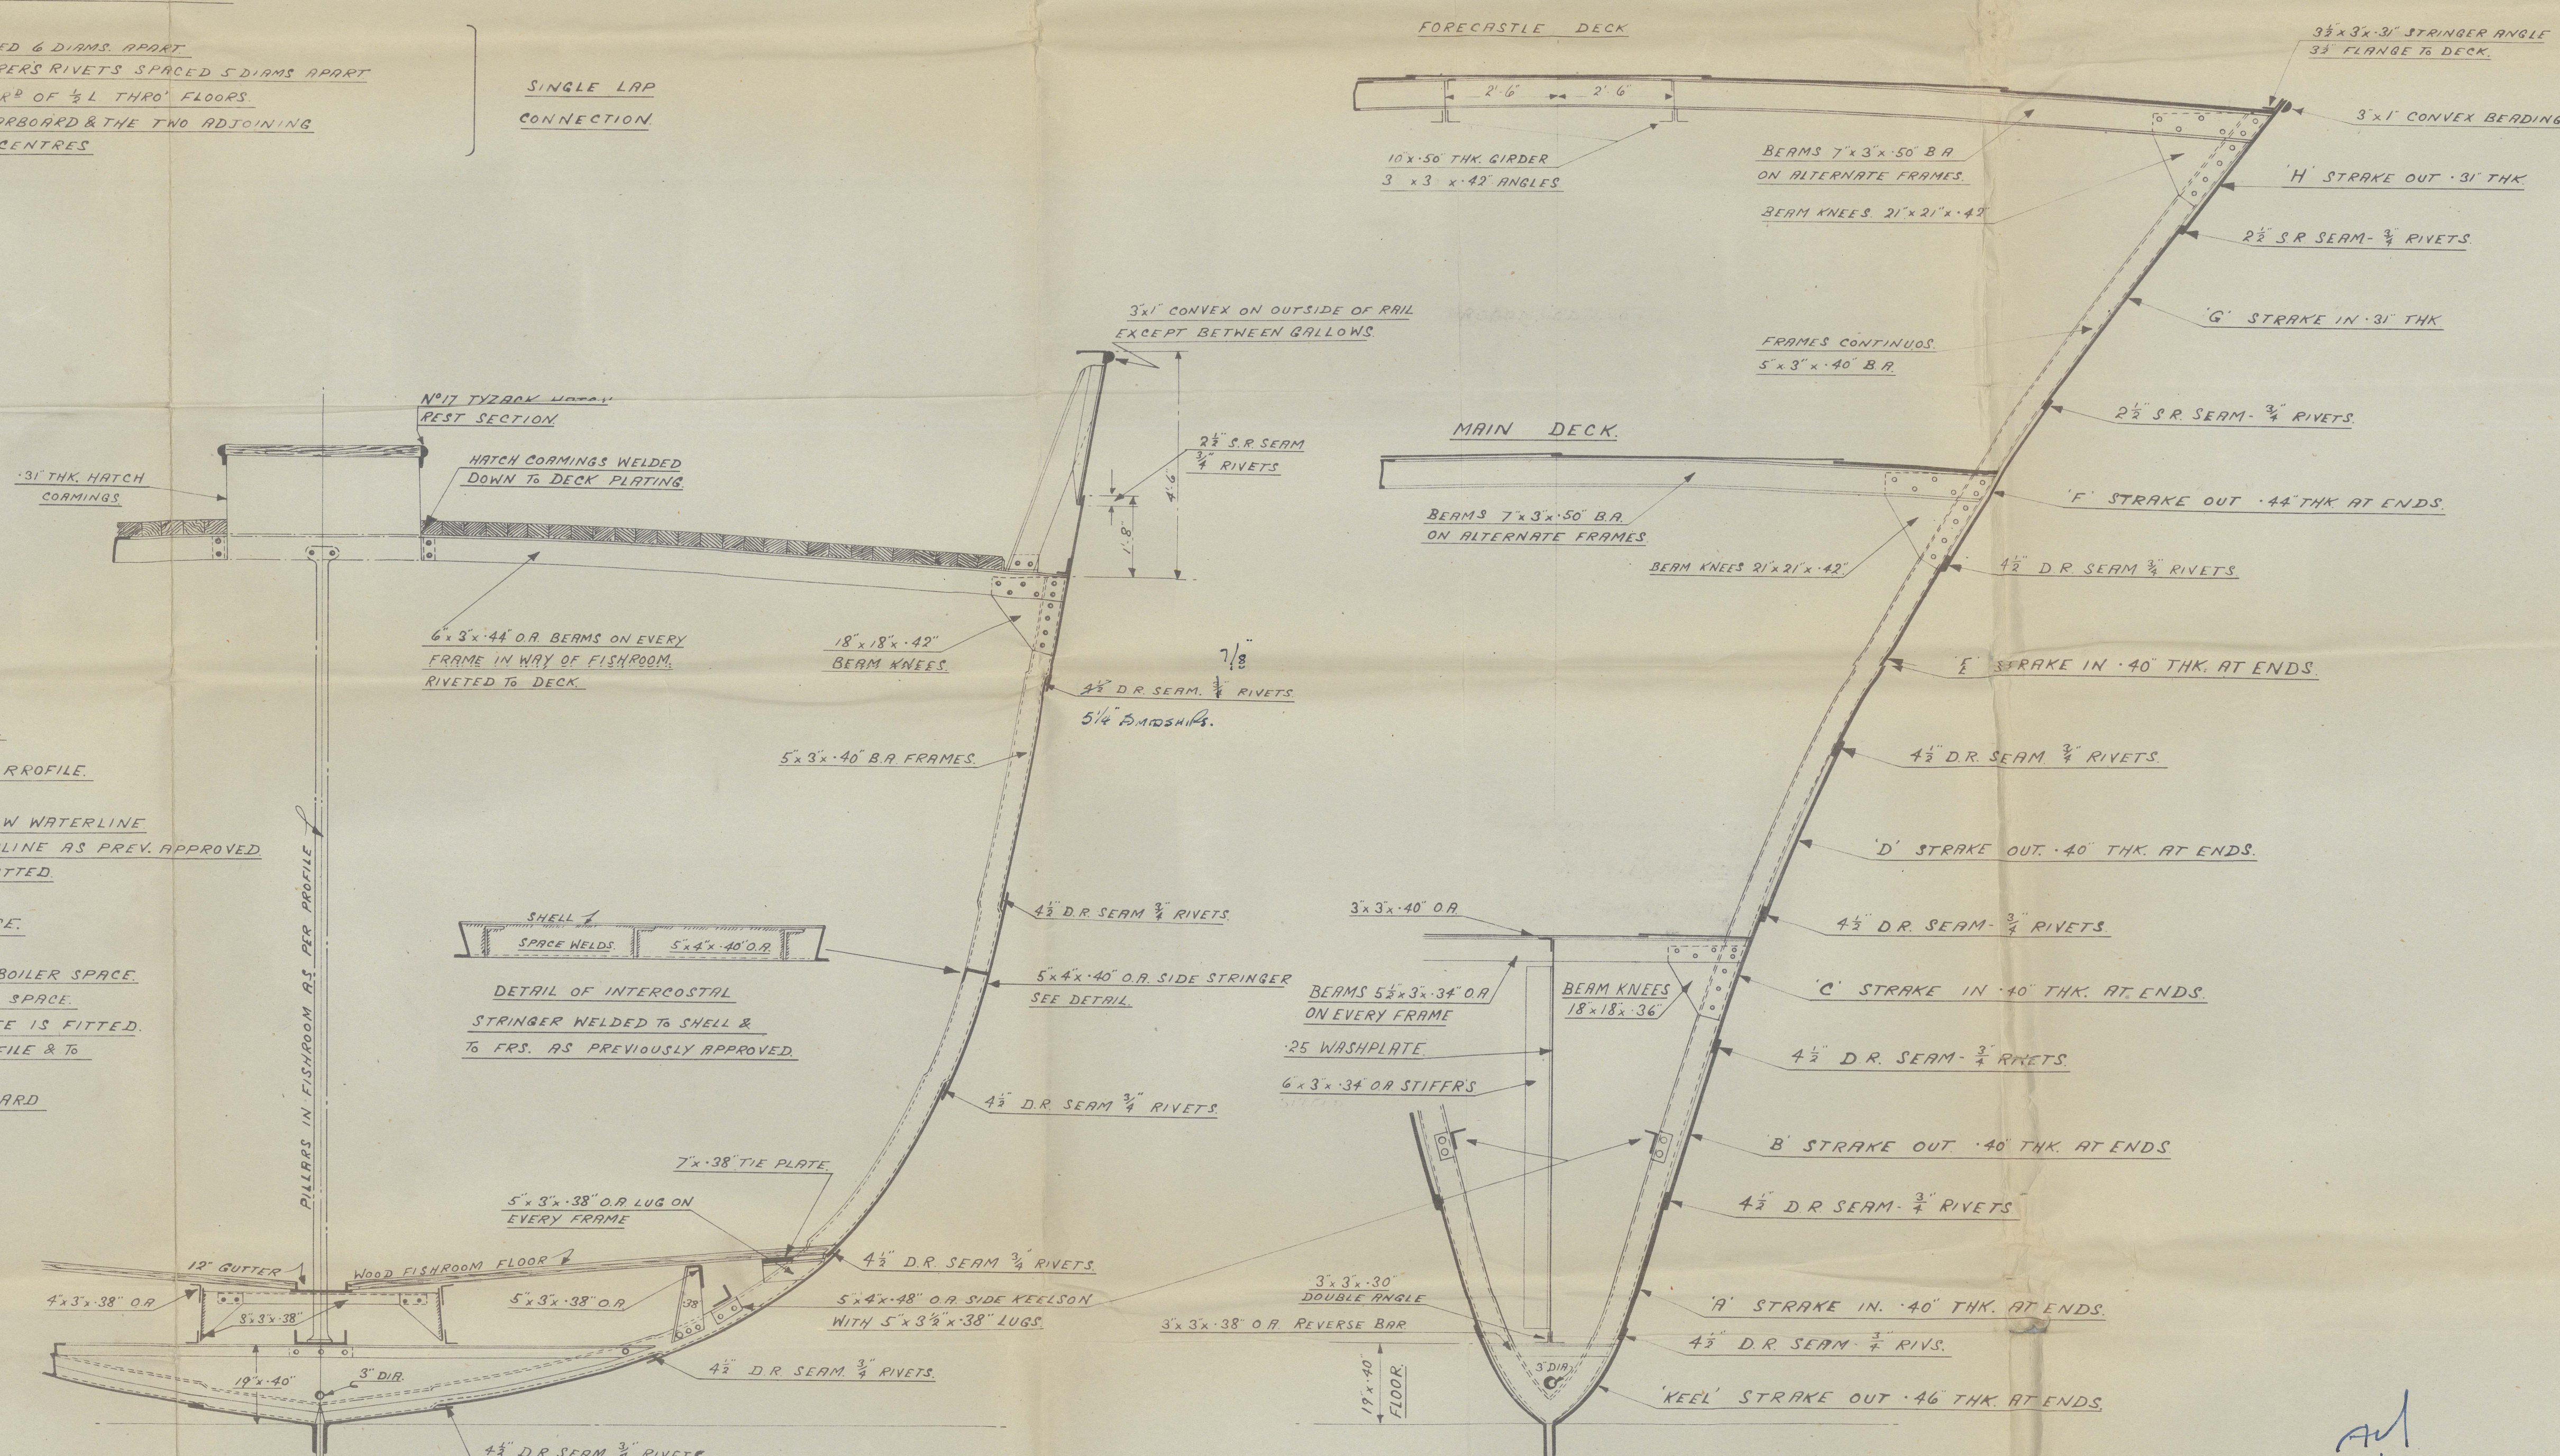

SECTION THRO' FISHROOM.  
LOOKING AFT.

SECTION THRO' FORECASTLE  
LOOKING AFT.

Ad  
13.1.44



HULL


"PRINCE CHARLES" ★

Cook, Welton & Gemmell, Yard No. 804.


Structural Sections.

First Entry Report No. 56014

RECORDS DEPT.,  
LONDON

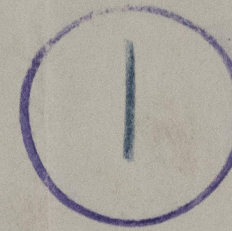

013991 - 013996 - 0137

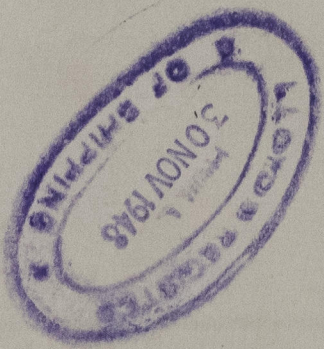

0137



© 2021

Lloyd's Register  
Foundation