


01344-014 003-000 Lloyd's Register Foundation

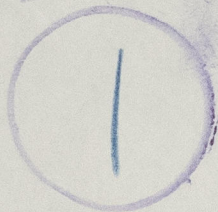


SHIPS DEPT  
LONDON



LONDON COPY

*Awata Maru*  
*Midship Section*

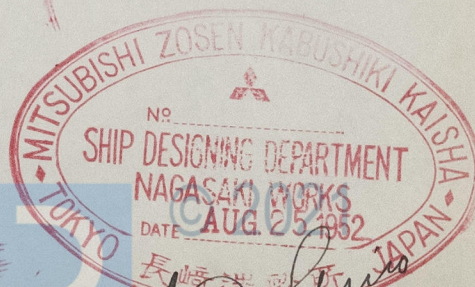

Lloyd's Register  
Foundation

013997-014003-0001