

This plan is in accordance with the approved plan.

44/92
H. H. H.

NO. 1428
AWATA-MARU

CONSTRUCTION
PROFILE &
DECK PLAN
SHEET II
(FINISHED PLAN)


1400' x 190' x 10'5"
SHEET 1100 x 1000 L.R.
HULL, DECK, MAST, FUNNEL
AND SUPERSTRUCTURE
DRAWN BY
J. H. H.
CHECKED BY
J. H. H.
DATE
1428

MS DEPT
LONDON

3

LONDON COPY

Awata Maru
Const. Prof. & Plan
(S11)

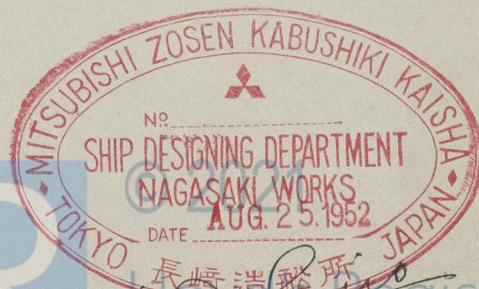

013947 011003 2003