

— Nos 1312.13. —


# MIDSHIP SECTION.

— STEEL SCREW TUGS. —

— DIMENSIONS: 110'-0" B.P. x 27'-6" MLD. x 13'-0" MLD. —

— TO CLASS 100A.I. FOR TOWING SERVICES. —

— SCALE  $\frac{1}{2}$ " = 1 FOOT. —

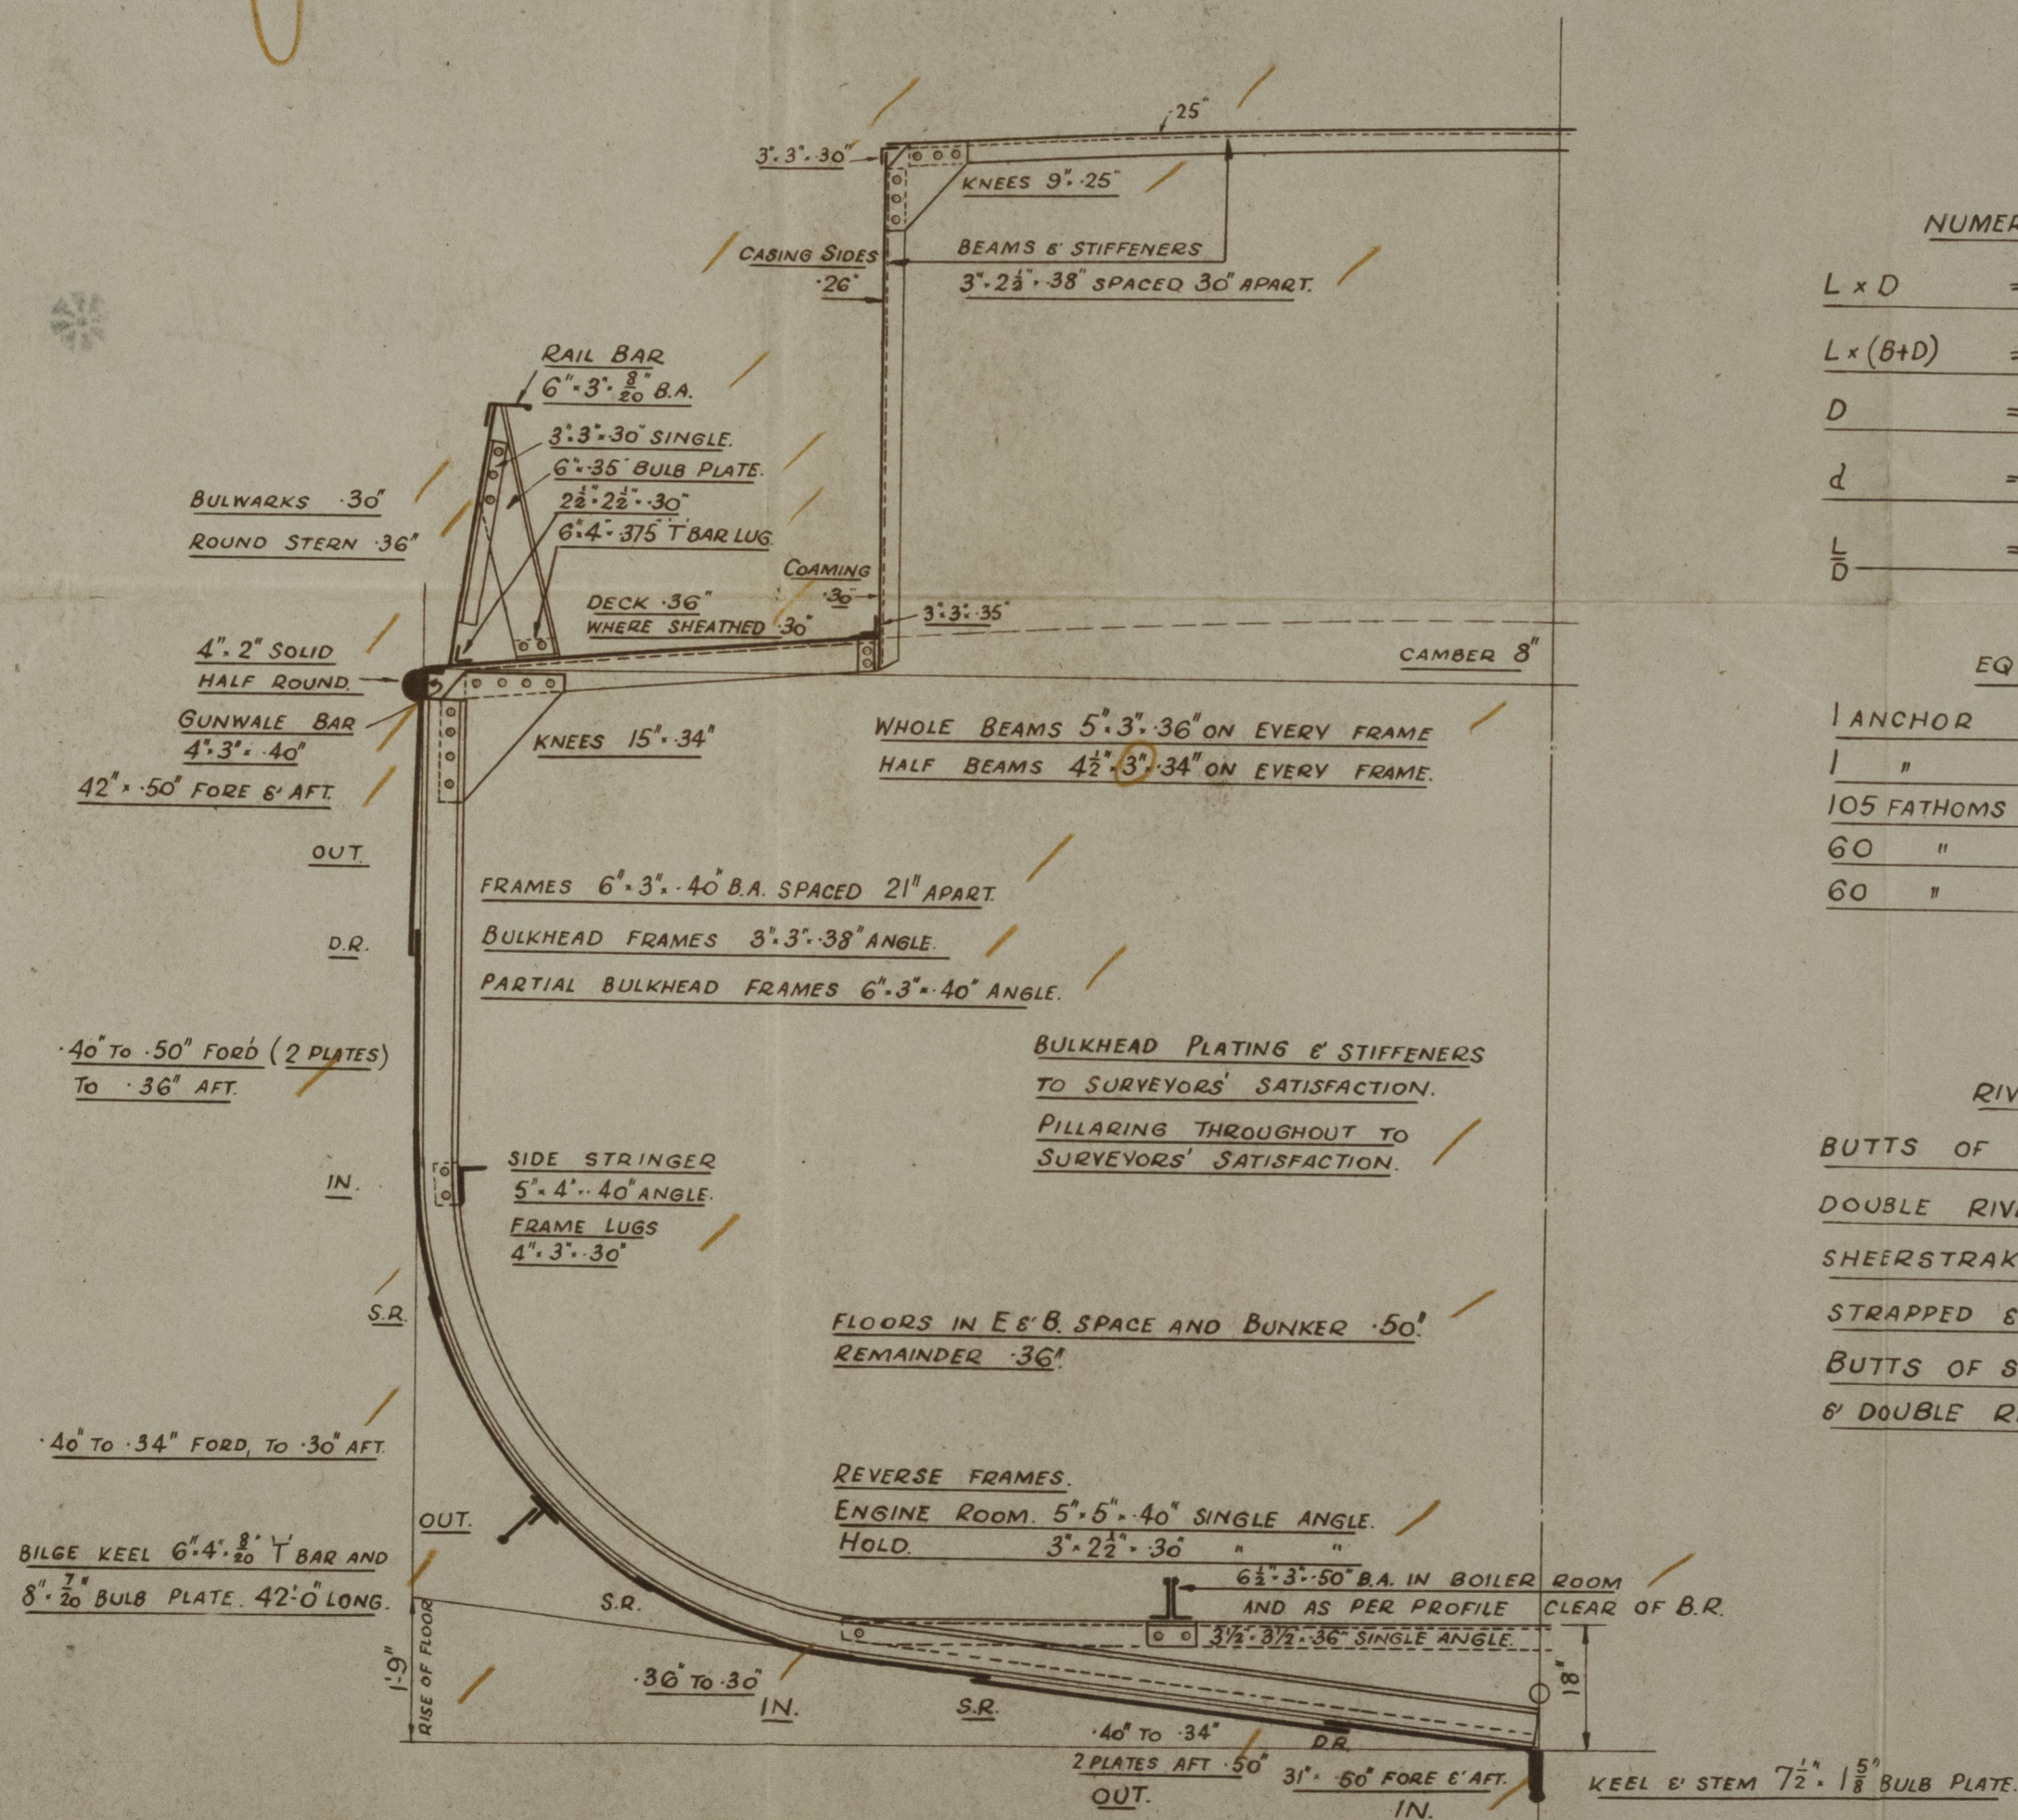

## NUMERALS.

|                  |   |       |
|------------------|---|-------|
| $L \times D$     | = | 1430. |
| $L \times (B+D)$ | = | 4455. |
| $D$              | = | 13.   |
| $d$              | = | 11.5. |
| $\frac{L}{D}$    | = | 8.46. |

## EQUIPMENT.

|             |                          |
|-------------|--------------------------|
| 1 ANCHOR    | 7 CWT. STOCKLESS.        |
| 1 "         | 6 1/4 CWT. "             |
| 105 FATHOMS | 1 1/16" STUD LINK CABLE. |
| 60 "        | 6" HAWSER.               |
| 60 "        | 4 1/2" WARP.             |

## RIVETING.

BUTTS OF SHELL PLATING OVERLAPPED & DOUBLE RIVETED, EXCEPT GARBOARD & SHEERSTRAKE WHICH ARE TO BE STRAPPED & DOUBLE RIVETED.  
BUTTS OF STRINGER PLATE OVERLAPPED & DOUBLE RIVETED.


SECTION THRO' BOILER ROOM.

ETL  
27.2.45



© 2021  
Lloyd's Register  
Foundation

014023-014031-0148

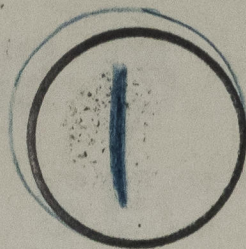

COCHRANE & SONS LTD  
YARD N<sup>o</sup> 1312413

## MIDSHIP SECTION

Danube VII



2021

Lloyd's Register  
Foundation

014023-014031-0148