



Nos 1312-13.

# PROFILE AND DECK.



— STEEL SCREW TUGS. —

— DIMENSIONS: 110'0" B.P. x 27'6" MLD. x 13'0" MLD. —

— TO CLASS 100A FOR TOWING SERVICES. —

— SCALE  $\frac{1}{4}$ " = 1 FOOT. —

BULKHEAD PLATING & STIFFENERS TO SURVEYORS' SATISFACTION.  
PILLARING THROUGHOUT TO SURVEYORS' SATISFACTION.

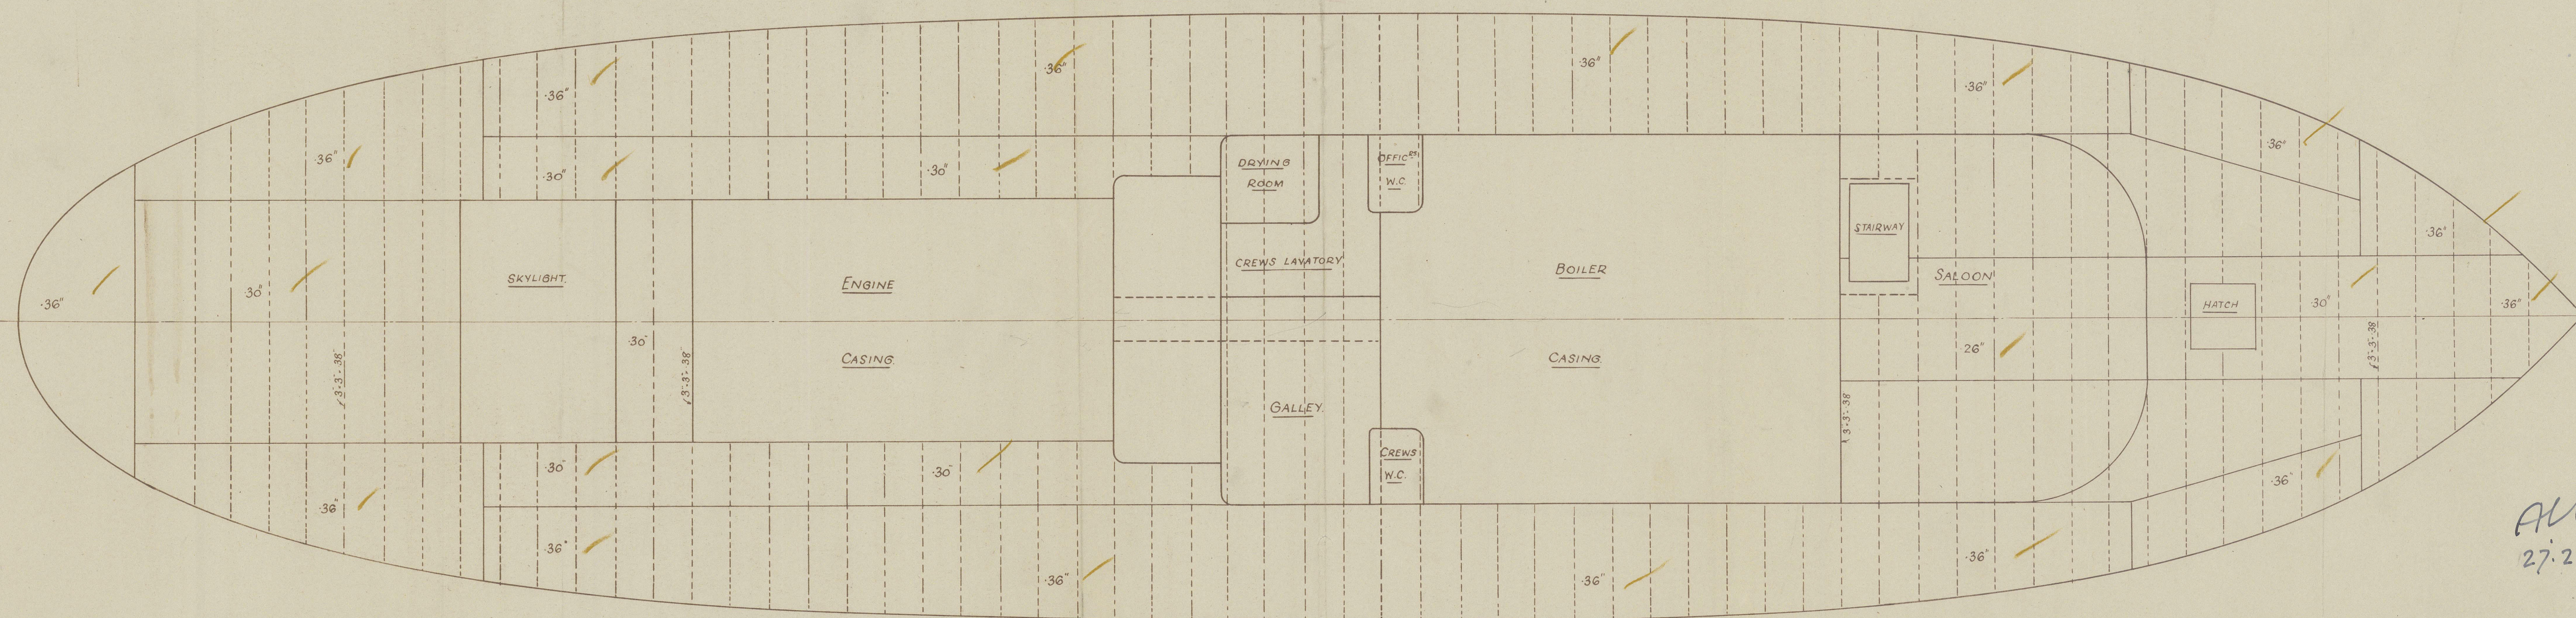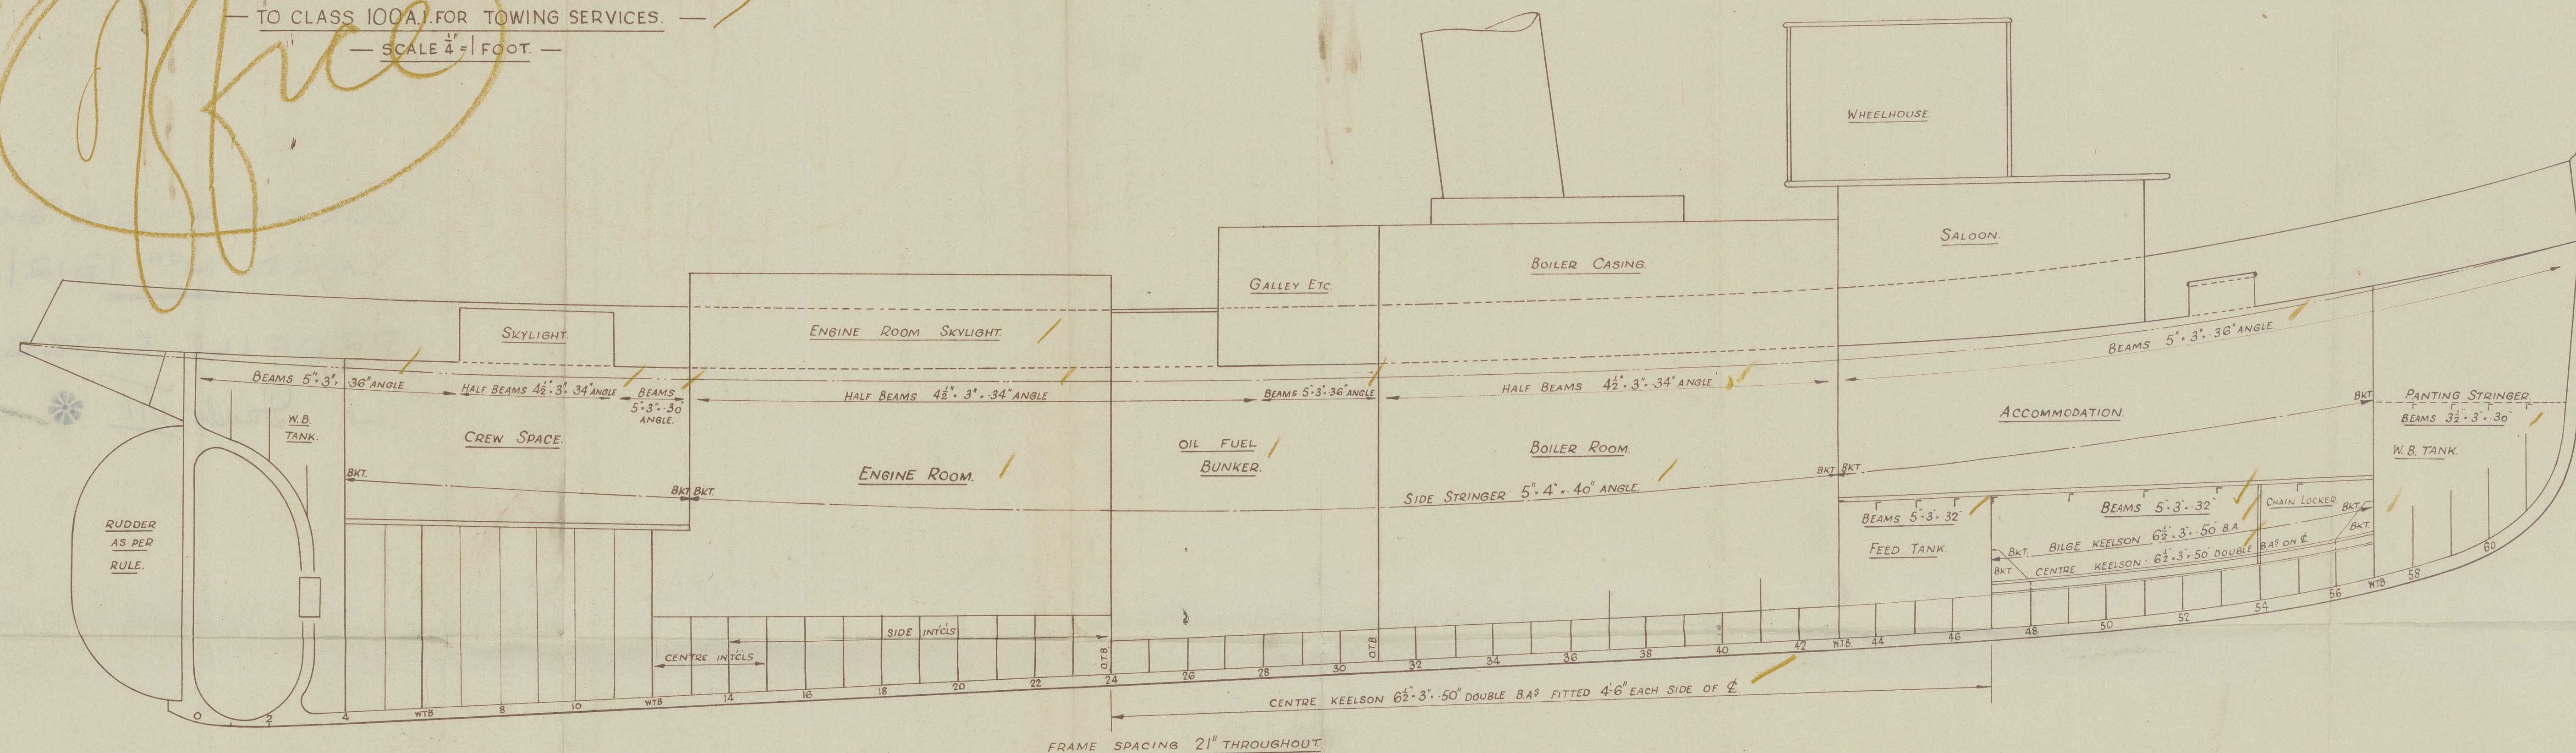

ALL  
27.2.45




© 2021  
Lloyd's Register  
Foundation



2

COCHRANE & SONS  
YARD NOS 1312/13.

## PROFILE & DECK

Danube VII 

© 2021

Lloyd's Register  
Foundation  
014023-014031-0149

014023-014031-0149