

JUAN PERON
No 1384.

MIDSHIP SECTION. (As fitted)

SCALE: 1/4" = ONE FOOT.

DIMENSIONS: LENGTH B.R. 635'-0" BREADTH MLD. 80'-0"
DEPTH MLD. TO UPPER DECK. 61'-0"
TO CLASS LLOYD'S 100 A1+ WITH FREEBOARD CARRYING "PETROLEUM IN BULK"
LONGITUDINAL FRAMING AT BOTTOM, DECK, AND TWEEN DECK SIDES.
"WHALING SERVICE" A SUITABLE NOTATION TO BE MADE REGARDING ELECTRIC WELDING.
STRENGTHENED FOR NAVIGATION IN ICE.
DRAUGHT SUMMER MLD. 54'-6"
STEM BAR 12" x 3/4"






LLOYD'S NUMERALS FOR SCANTLINGS.
LXD = 635 x 44-66 = 28,359
LX(D+D) = 635 x (80+44-66) = 79,159
L/D = 635/81 = 7.84

All Bulk And/or C. Channels And N.B.
All Bulk Plates And C.B.
Reinforced As Per Rules


PLAN BELOW FACTORY DECK

PLAN BELOW TANK DECK

O.T. TRANSVERSE BULKHEADS

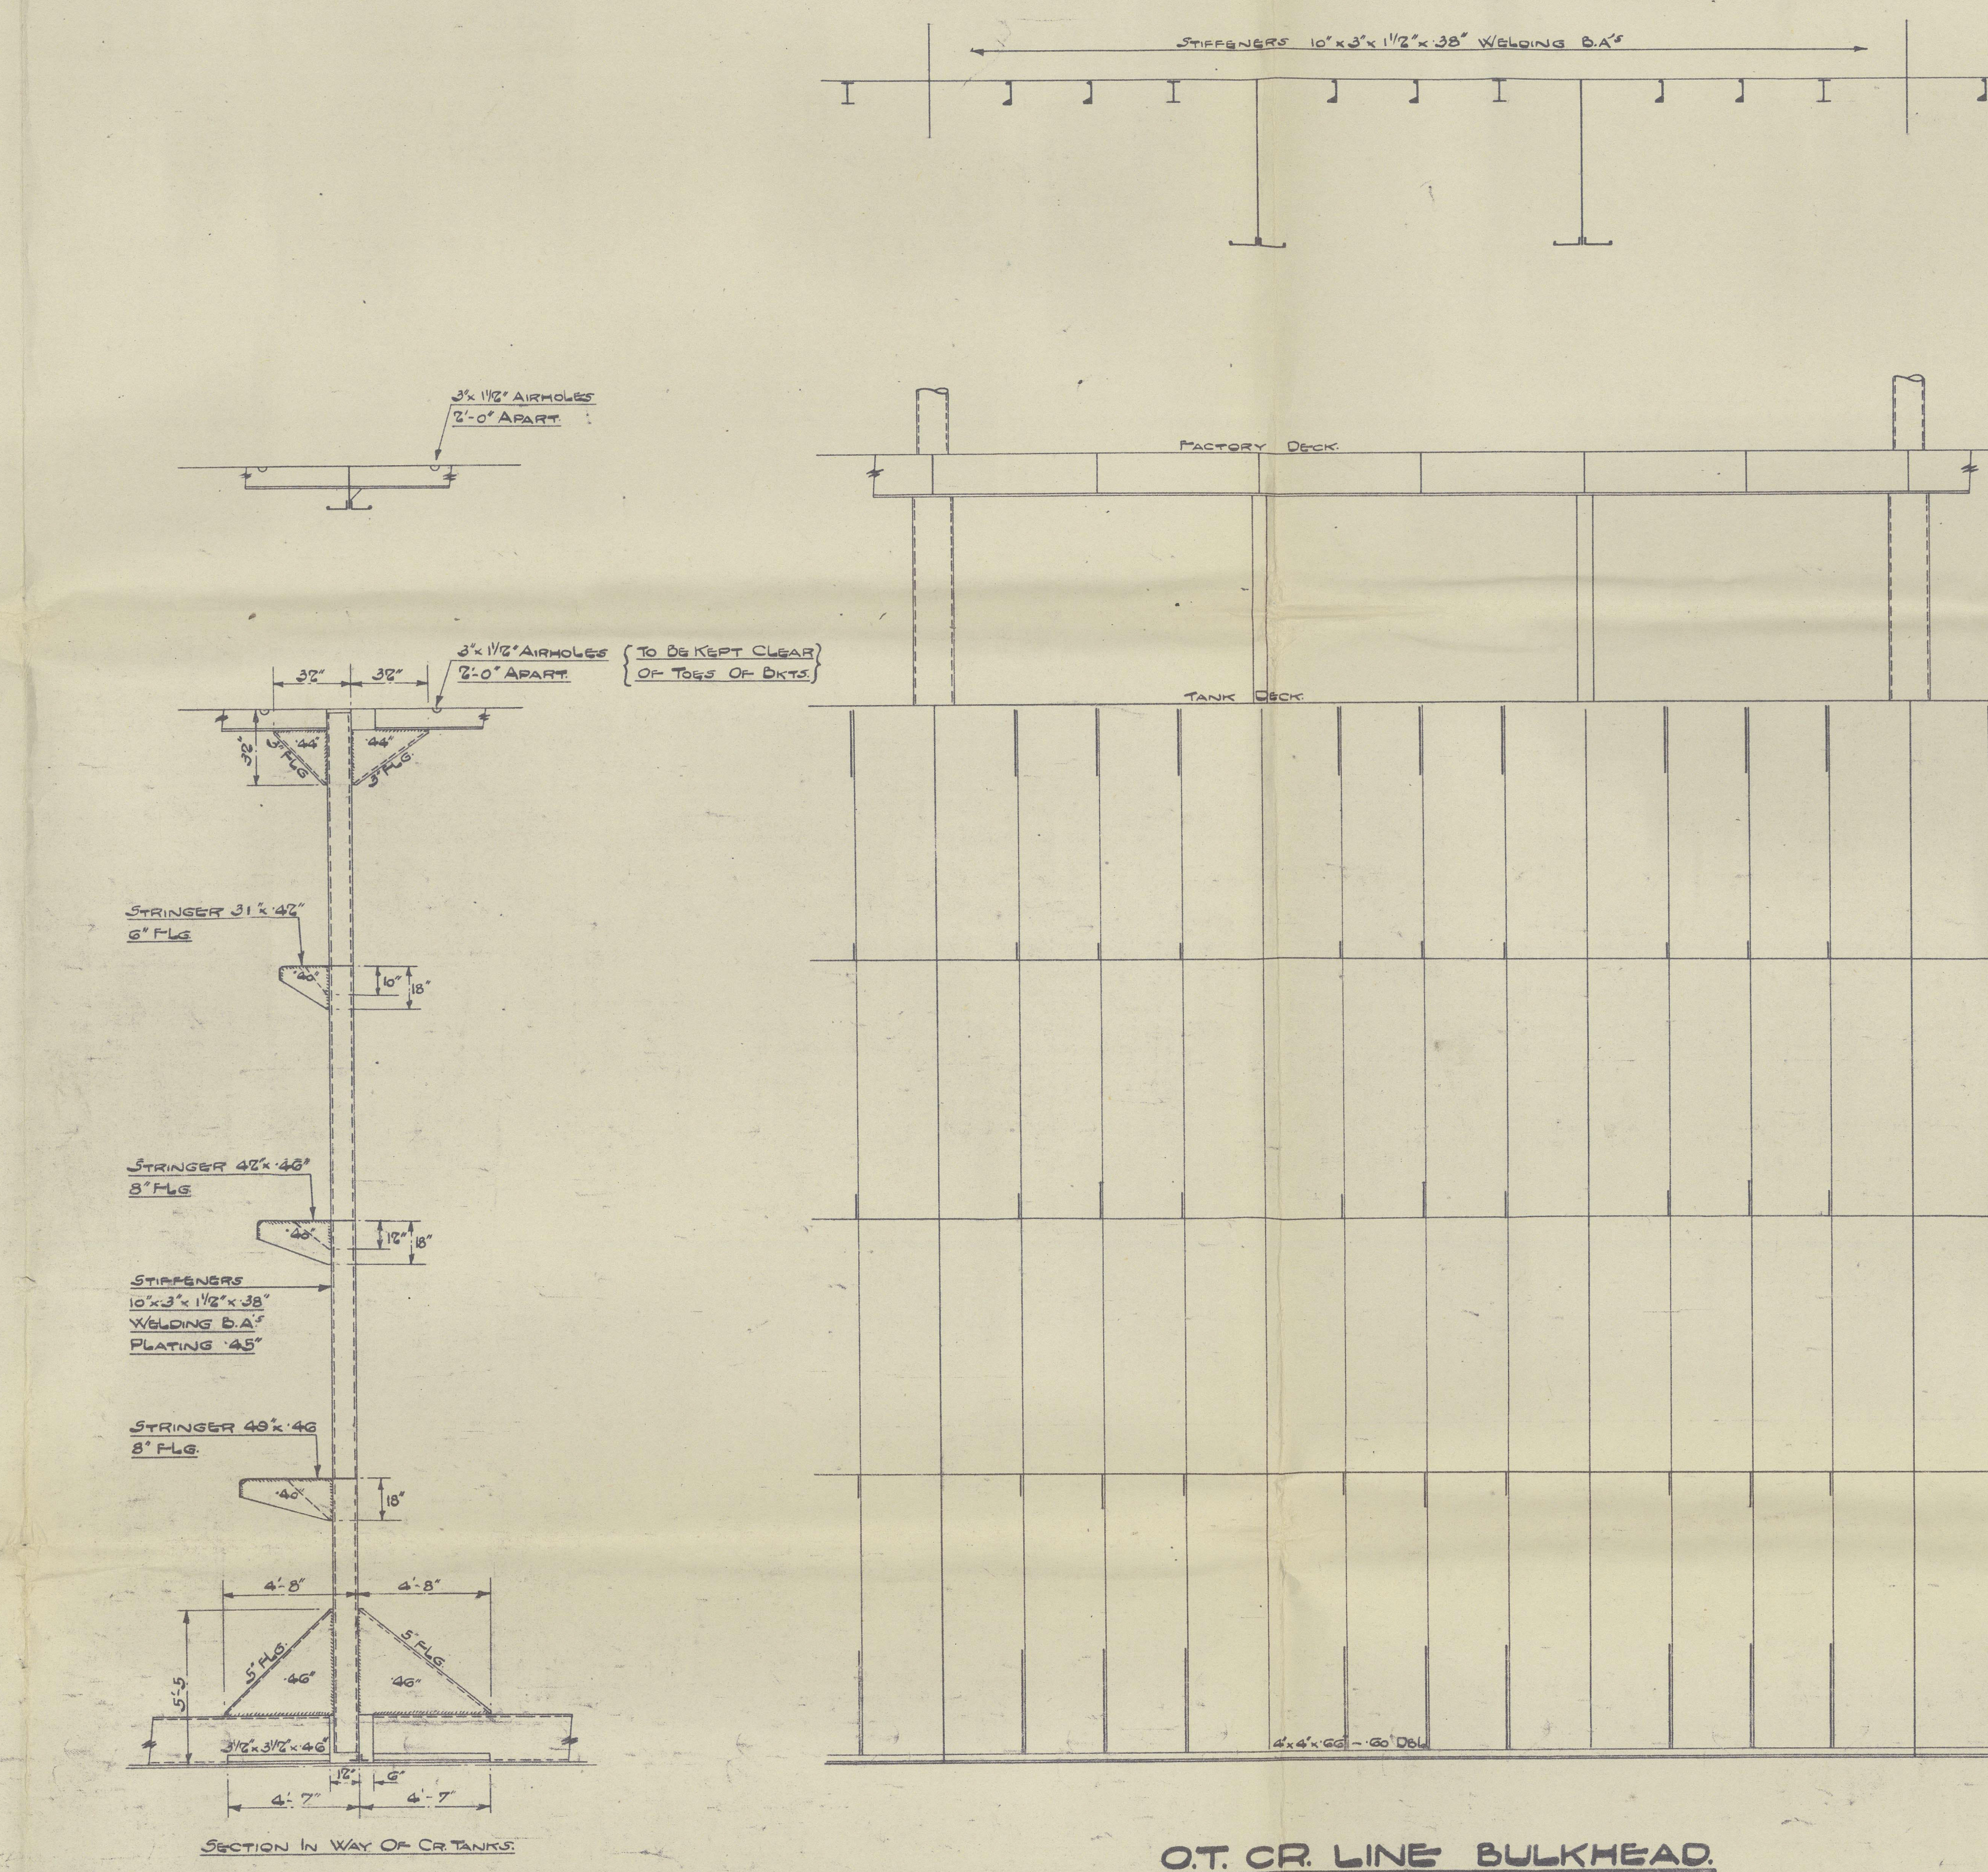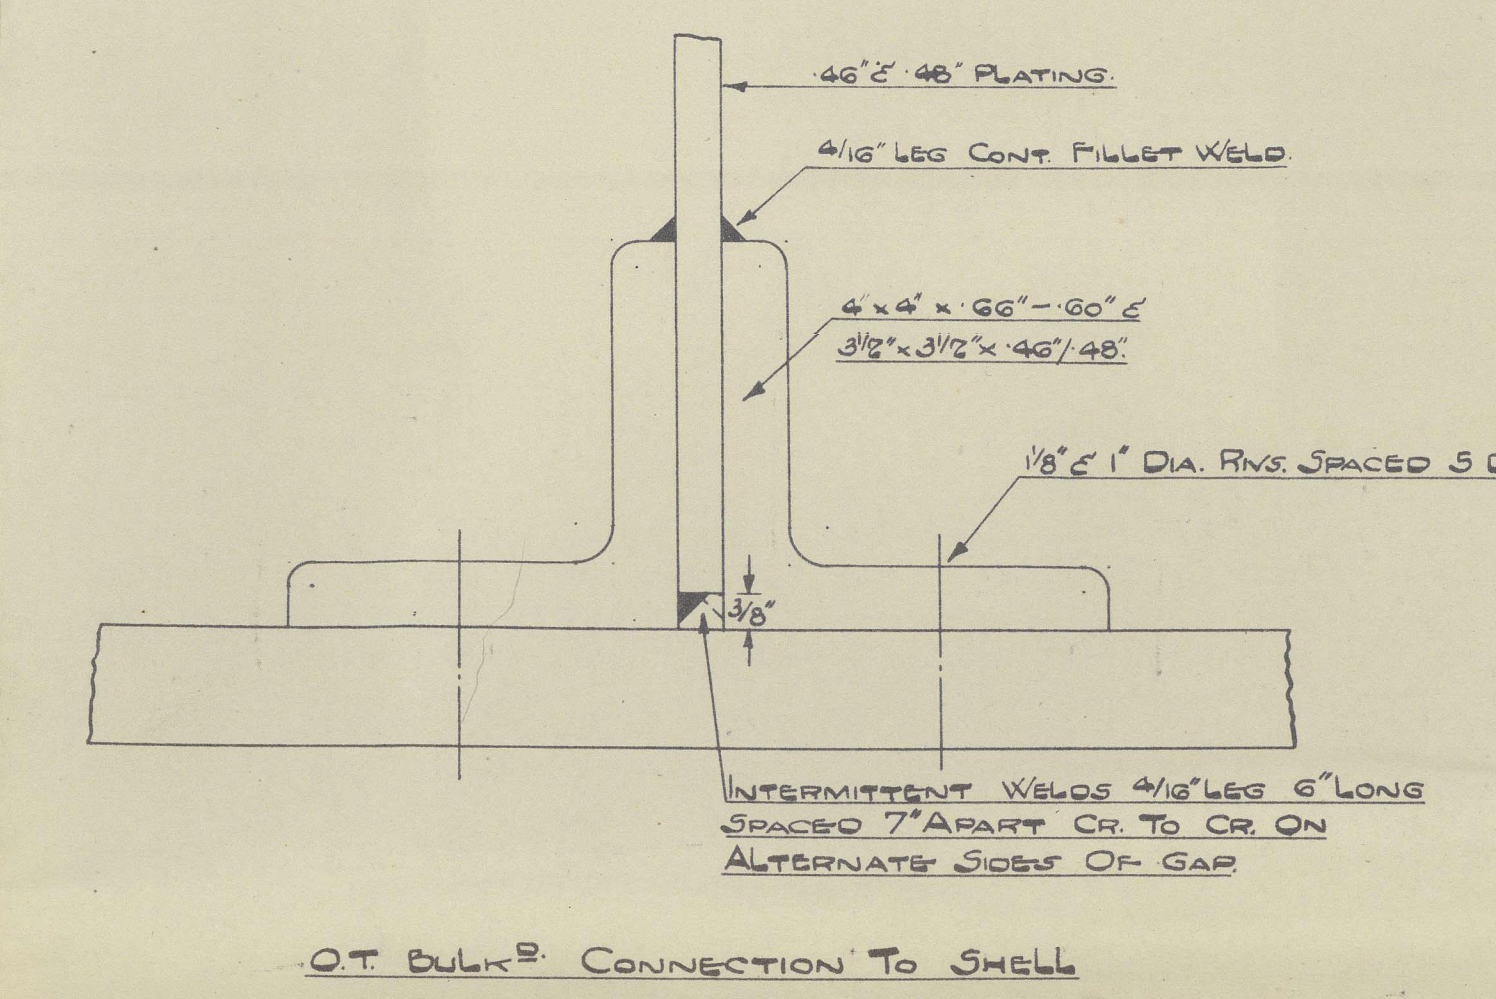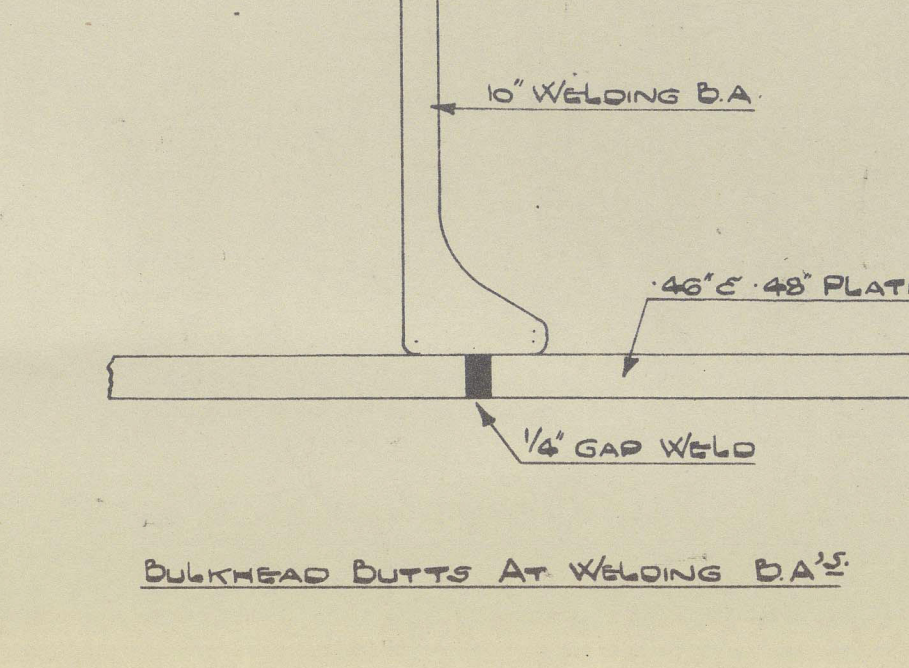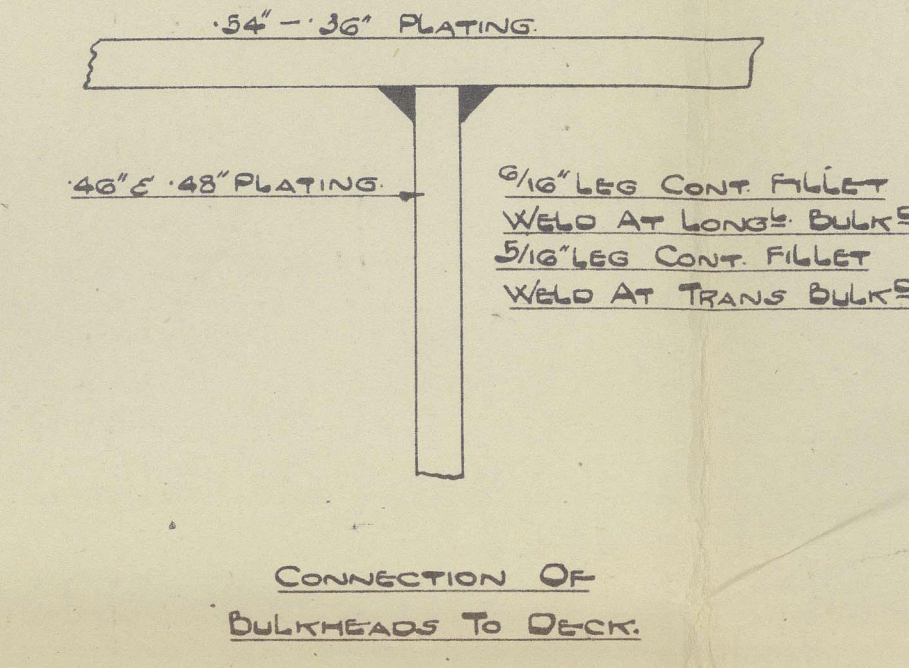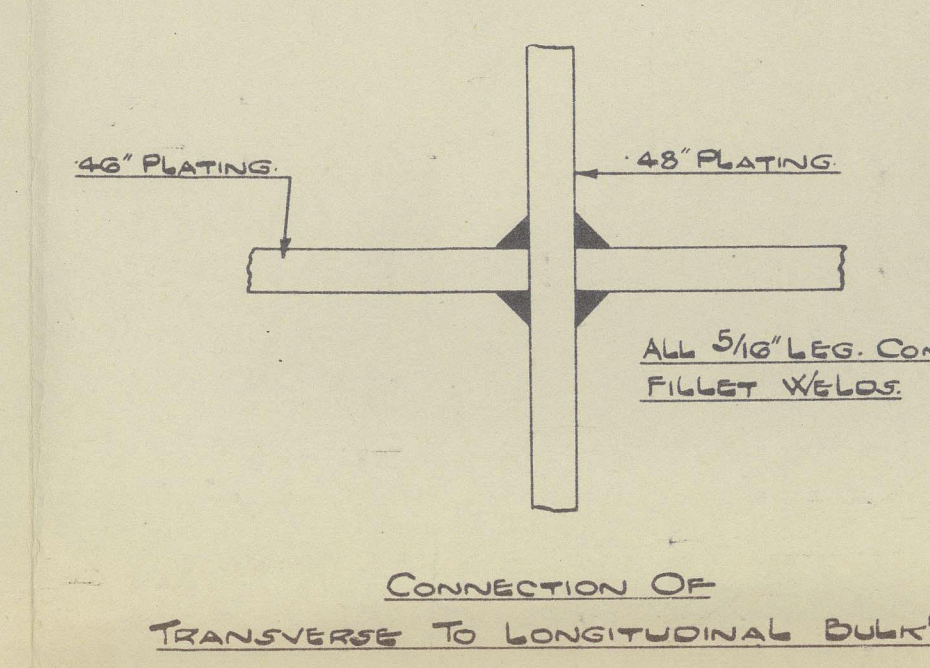

O.T. CR LINE BULKHEAD

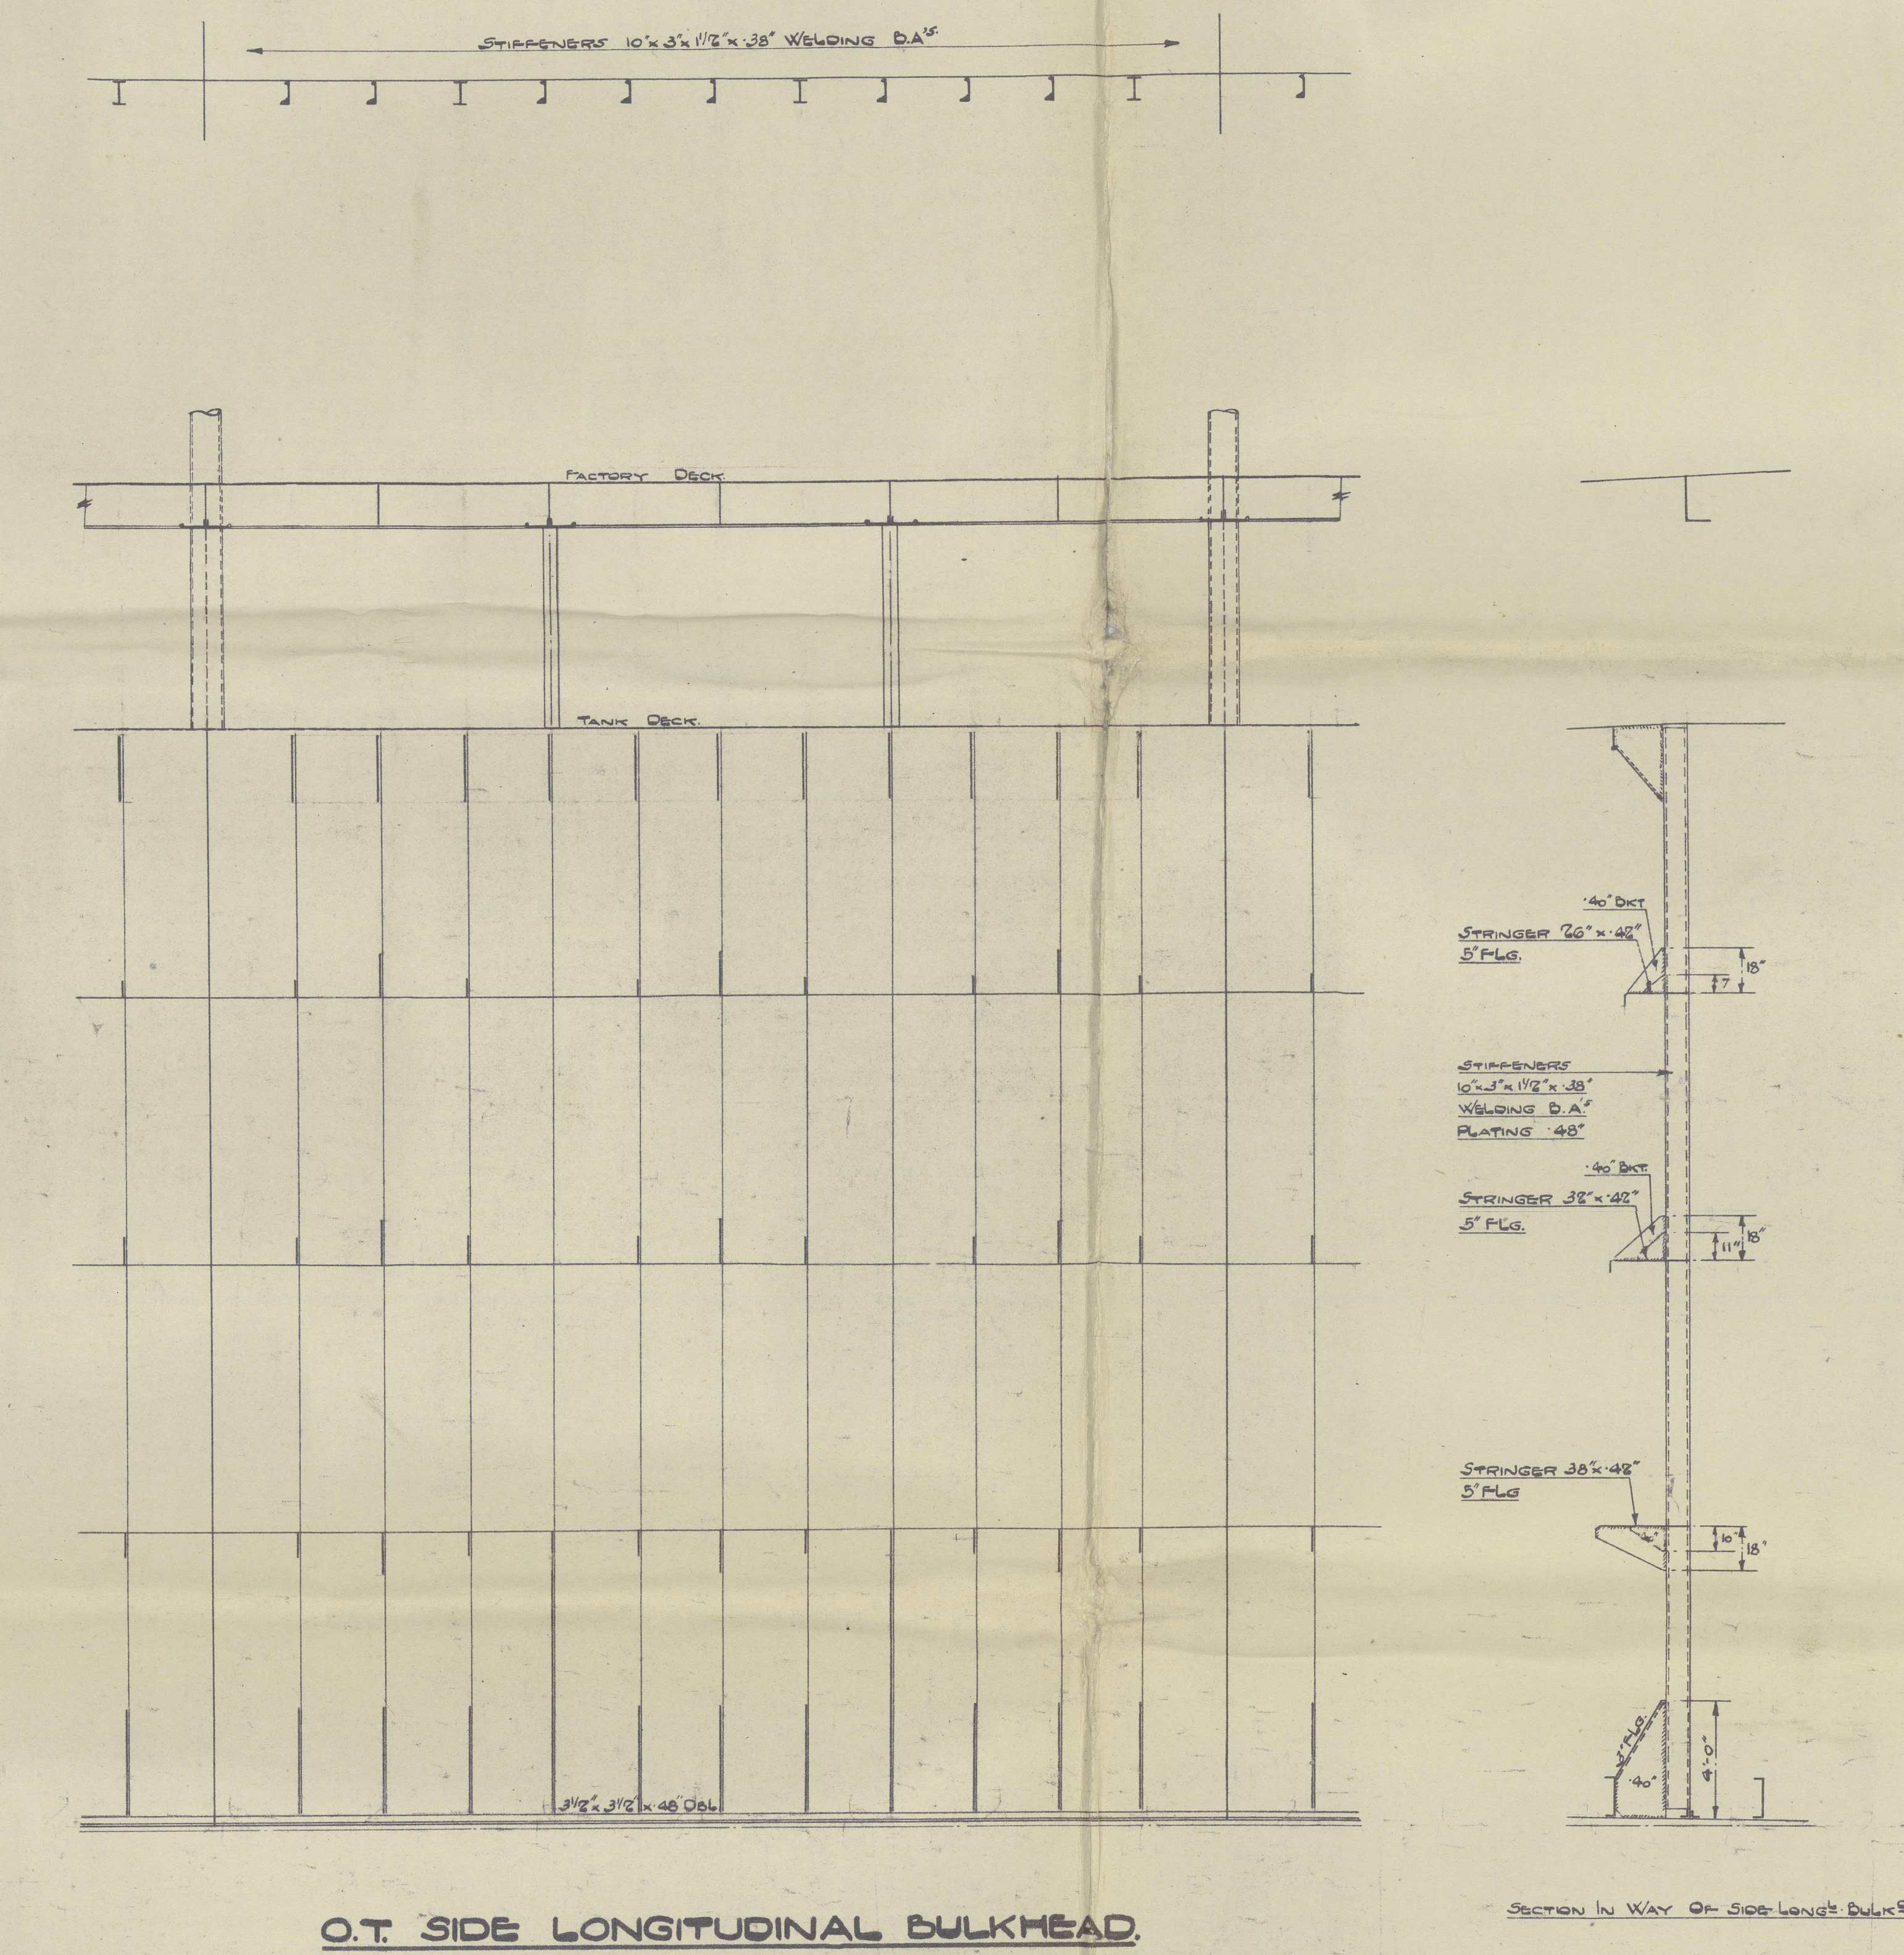

O.T. SIDE LONGITUDINAL BULKHEAD

1A

HARLAND & WOLFF LTD.
BELFAST

RECORDS DEPT.
LONDON

No. 1384 "JUAN PERON" ★

TITLE MIDSHIP SECTION
"AS FITTED"

DATE APPROVED VERIFIED 20/7/51

3

BELFAST FREEBOARD C11 (F.136)

Belfast Report No. 15293



© 2021

Lloyd's Register
Foundation
014023-014031-0168