

Technical drawing of a mechanical part, likely a bracket or support, showing front and side views with dimensions in millimeters (mm).

Front View Dimensions:

- Top width: 65 mm
- Top width: 90 mm
- Top width: 65 mm
- Left height: 5 mm
- Left height: 44 mm
- Right height: 25 mm

Side View Dimensions:

- Top width: 600 mm
- Top width: 230 mm
- Right height: 75 mm
- Right height: 200 mm
- Right height: 54 mm
- Bottom width: 600 mm
- Bottom width: 240 mm
- Bottom width: 100 mm
- Bottom width: 160 mm
- Bottom width: 65 mm

Other Labels:

- 387m bouten (387mm bolts)
- 1325

Hand-drawn plan view of a boat hull. The hull is elongated and tapers to a point at the bow. Dimensions are marked along the top edge: 860, 300, 240, and 350. Labels include "2mer." and "Vulstuk" at the bow, "pl. 10" in the middle section, and "plaat 8 1/2" near the stern. At the stern, there are two rectangular sections labeled "L 140 x 75 x 10" and "L 75 x 75 x 9".

Material: Achterstoven en Roerarmen Gietstaal

STRAAP.
Sluitstrippen 65 x 9.

blaas 10

65 x 65 x 1

R = 100

Spie 38 x 13
KEY

gat 128

220

45°

45°

45°

45°

100
100
100

Spanto.

400

400

GIVING TO SURVEYOR'S SATISFACTION.

400

100

Huidlens Volgens spantenvloer.

500 300

500

voorsnede Steven.

100

80

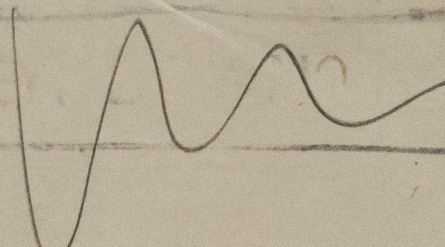
[illegible][illegible]

Material: Smeedyzer

[illegible]

OK.
6-1-36.

Veranderingen:	
DATUM	M A N D
24-12-57	28-12-57
GROEPEN	
Afkomstige	
Nieuwkomer	
Schiet	Ronde No.
1:10	
1:20	
1:4	
Opmerkingen	Toekening
<p>N.V. Industriële Maatschappij „DE NOORD“ ALBASSERDAM HOLLAND</p> <p>Roor en Stevens Motornachtschip 48.50 x 6.00 x 2.60 m.</p>	<p>7</p>

G  ~~4050~~ B

N.V. IND. MY. "DE NOORD"

559.

"Edenwale"

STEM.

STERN FRAME.

RUDDER.

(2)



© 2021

Lloyd's Register
Foundation

014143-014153-0185