


ELLINIS
FALSE BOW
1/2" = 1 FOOT




REMARKS OR TYPE, No. 964

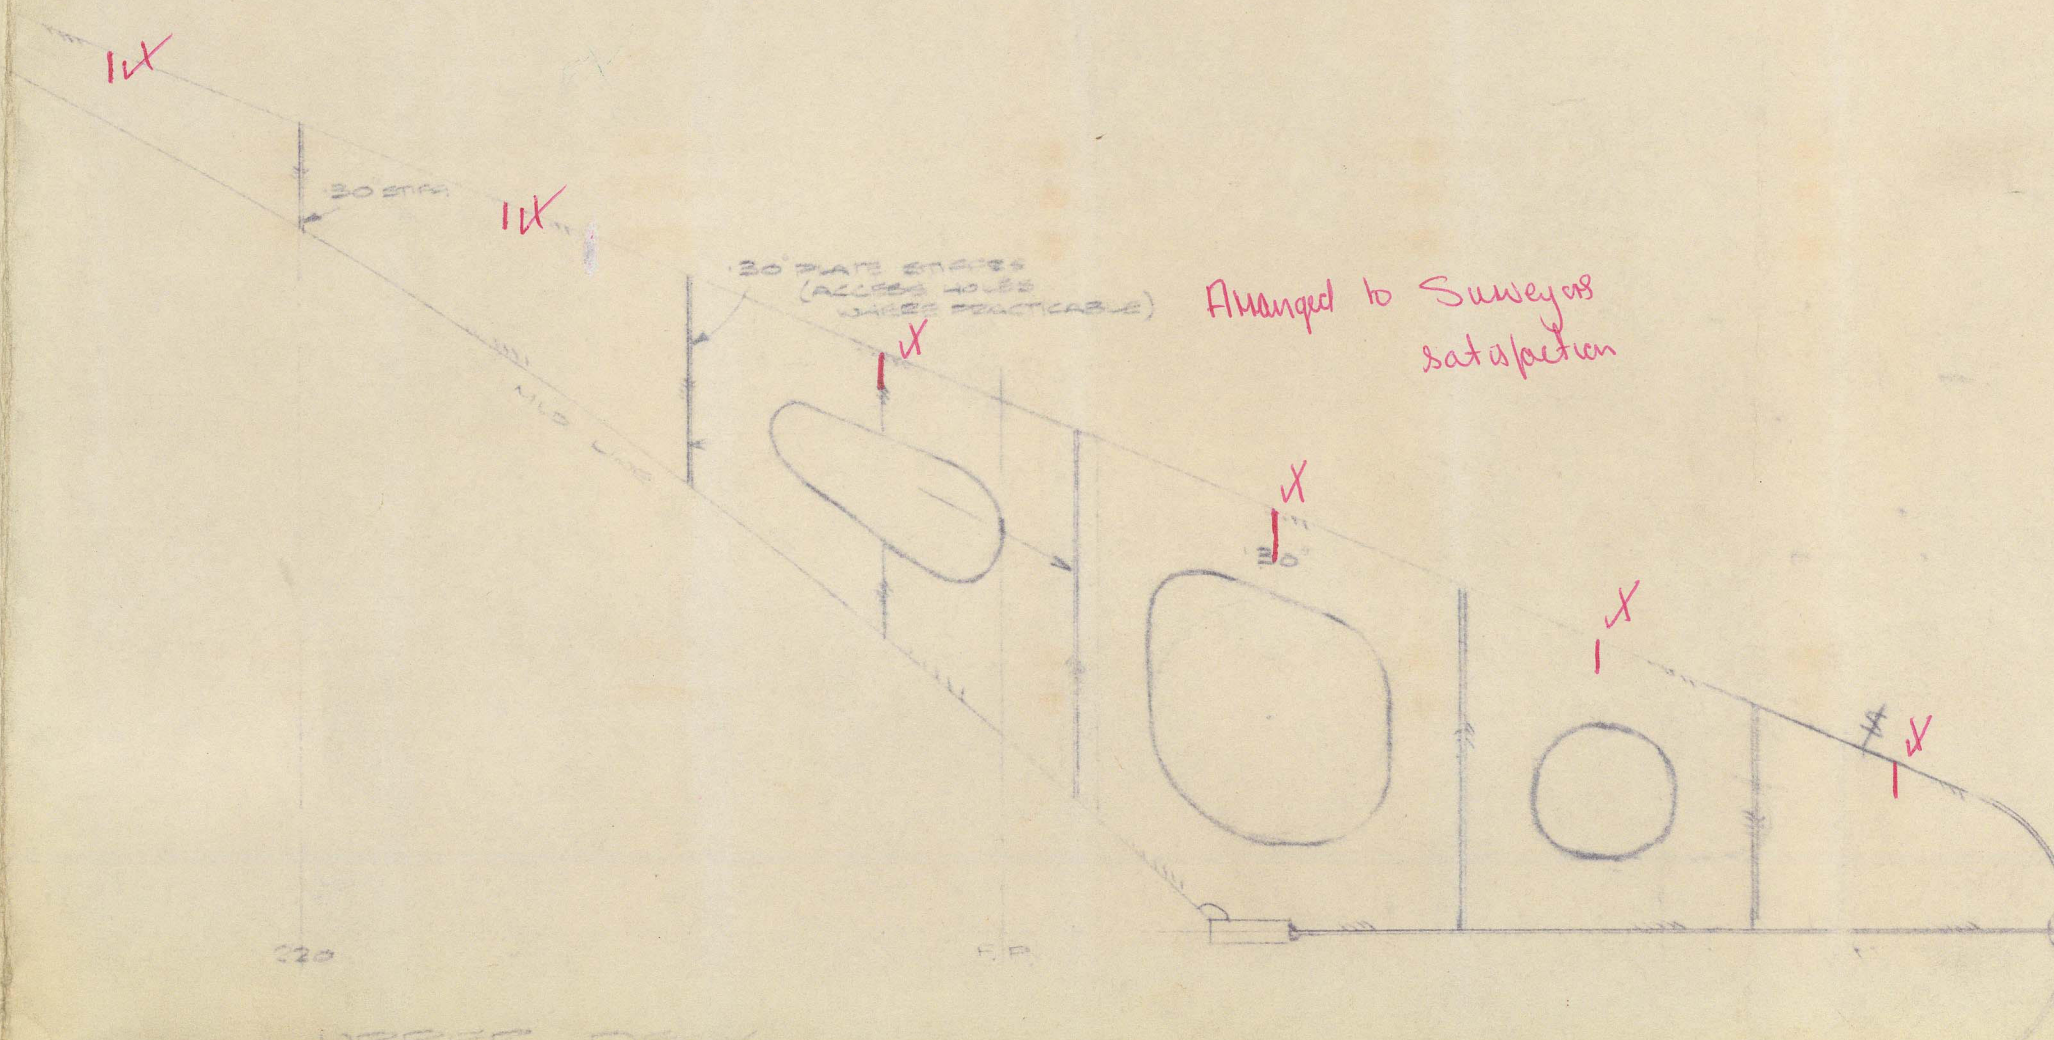


Aligned to Surveyor satisfaction


7 x 3/4" F.B. Stiffers introduced between longitudinal webs. Ends splayed

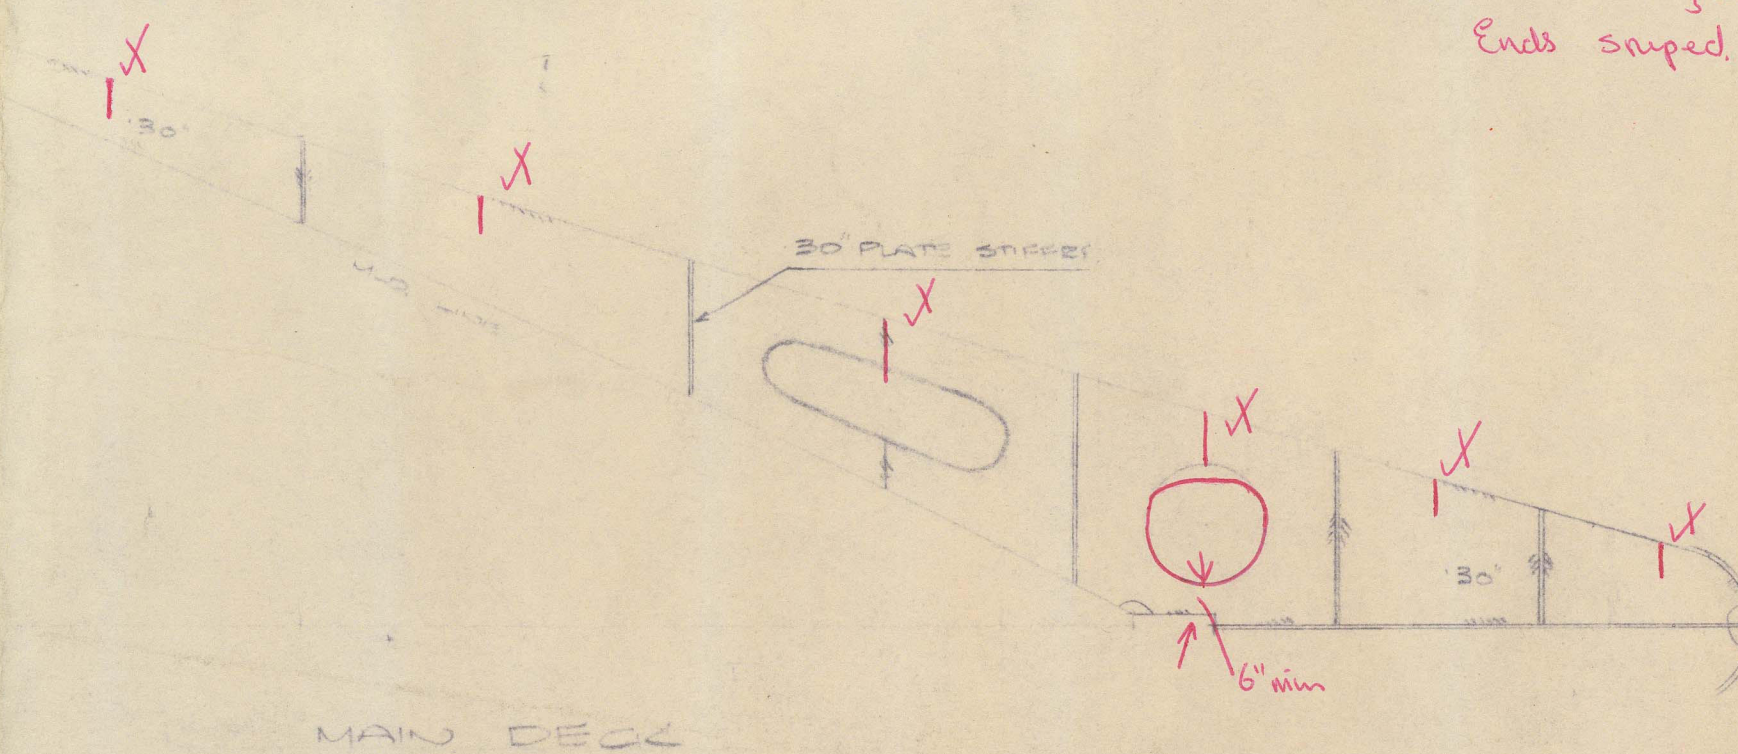

MAIN DECK

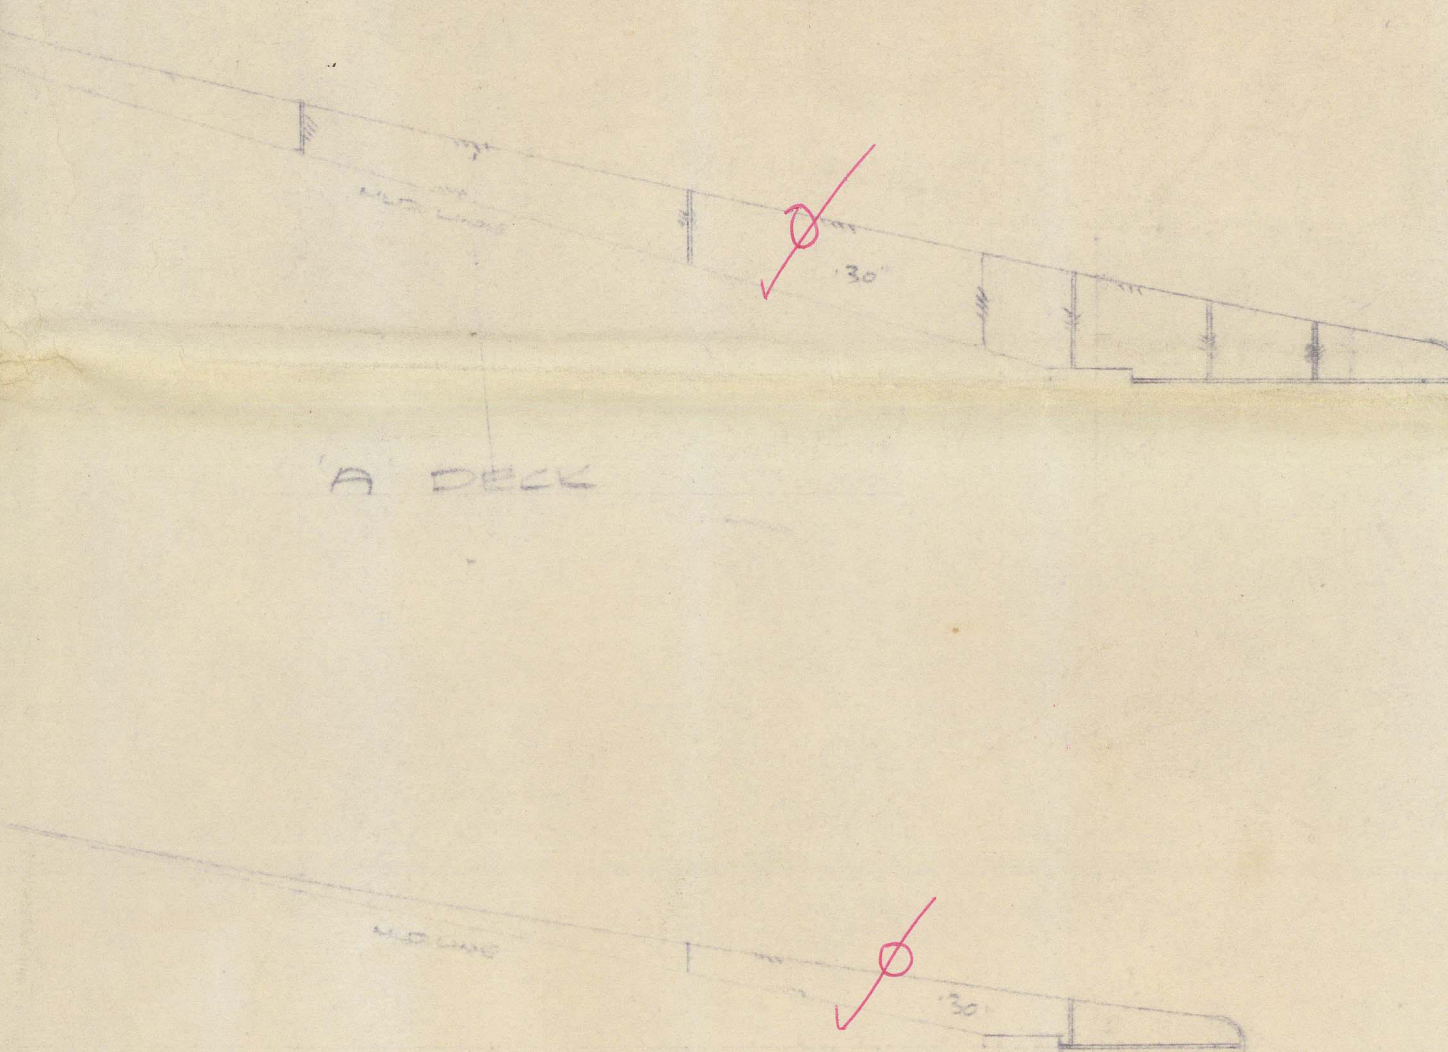


A DECK

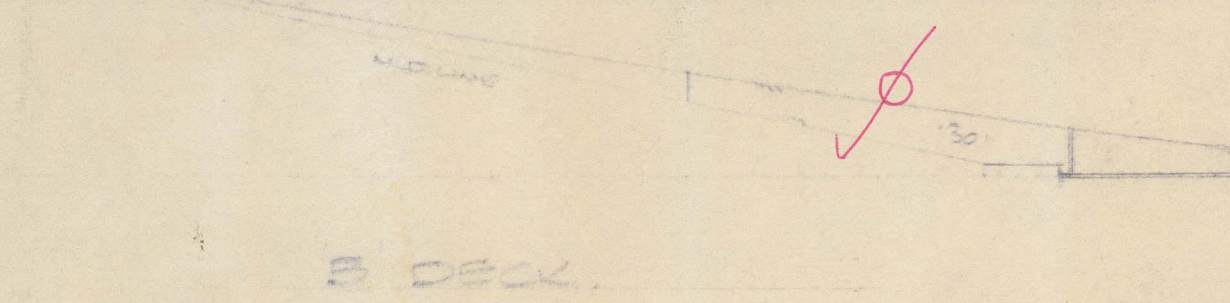

B DECK

Additional panel stiffening arranged at ship to Surveyor satisfaction

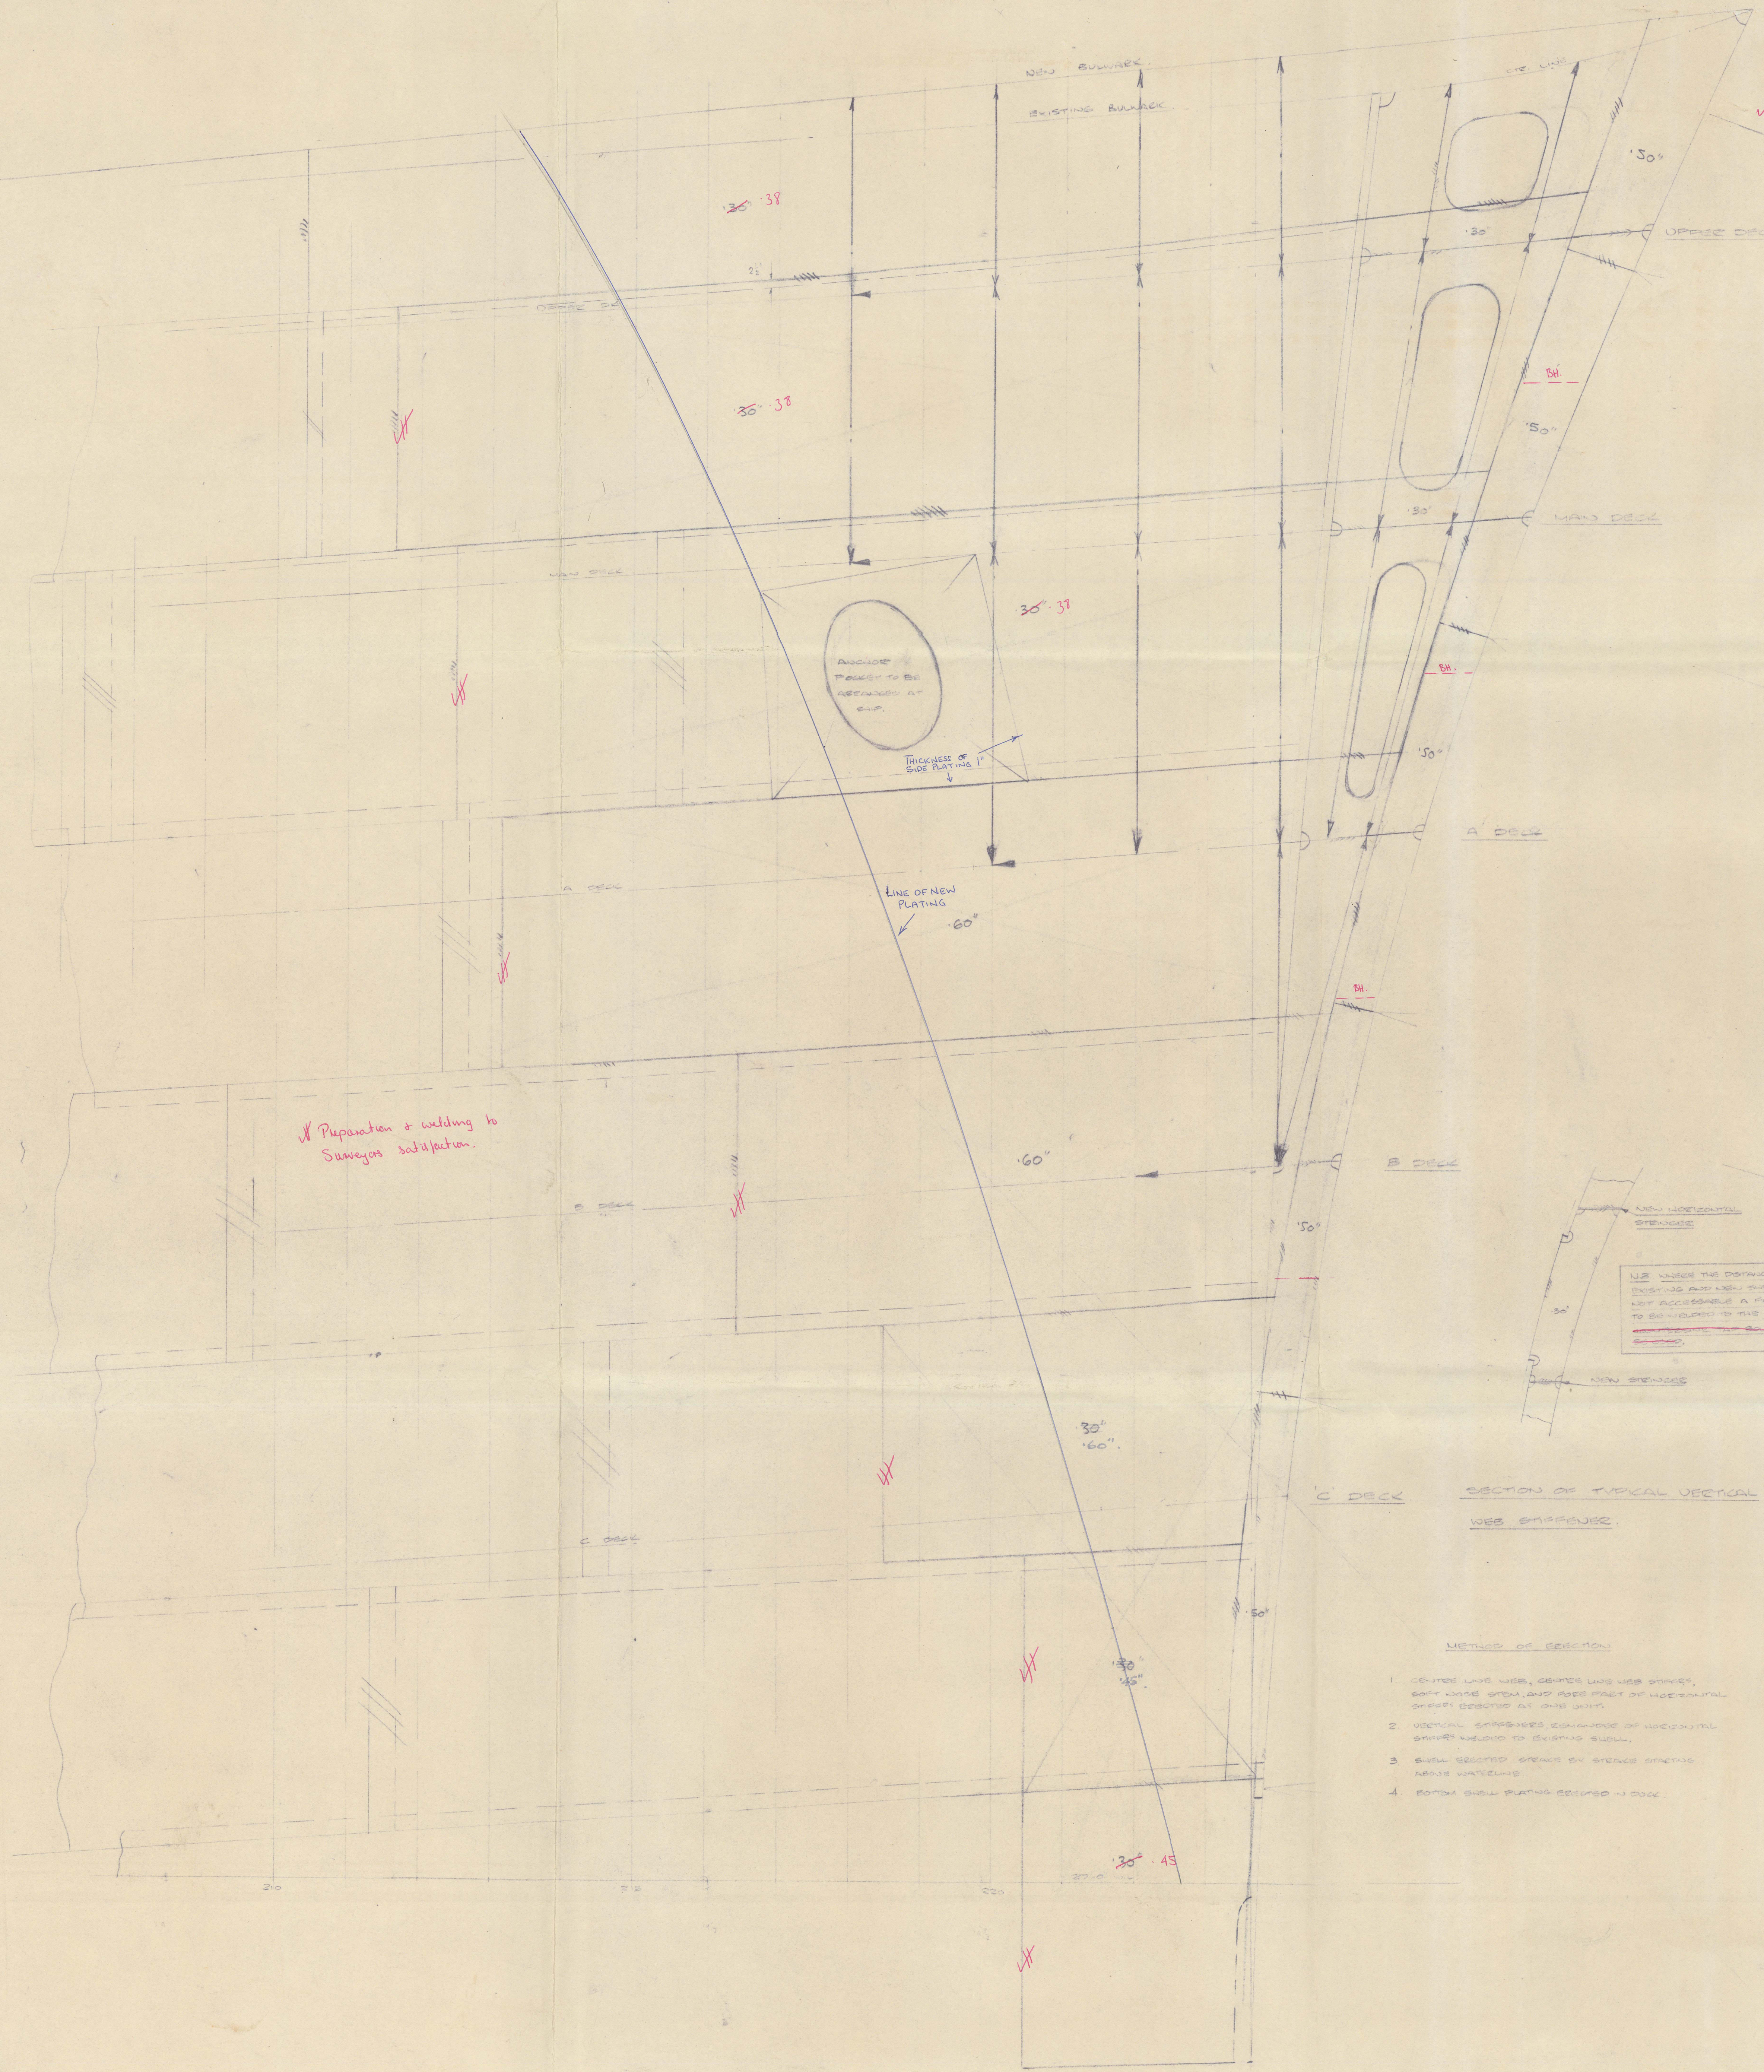

Preparation & welding to Surveyor satisfaction


Slot welds adopted. Details to Surveyor satisfaction

SECTION OF TYPICAL VERTICAL WEB STIFFENER






© 2021 Lloyd's Register Foundation

KPA.

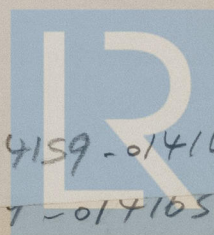

© 2021

014159-014165-0004
014159-014165-0004
Lloyd's Register
Foundation