

plan No 1.


Ned Scheepsbouw Maats

S.S. Nos 126-127.



Midship Section. ^{Helania} Ex
126 SS "ARTEMIS"

Ams. 5977

127. Anes
Ams. 6072

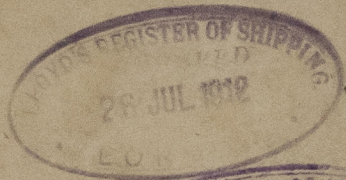

Helania

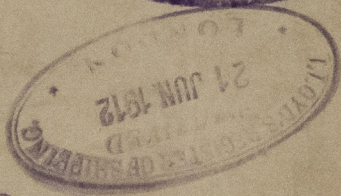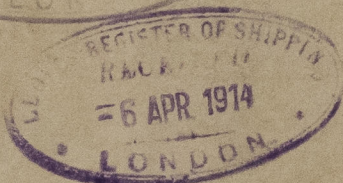

014166 - 014174 - 0100



© 2021

Lloyd's Register
Foundation

014166 - 014174 - 0100