

FORECASTLE DECK

26.10.98

POOP DECK

SPAR DECK

MAIN DECK

ALL STRINGER PLATES AS PER MIDSHIP SECTION.
SPAR DECK PLATING IN WAY OF HATCHES THICKENED
IN LIEU OF DOUBLING, EXCEPT AT ENGINE HATCH
WHICH IS DOUBLED. PLATES INCREASED MARKED ON PLAN.
MAIN DECK TIE PLATES INCREASED IN WIDTH TO
30" IN WAY OF HATCHES.


webs in lower deck in way of large deck beams

NEW YORK AND PORTO
Rico St.

SPALS 1/4" - 1 FT.

ORDER NO 3.1 - 1

Lloyd's Register
Foundation

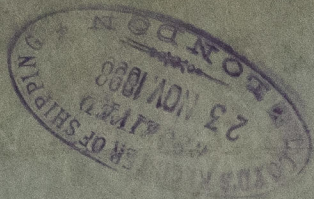


014198 014201-0431



© 2021

Lloyd's Register
Foundation

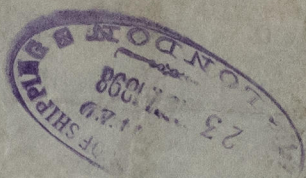

General Plan. S.S. Ponce
Report Nr 909.



© 2021

Lloyd's Register

014198-014209-0431