


PROFILE AND DECKS. NOS 654-5 SHIPS. SCALE 1/4" = 1 FT.

CLASS 100-A.1 STEAM TRAWLERS. LENGTH 175'-0" B.P. x 30'-0" B.M.D. x 16'-0" D.M.D.

 

PLANS TRANSFERRED
TO SISTER VESSEL

~~W.S. 376~~

Banyers


HULL

Barrow. Cook, Melton & Gemmell, Ltd. Beverley

Yard No. 654/s

Profile & Deck Plan

"St. Apollo" & "St. Zeno"
50776 & 50794.

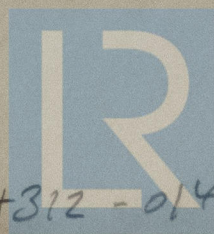

© 2021

Lloyd's Register
Foundation

014312 - 014324 - 0188