

# SHIP NOS. 654 & 55. MIDSHIP SECTION.

PRINCIPAL DIMS 175'-0" B.P. x 30'-0" MLD x 16'-0" D. MLD.  
CLASS. 100A.I. STEAM TRAWLER.

SCALE 1/2" = 1 FOOT.


COOK WELTON & GEMMELL, LTD.  
SHIPBUILDERS  
BEVERLEY

## LLOYDS NUMERALS

D ----- 16.00  
B+D ----- 46.00  
L x D ----- 2800.00  
L x (B+D) ----- 8050.00  
d ----- 14.41  
L/D = 10.94 L/B = 5.83


## EQUIPMENT

1 STOCKLESS ANCHOR 13 CWTs  
1 " " 12 CWTs  
1 RODGERS ANCHOR 4 1/2 CWTs (EX STOCK)  
150 FATHOMS 1 5/16" STUD LINK CABLE  
60 FATHOMS OF 6" HAWSER } COMBINATION WIRES  
60 " " 6" WARP. } AS PREVIOUSLY APPROVED.

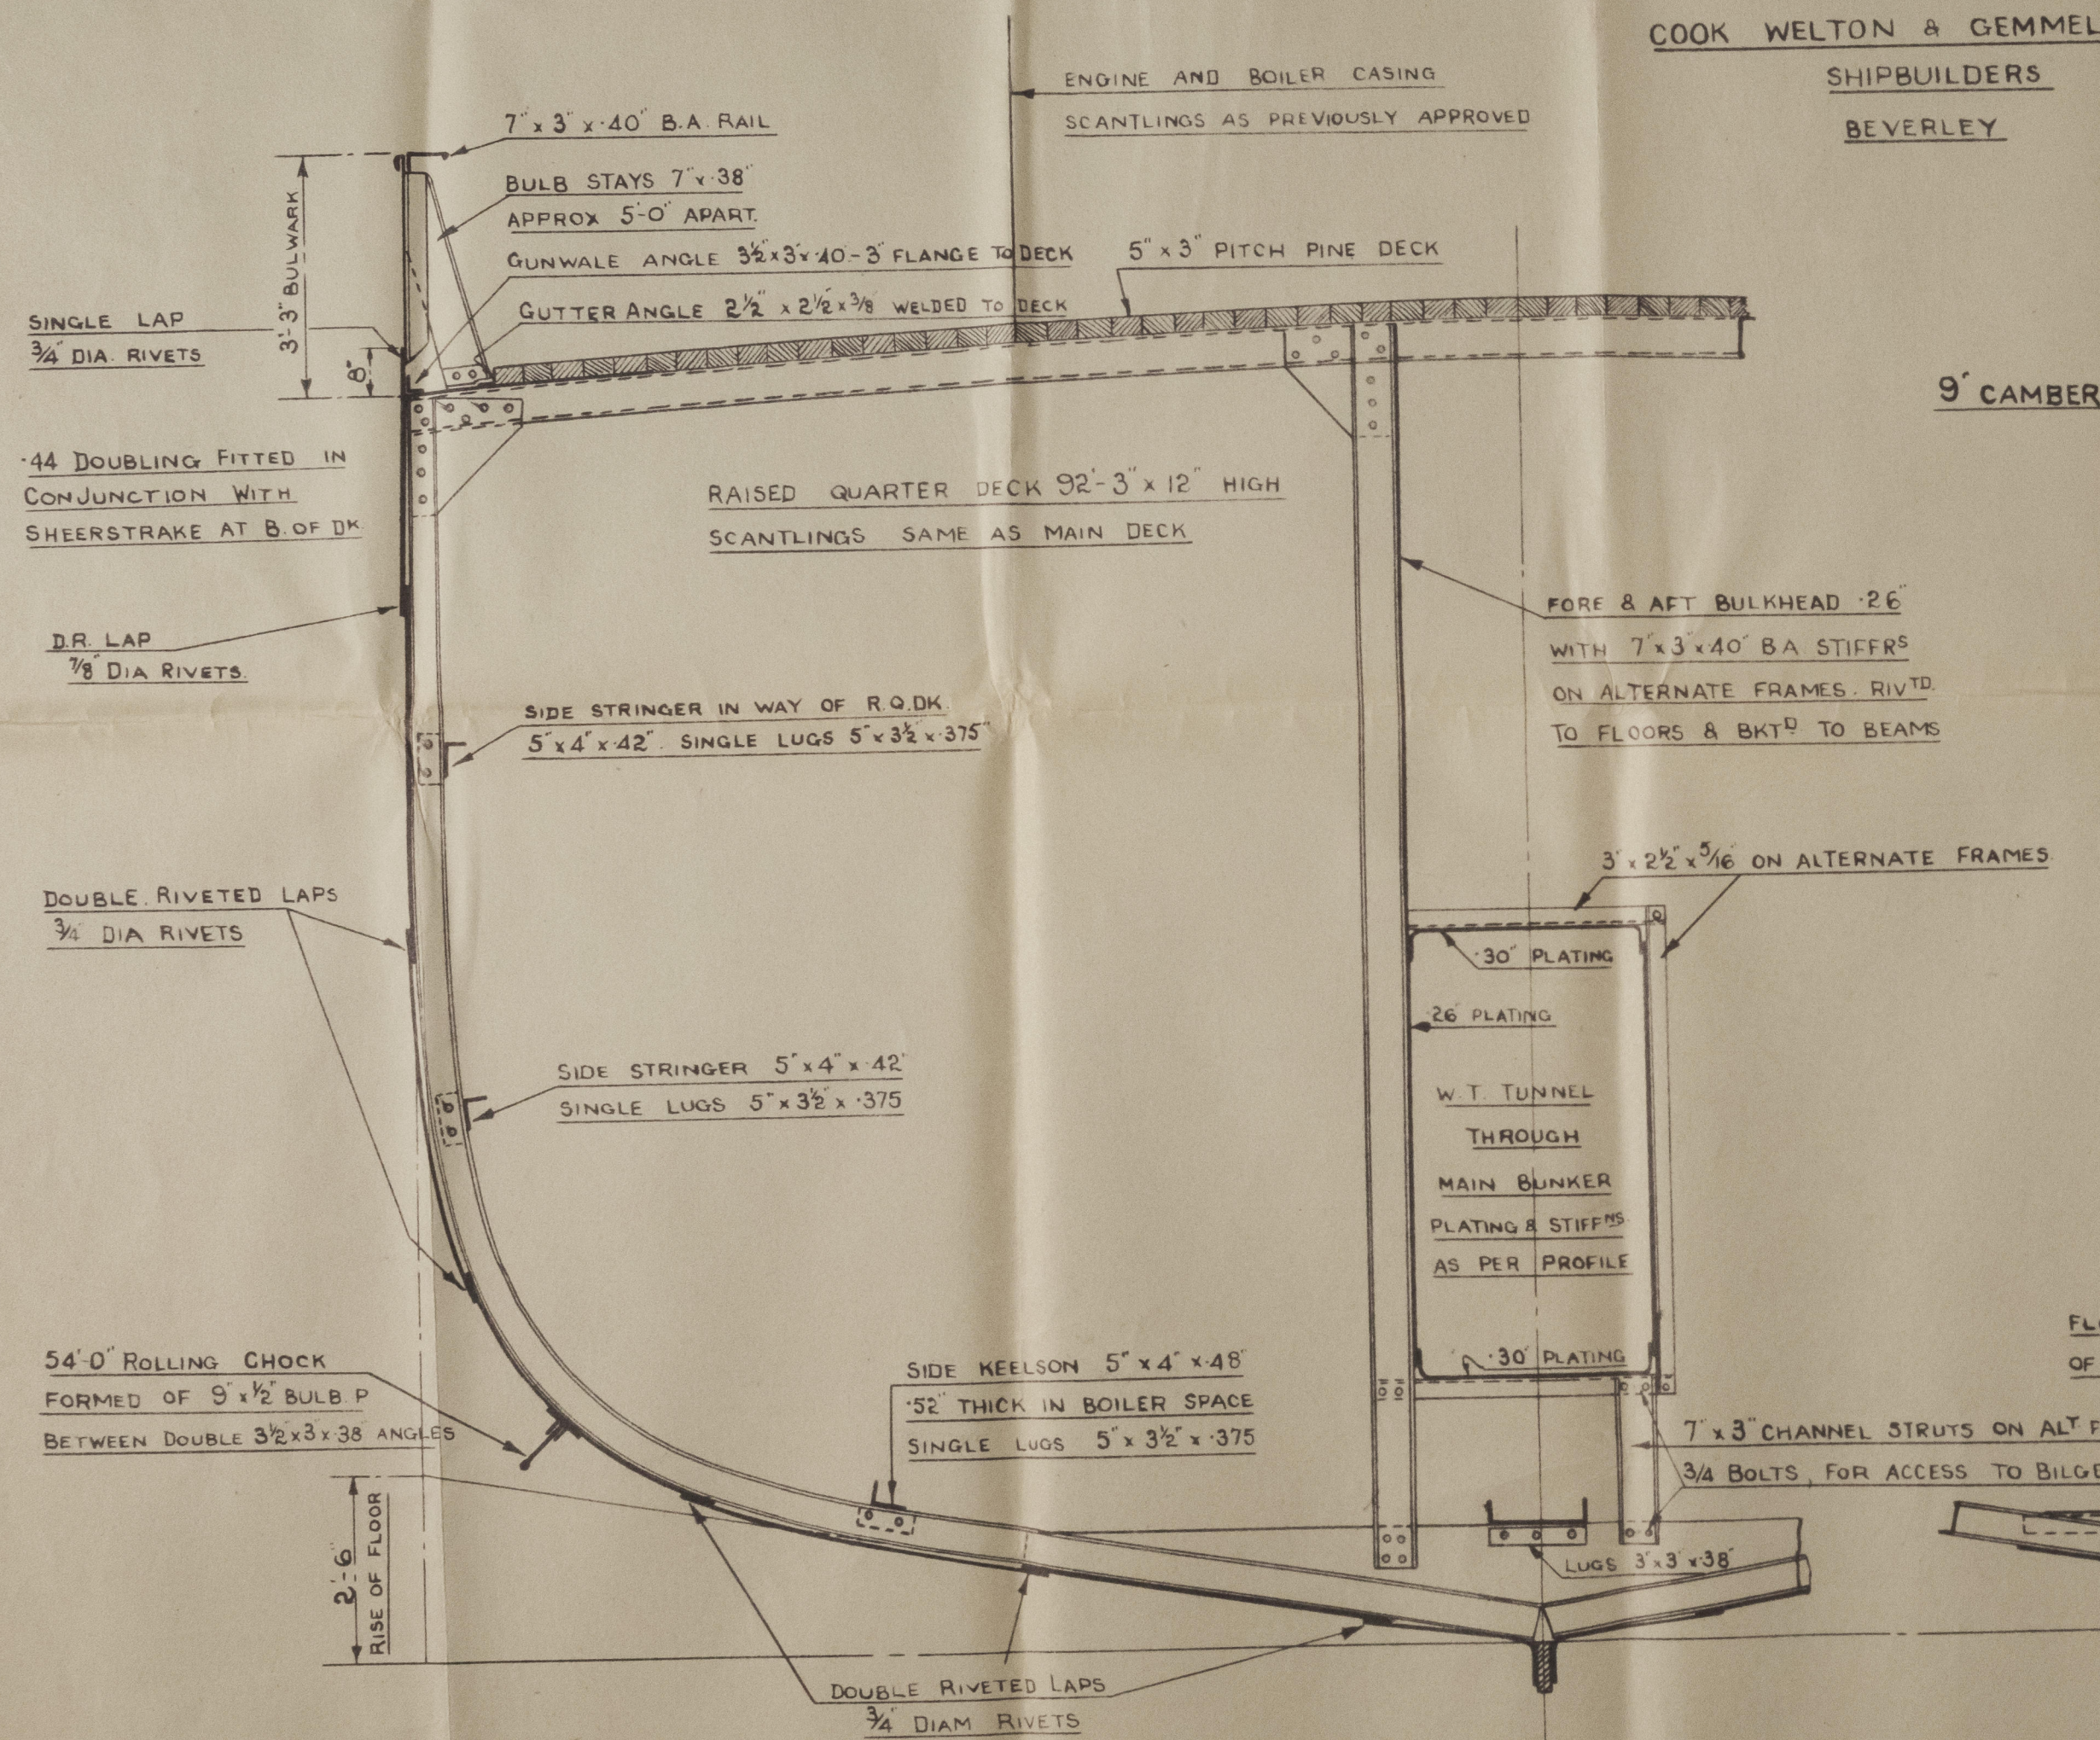

NOTE SHELL BEADINGS ELECTRICALLY  
WELDED ON IN LIEU OF RIVETING.

SECTION THROUGH MAIN BUNKER.  
RAISED QUARTER DECK

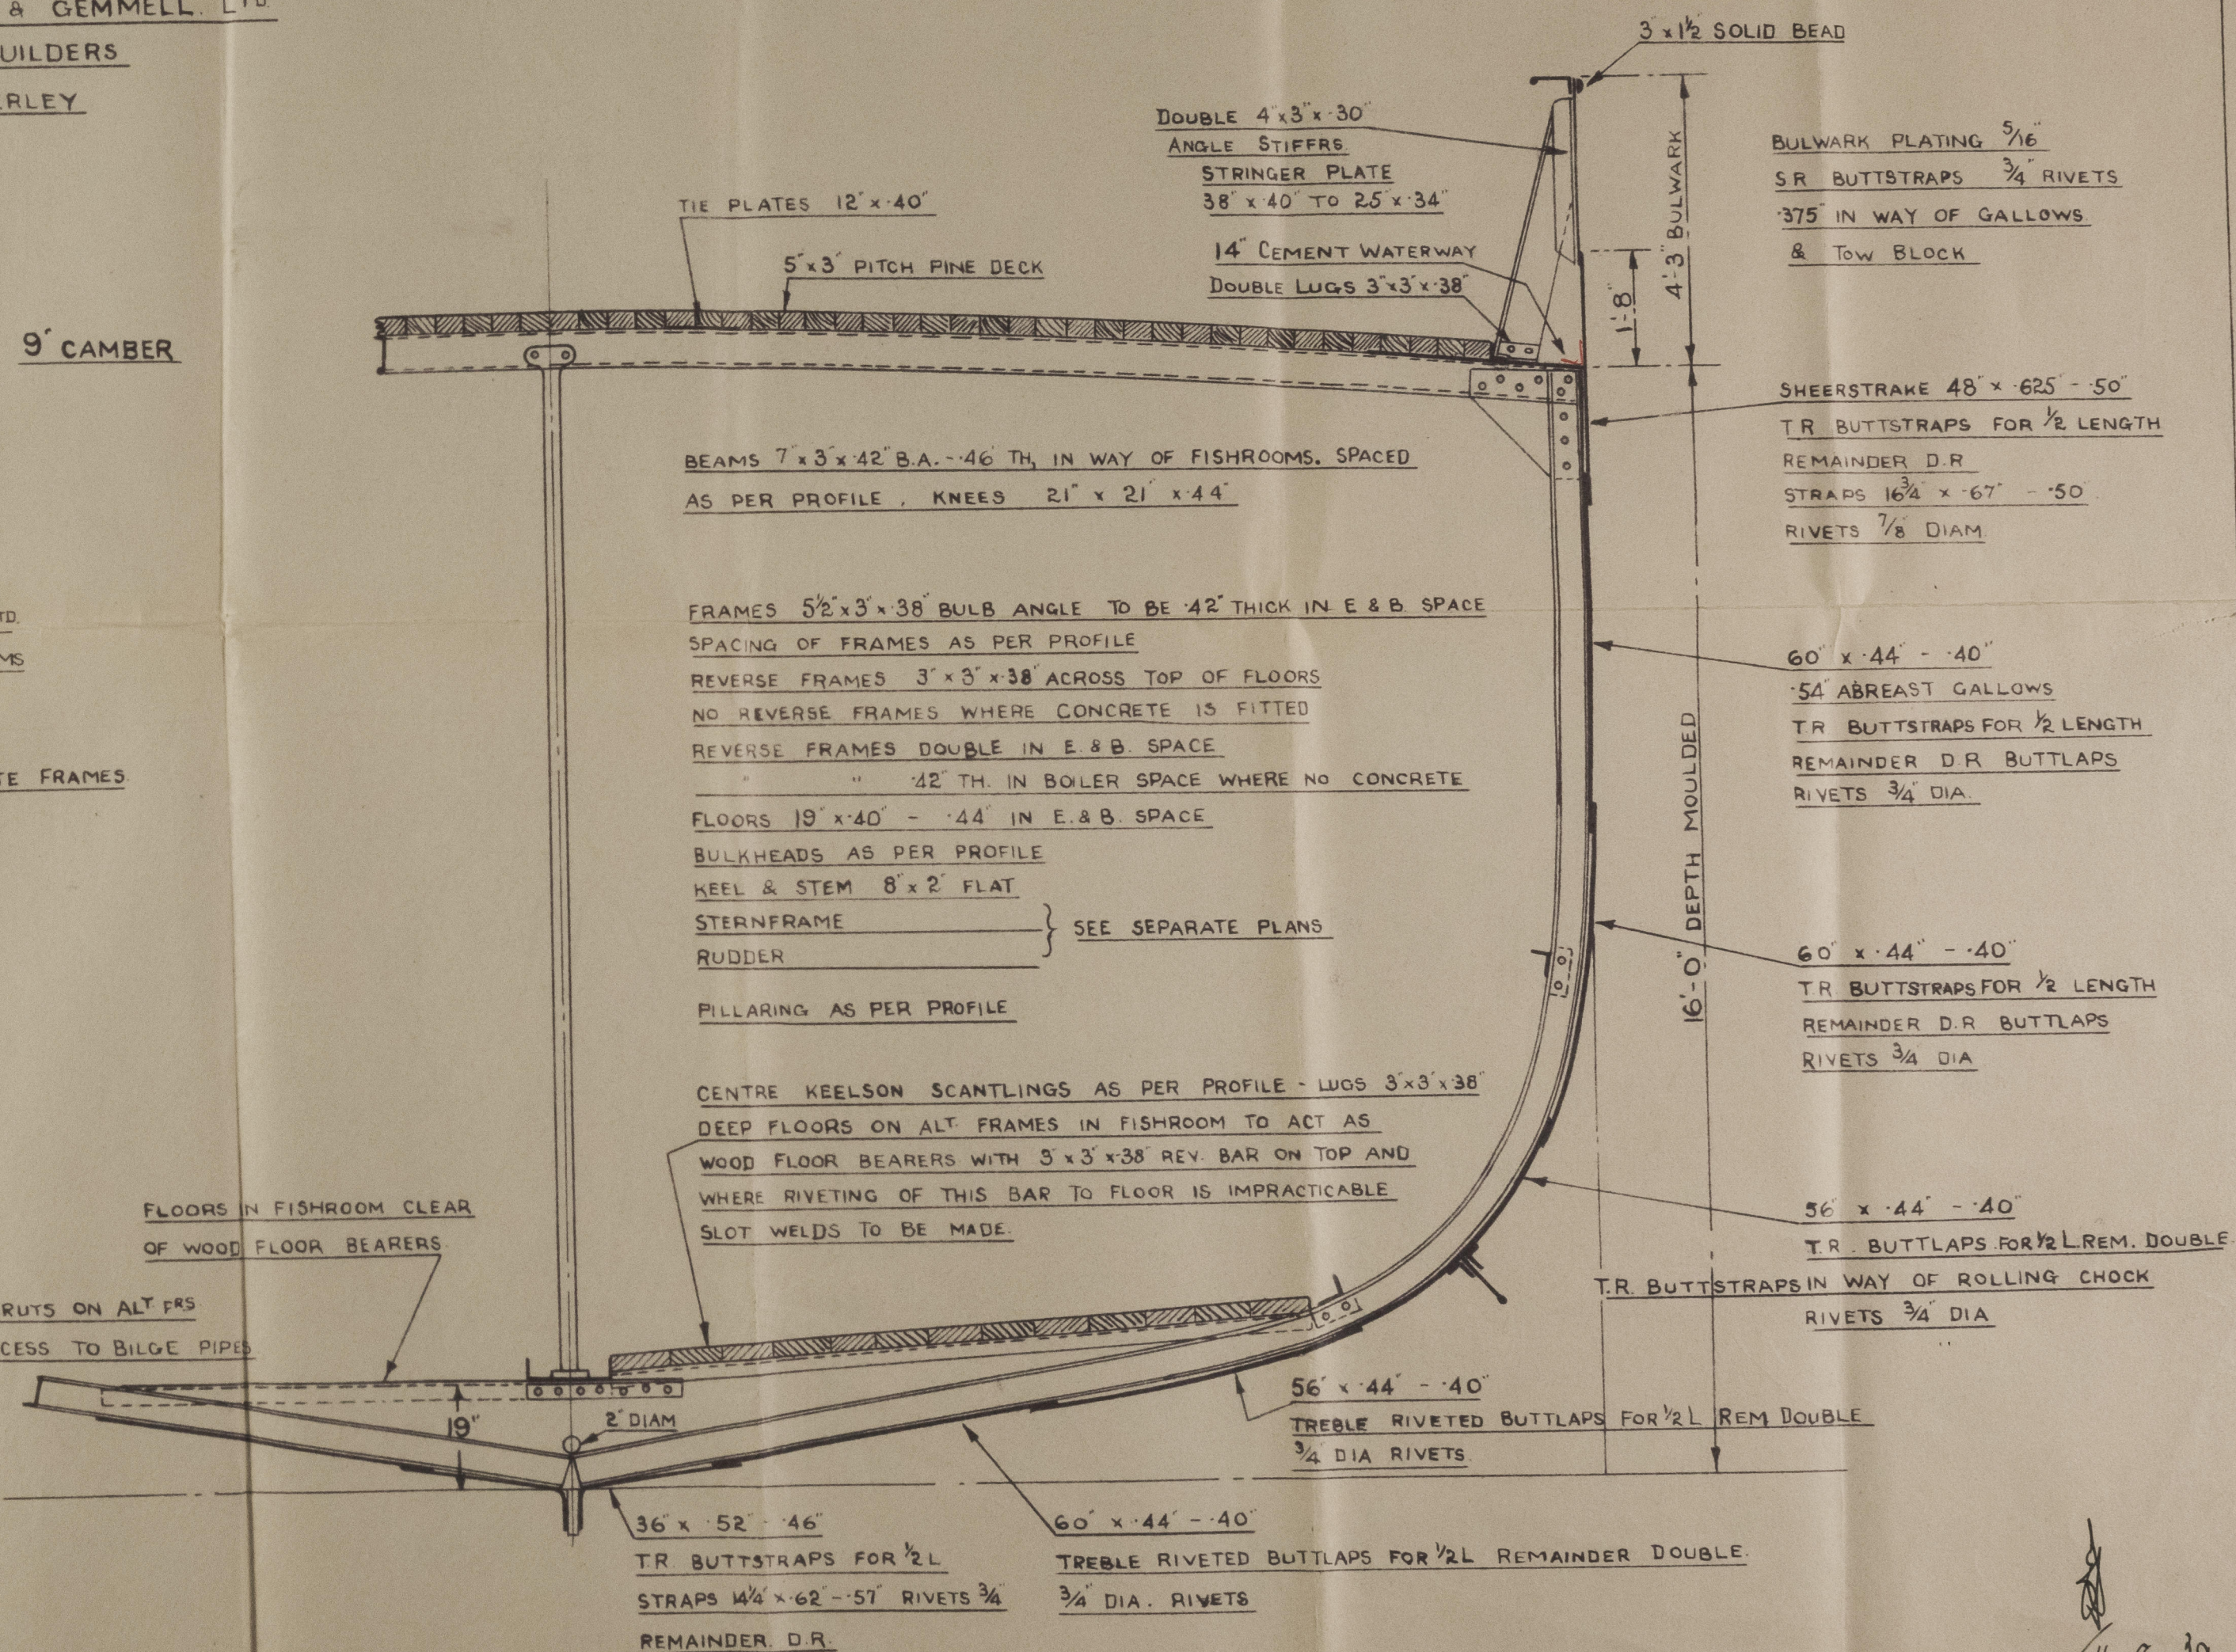

SECTION THROUGH MAIN DECK

APPROVED BY LLOYDS



