



"ARITA MARU"

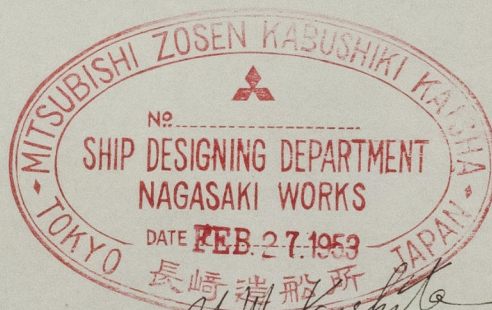

Rudder.

RECORDS DEPT.
LONDON

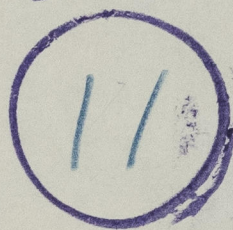

© 2021

Lloyd's Register
Foundation

014325-014334-0001