

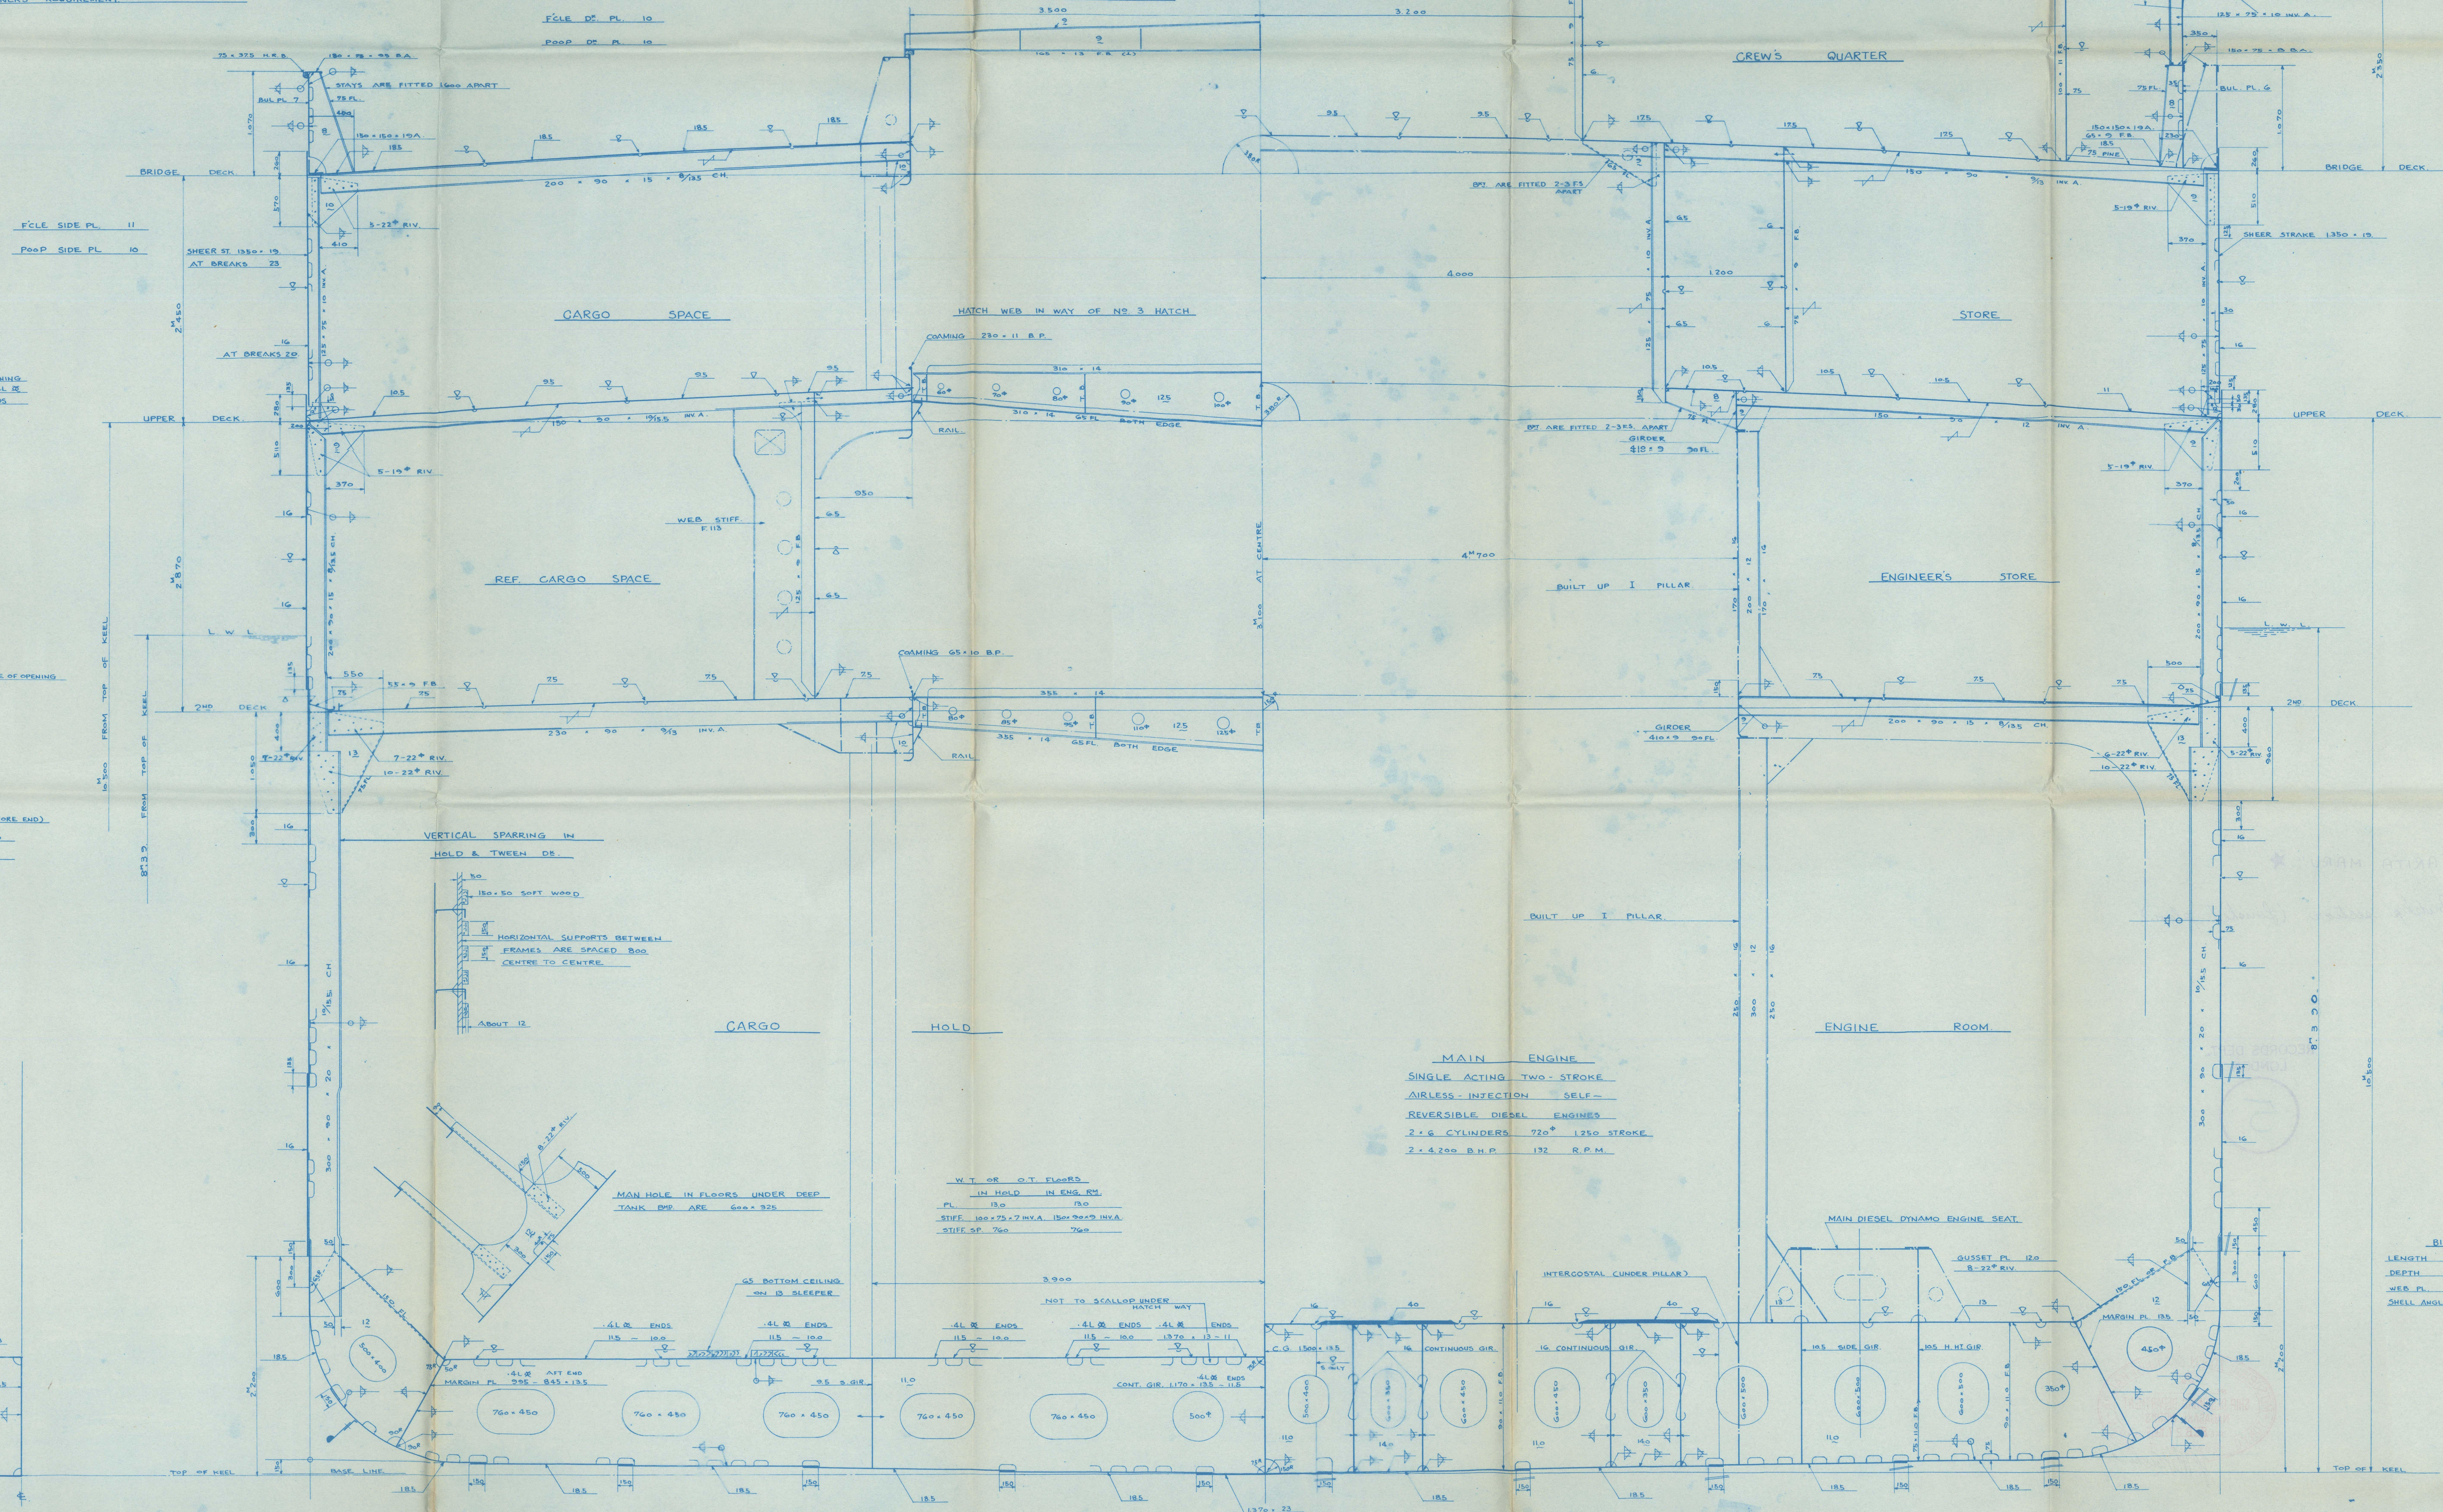
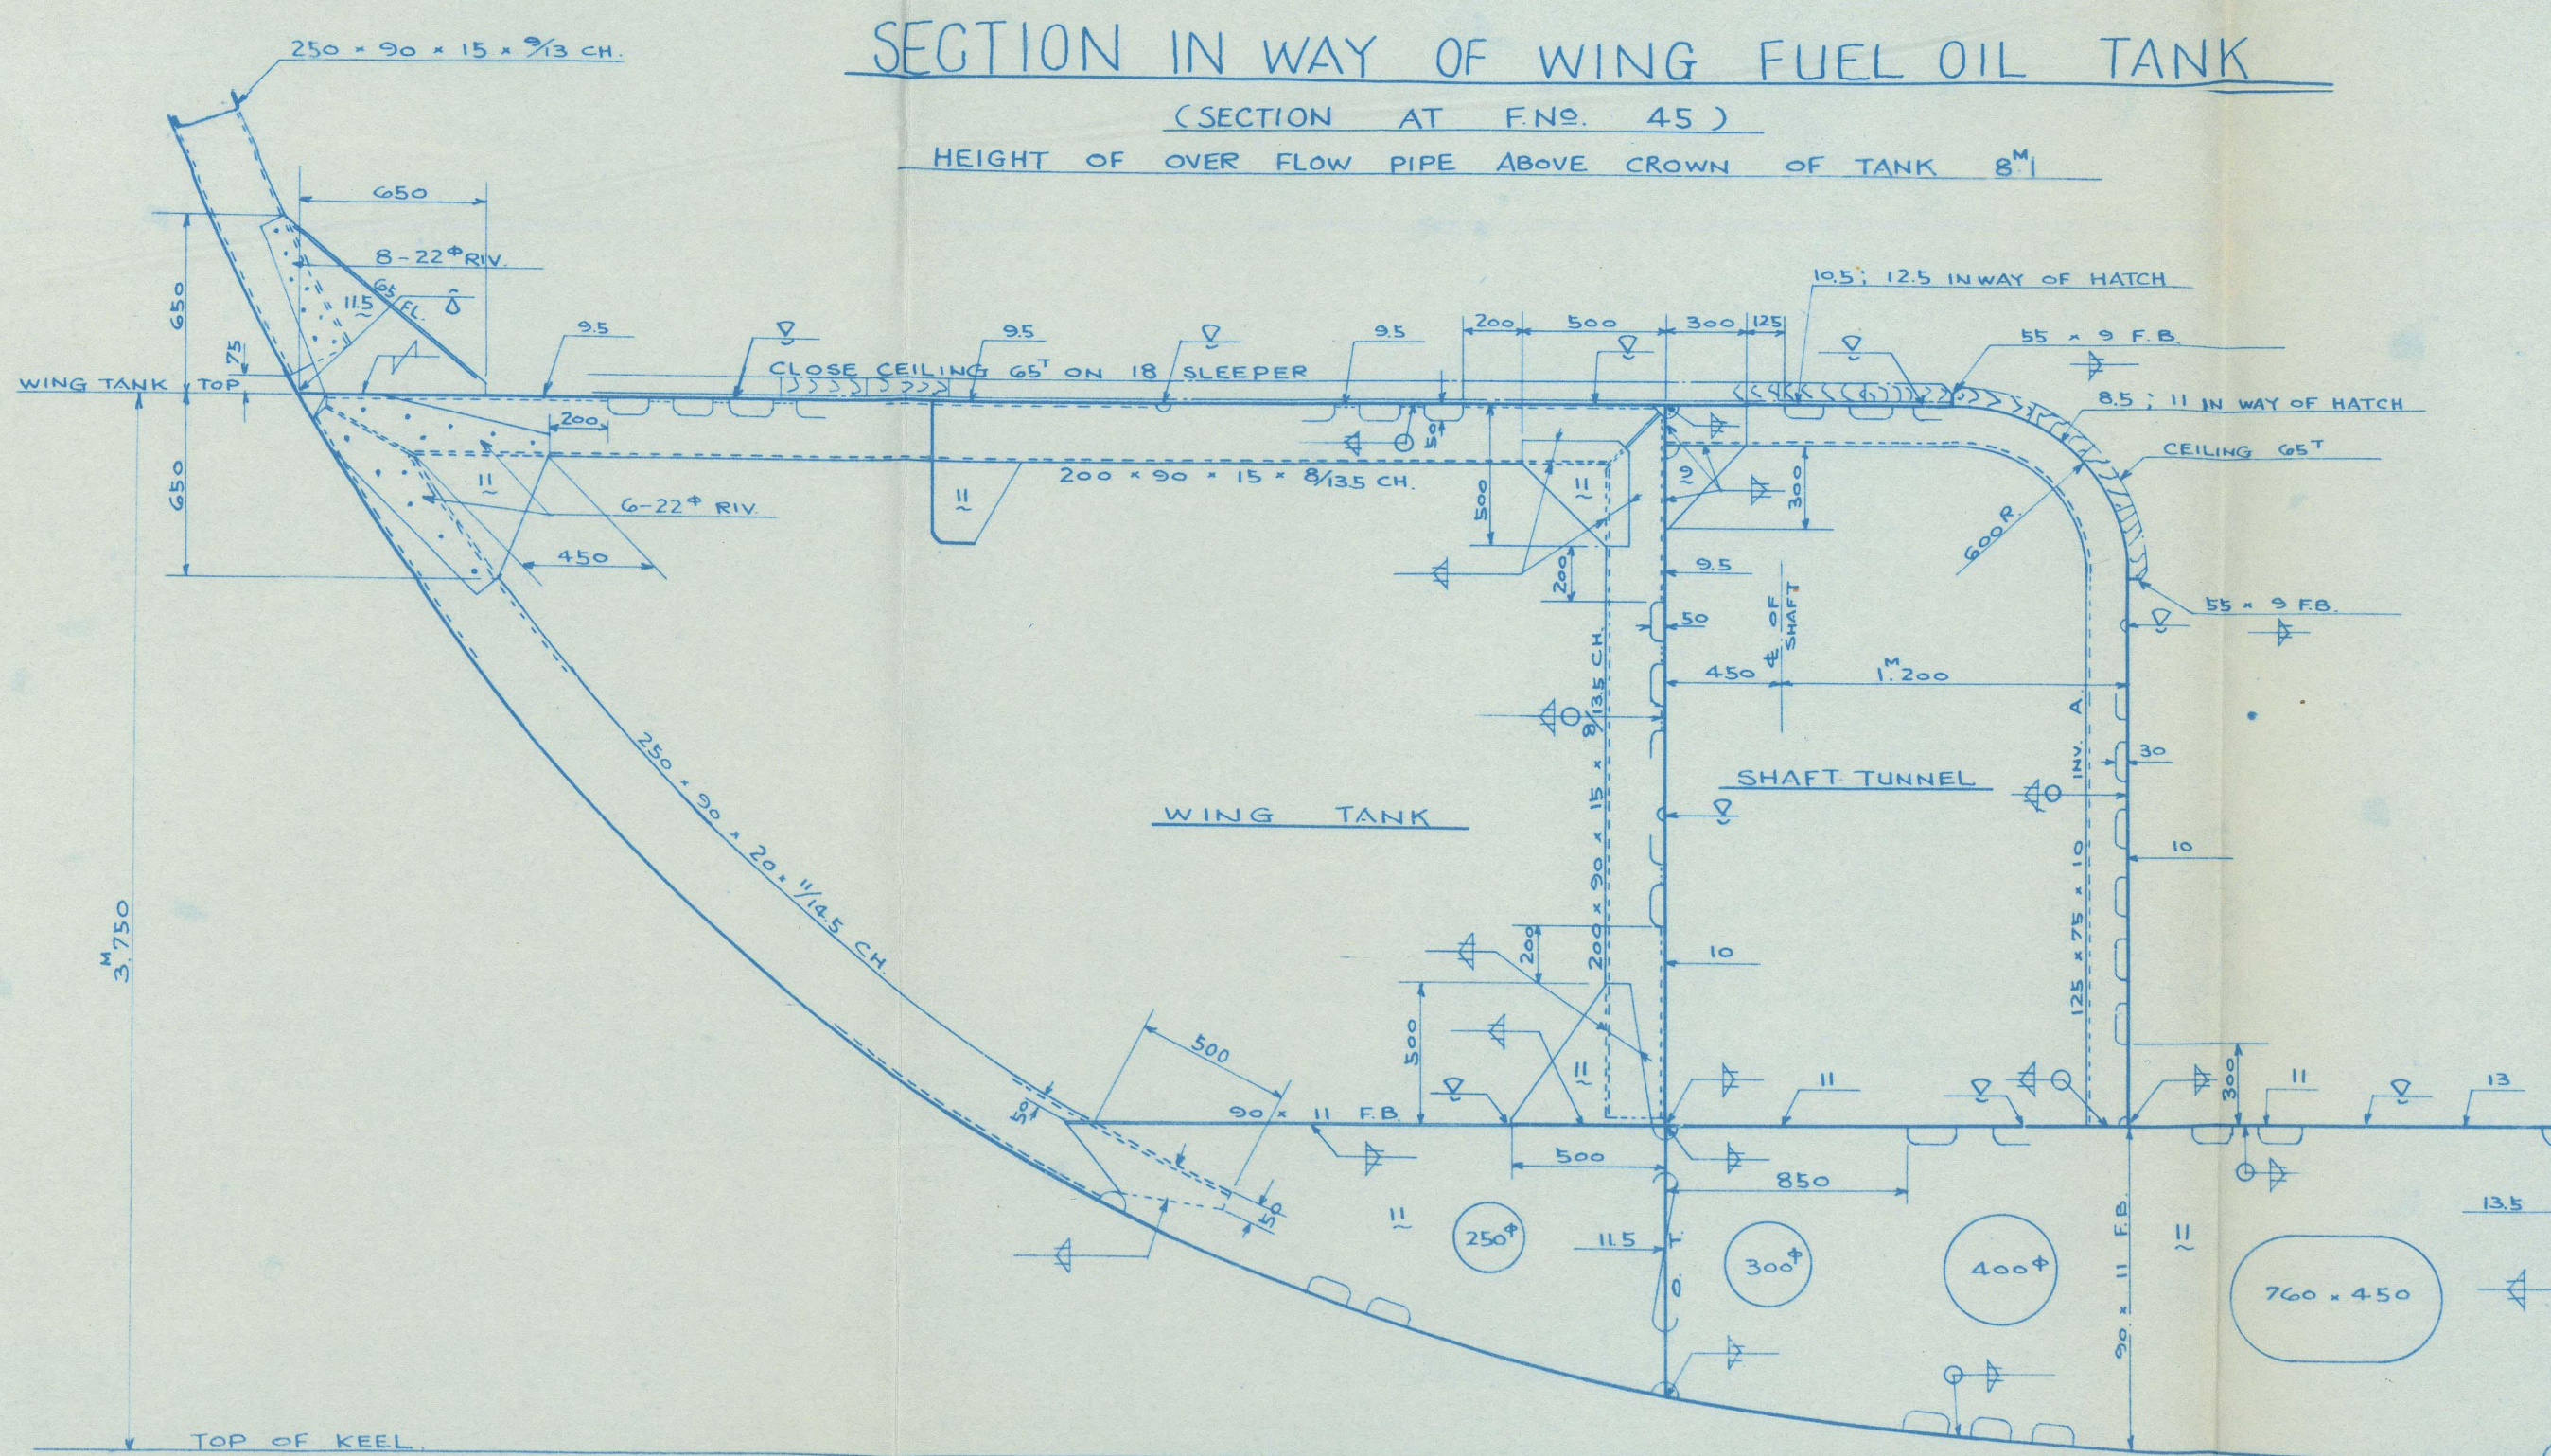
L.R. CLASS	✚	100A1
N.K. CLASS		N.S. ✚

<u>EQUIPMENT</u>	<u>NUMBER</u>
L. (C. & D)	140 + (19 + 105)
FCLE	112 + 23 + 75
BRIDGE	616 + 245 + 75
POOP	71 + 23 + 75
BRIDGE DE HOUSE	244 + 235 + 30
UPP DEH DE HOUSE	302 + 745 + 30
BOAT DE HOUSE	264 + 245 + 30
METRIC UNIT 4 379.8	
ENGLISH = 47.158	

<u>PRINCIPAL</u>		<u>DIMENSIONS</u>	
LENGTH	P.P.	140' 00"	(45' 31")
BREADTH	M/L	19 00	(62 34')
DEPTH	TO UPPER DE	10 50	(34 48)
DEPTH	TO BRIDGE DE	12 05	(42 49)
DRAFT	6' FROM TOP OF KEEL	8 37	(27 53)
<u>FRAME SPACE</u>			
BOTH PEAKS		600	
71' FROM FORE END ~ COLL. BMD		650	
ELSEWHERE		800	

(SECTION AT F.NO. 45)

HEIGHT OF OVER FLOW PIPE ABOVE CROWN OF TANK 8"

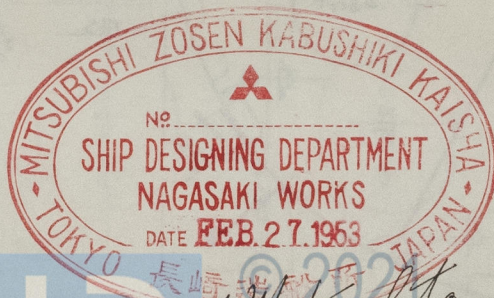
SHIP NO. 1430.
DON NO. 15 © 2021

"ARITA MARU" ★

Midship section. (Finished plan).

RECORDS DEPT.
LONDON

5



Lloyd's Register
Foundation