
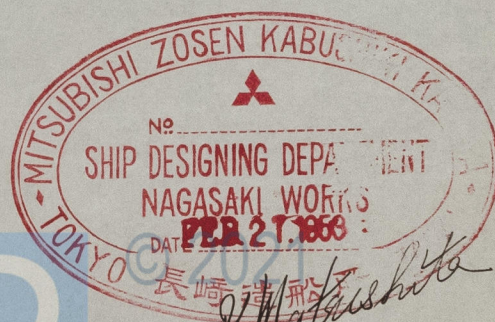


Lloyd's Register
Foundation

"ARITA MARU" ★

Construction profile & deck plan (sheet 1).
(finished plan).

RECORDS DEPT.
LONDON

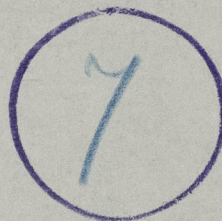

Lloyd's Register
Foundation