

# PROPOSED S.S. STEAMER.

## DIMENSIONS: 300' x 44' x 24'-3"

### LONGITUDINAL SECTION.


CLASS B S\* WITH FREEBOARD

Scale:  $\frac{1"}{8}$  = one foot.



16 APR 1926

Approved in 9.7.16.  
See Cont 14/4/26.

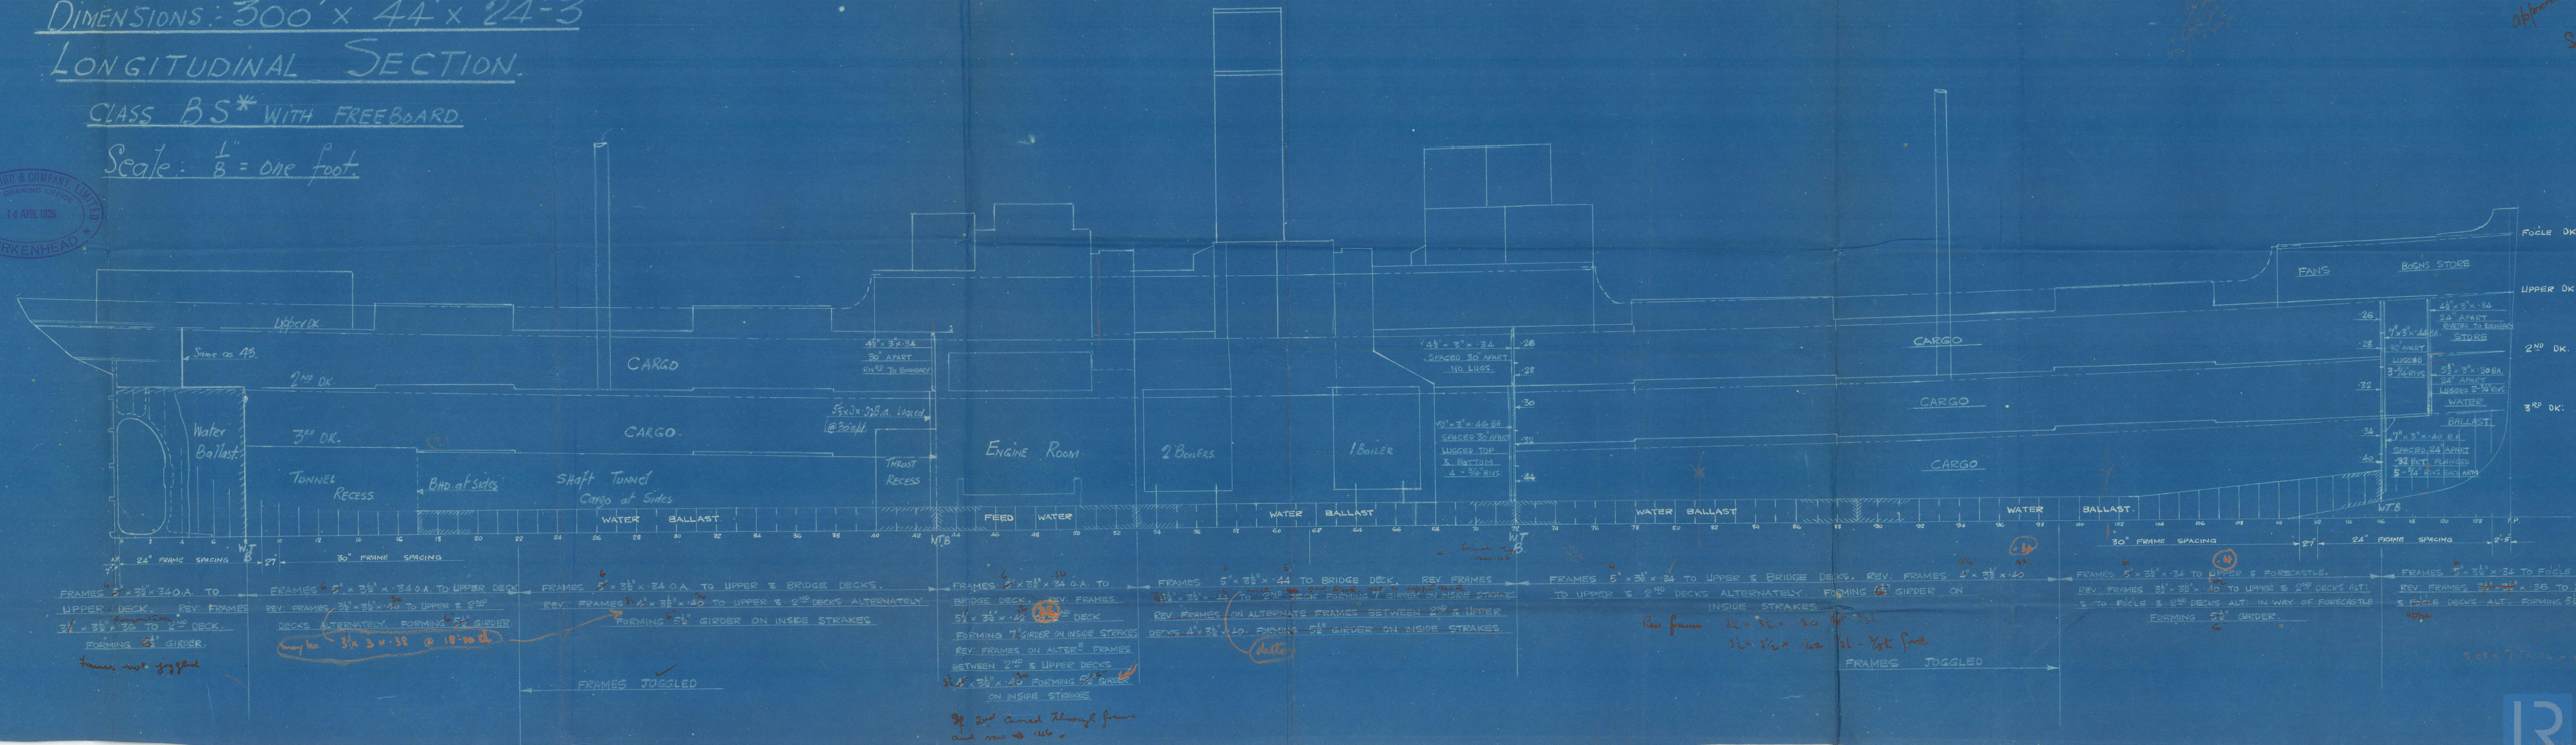



Preliminary Profile

Cammell Laird & Co.

Nº Q25.

18 " 18 - 26

"Original"

Sorry no later plan available.



© 2021

Lloyd's Register  
Foundation

014325-014334-0142



Longitudinal Section

Messers Cammell -  
Laird.

Prop. S.S. 300' x 44' x <sup>25"</sup>24-3



© 2021

Lloyd's Register  
Foundation



Longitudonal Section.

Messers Cammell Laird

Prop. SS. 300' x 44' x 24'-3"

now: No 925.

S/S. "Argual"

proposed plan.



© 2021

Lloyd's Register  
Foundation

