






Nº 925.

CONSTRUCTIONAL DECK PLANS.

SCALE $\frac{1}{8}" = 1 \text{ FOOT.}$

1 MAY 1906

The British Corporation
DATE 30 April 1906
SHIP DEPARTMENT

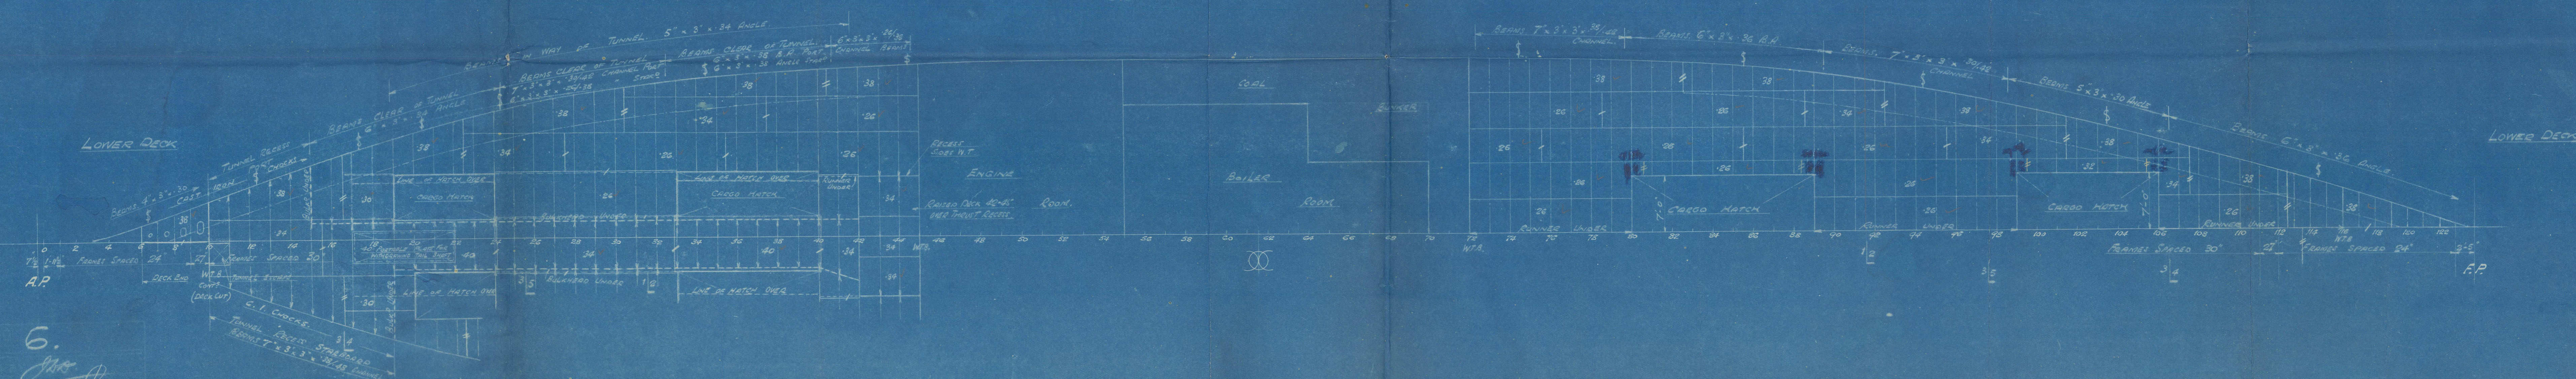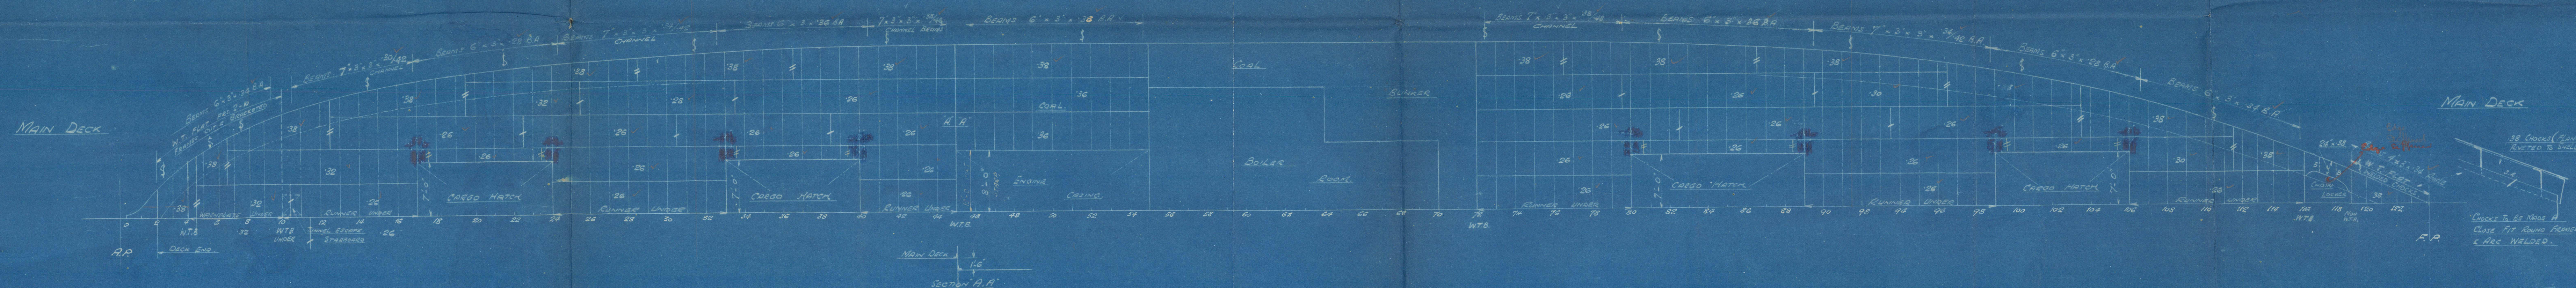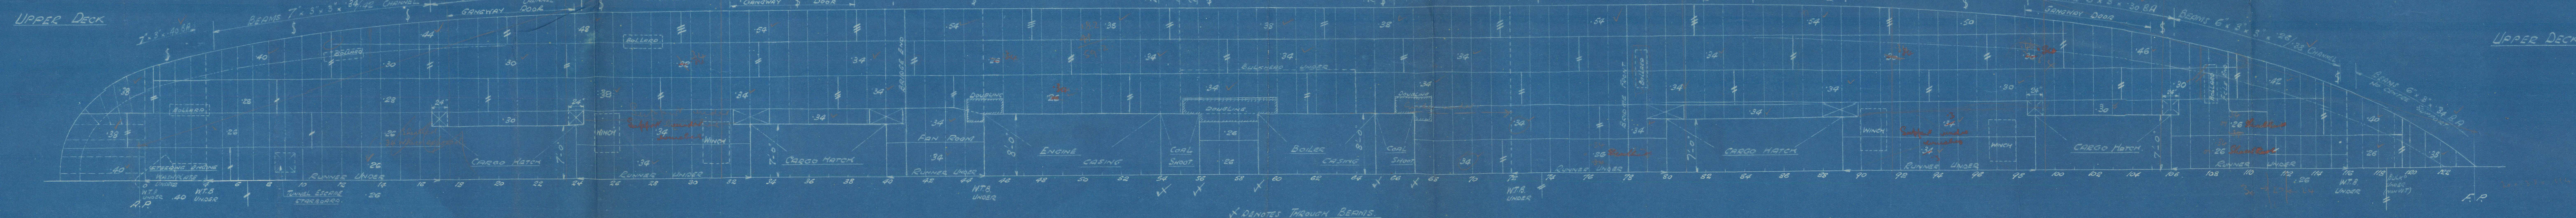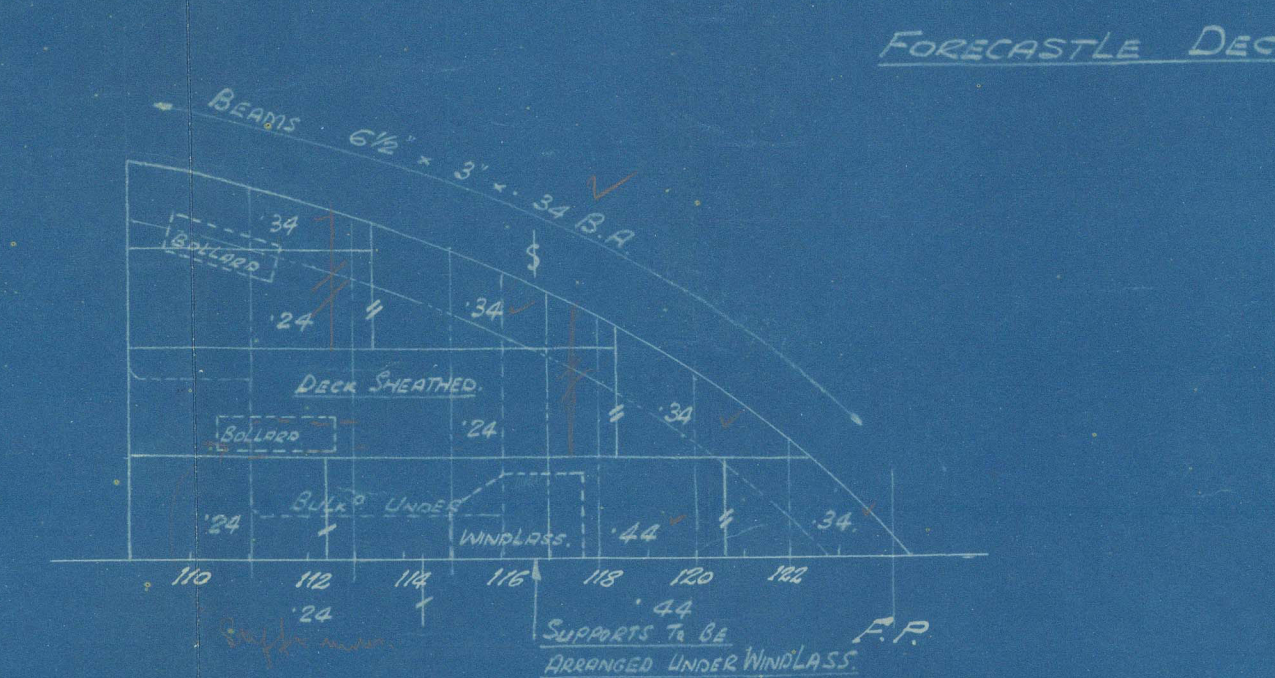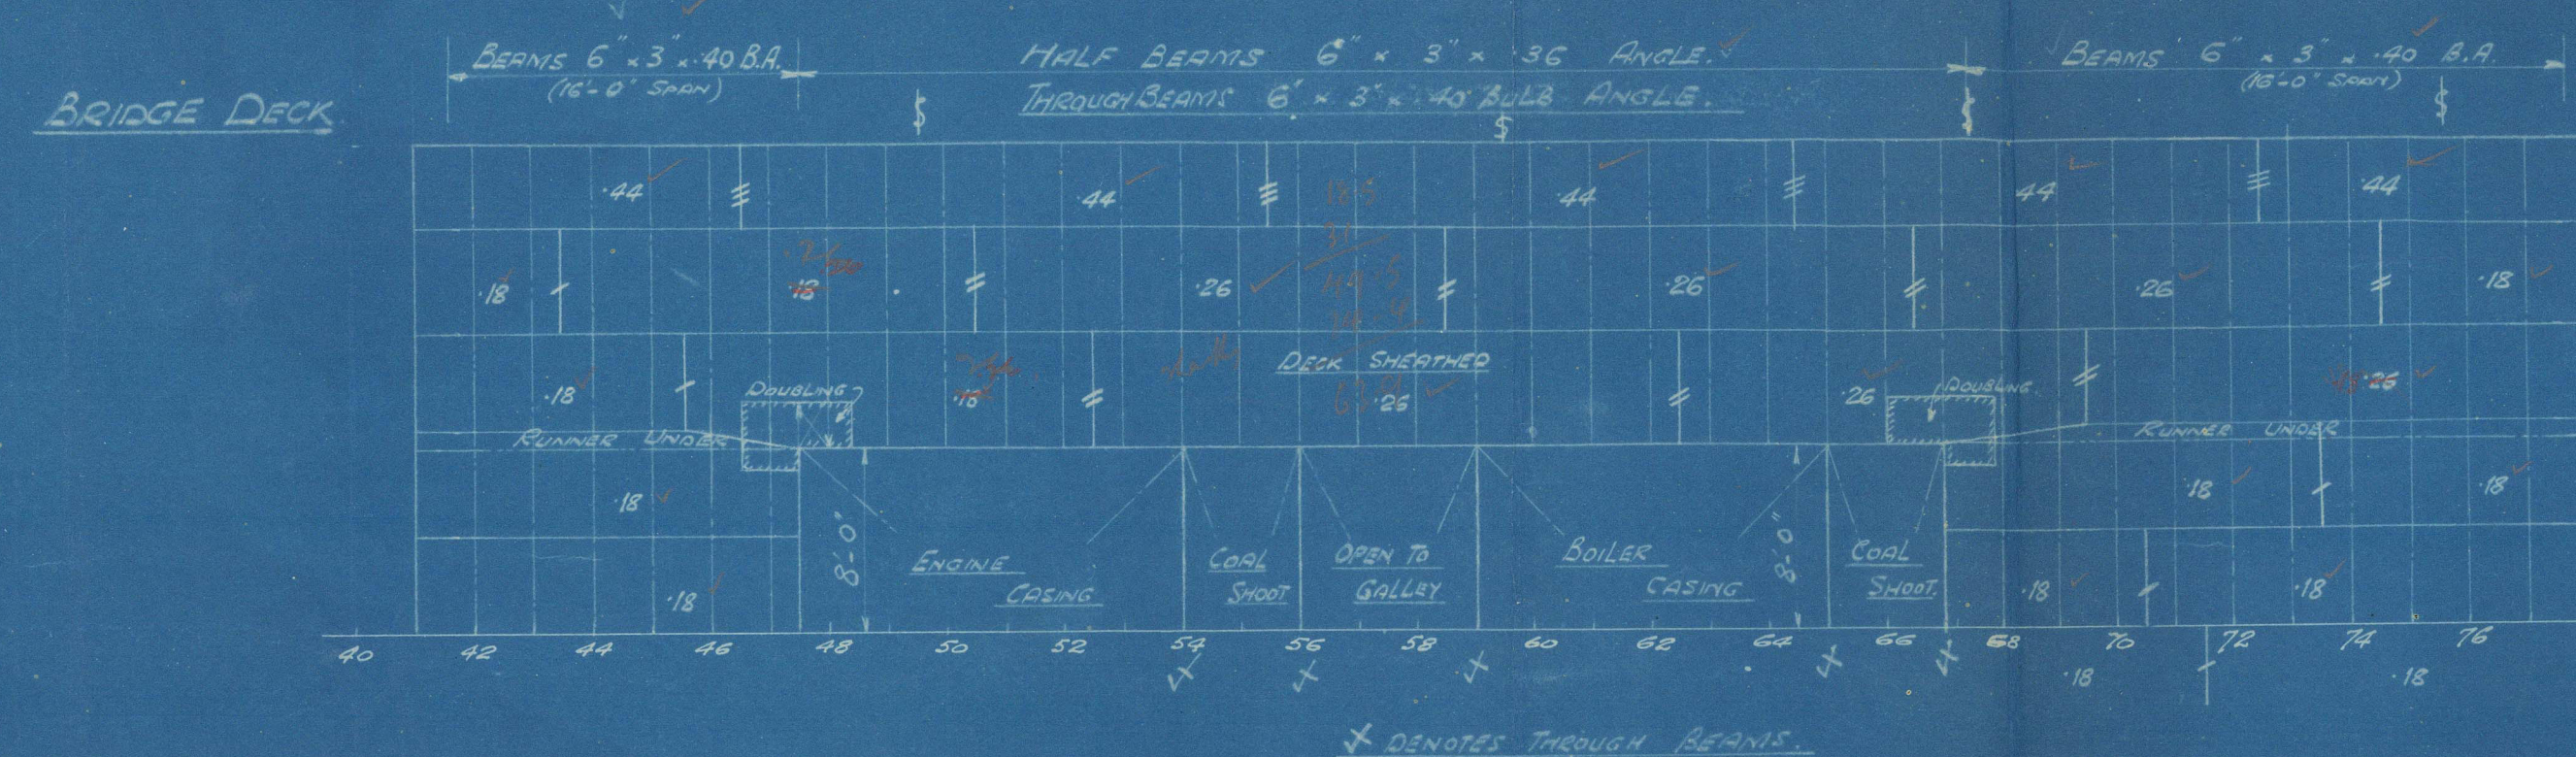

6.
J.H.

8

Und. Deck Plan.

Cammell Laird & Co.

N^o 925.

3 - 5 - 26.

"Argual"



© 2021

Lloyd's Register
Foundation

014325-014334-0143

8



© 2021

Lloyd's Register
Foundation

No.

CON.

SCALE

CAMMELL LAIRD
FOR ENCLOSURE
The British Corps
DATE 30th April
SHIP DEPART

UPPER D.

8.

Constil. Decks Plan.

(Amd.)

Cammell Laird & Co.

925

3 - 5 - 26

1000
1/5 "Original"

