

RE. APPROVED 10 MARCH 51.

EQUIPMENT.

BOWER ANCHOR	-	3 1/2 CWT. STOCKLESS
30 FATHOMS	-	3/4" CHAIN CABLE
DOUBLE PURCHASE HAND WINDLASS		
1	-	25 FATHOMS 4" CIRC. SISAL
1	-	25 " " " COIR
2	-	15 " " " COIR
1	-	60 " " " SISAL
1	-	CARLEY FLOAT (3 MEN CAPACITY)
2	-	30" CORK LIFEBOYS

MOTOR TANK BARGES.

No. W.S. 1047-8. 63-65.

SCANTLING SECTIONS.

~ PARTICULARS. ~

LENGTH BP.	51'-0"
LENGTH O.A. (APPROX)	54'-0"
BREADTH MLD.	14'-6"
DEPTH MLD.	7'-6"
SHEER FWD.	9" ~ SHEER AFT 9"

CLASSIFICATION.


LLOYDS HIGHEST REQUIREMENTS FOR CANAL & ESTUARY SERVICE. TO BE ENGAGED IN THE CARRIAGE OF PETROLEUM & PETROLEUM PRODUCTS IN BULK.

CLASS: A.1. BARGE. CARRYING PETROLEUM IN BULK FOR CANAL & ESTUARY SERVICE.

TESTING.

WATER TESTS THROUGHOUT TO THE REQUIREMENTS OF LLOYD'S SURVEYOR. (TANKS TO BE TESTED TO 2'-0" ABOVE TOP OF TRUNK.)

FOR DETAILS OF EXPANSION TRUNK WELDING SEE DRAWG. NO. 2004 "MODIFIED EXPANSION TRUNK".

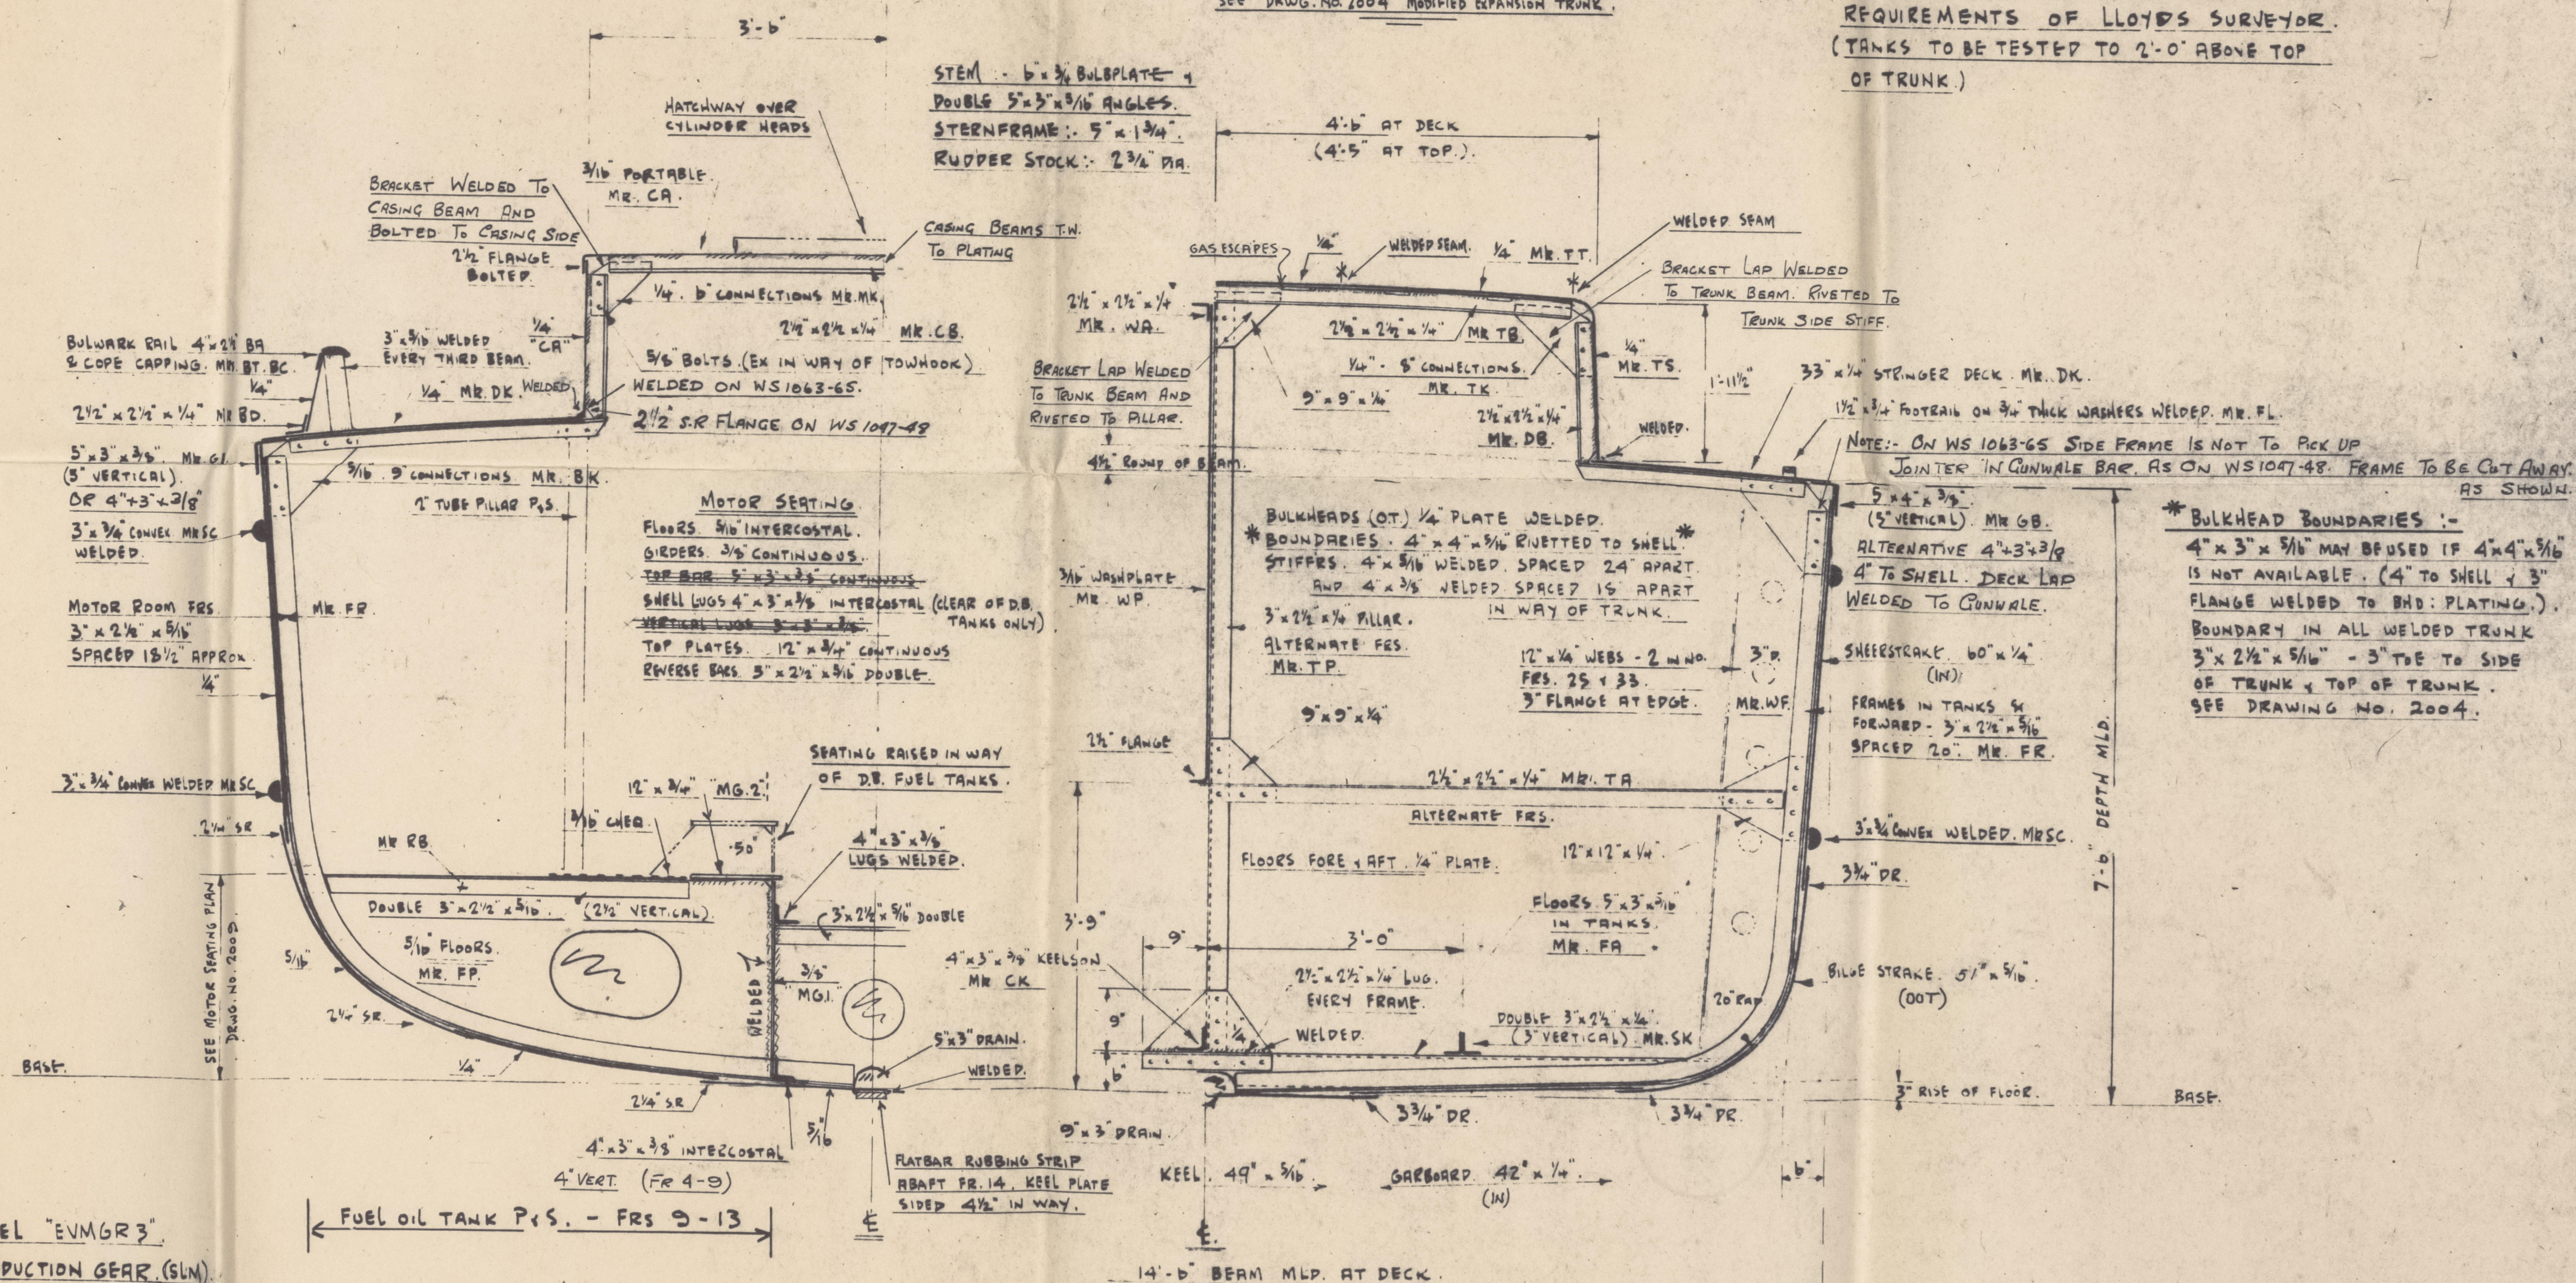

MACHINERY.

SINGLE LISTER DIESEL MODEL "EVMGR3"
120 BHP @ 600 RPM WITH 2:1 REDUCTION GEAR (SLN).
TAILSHAFT REVS. 300 :- SPEED 8 KNOTS.

SECTION THRO' MOTOR ROOM.

FOR DETAILS SEE MOTOR SEAT PLAN.
- DRAWING NO. 2009. -

SECTION THRO' TANKSPACE.

SCALE: 3/4" = 1 ft.

SHIP NO. WS. 1047-8. 63-65.		DRG. NO. 2015.	
2.	DRAWN	TITLE	
1.	CHECKED	SCANTLING SECTIONS.	
1.	TRACED	SCALE: 3/4" = 1 ft.	TYPE: MOTOR TANK BARGE
JAMES W. COOK & CO (WIVENHOE) LTD.			
10.3.51.			
APPROVED BY LLOYD'S SURVEYOR 24.1.51			
014372-014381-0094			

Swallow c




Messrs. James. W. Cook (Wivenhoe) Ltd.

Yard Nos 1063-4-5.

" Scantling Sections "

RECORDS DEPT.
LONDON

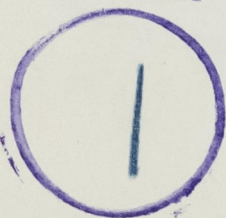

© 2021

Lloyd's Register
Foundation

014372-014381-0054