

NOTE				
MANUF. NO.	NO. WANTED	DATE	REMARK	
MAY. 11 1963 DRAWN				

# CLASS

L.R. 100A1 "PATROL BOAT" & LMC

## PRINCIPAL DIMENSIONS

LENGTH (B.P.)	44.00
BREADTH (MID.)	7.50
DEPTH (MID.)	3.45
DRAFT (MID.) DESIGNED	2.135
FRAME SPACE	600

## EQUIPMENT NUMBER BY LLOYD'S RULE

FOR THE HULL

$$4.4(7.5+2.35)+0.85 \times 4.4(3.45-2.35) = 433.4 + 4.14 = 474.44$$

FOR ERECTION

$$\text{UPPER DECK HOUSE} \quad 0.75(2.3 \times 22.4) = 38.64$$

$$\text{NAV. BRIDGE HOUSE} \quad 0.75(2.3 \times 9.2) = 11.88$$


$$\text{EQUIPMENT NUMBER} \quad 524.96$$

## EQUIPMENTS

BOWER ANCHOR (STOCKLESS)	1 x 9cm - 18x5 - 0.165
STREAM ANCHOR (WITH STOCK)	1 x 9cm - 18x5 (EX STOCK)
STUD LINK CHAIN CABLE (ELECTRICALLY WELDED OF SPECIAL STEEL)	1 x 24# x 302.85M
STREAM WIRE (6x12 FLEXIBLE STEEL WIRE)	1 x 22# x 100M
TOW LINE (6x12 FLEXIBLE STEEL WIRE)	1 x 22# x 100M
HAWSER (MANILA ROPE)	1 x 4# x 165M


## FINISHED PLAN

B NO OF MFRS	A PART NO	NAME OF PART	MATERIAL	UNIT WEIGHT KG	REMARK
POLISI 505			THE GOV. OF THE REPUBLIC OF INDONESIA 390 <sup>t</sup> PATROL BOAT		
MIDSHIP			SECTION		
			SCALE 1/25		
HITACHI SHIPBUILDING & ENGINEERING CO. LTD. MUKAISHIMA SHIPYARD DESIGNING SECTION			DRAWN BY S. Naparinic CHECKED BY M. Topya REVIEWED BY S. Naparinic		
DATE MAY. 11, 1963		RELATED SECTION	CHIEF OF SECT. Haparinic		
MANUF NO		SHEET NO		FINAL- 16	
CODE NO		DRAWING NO		101290	

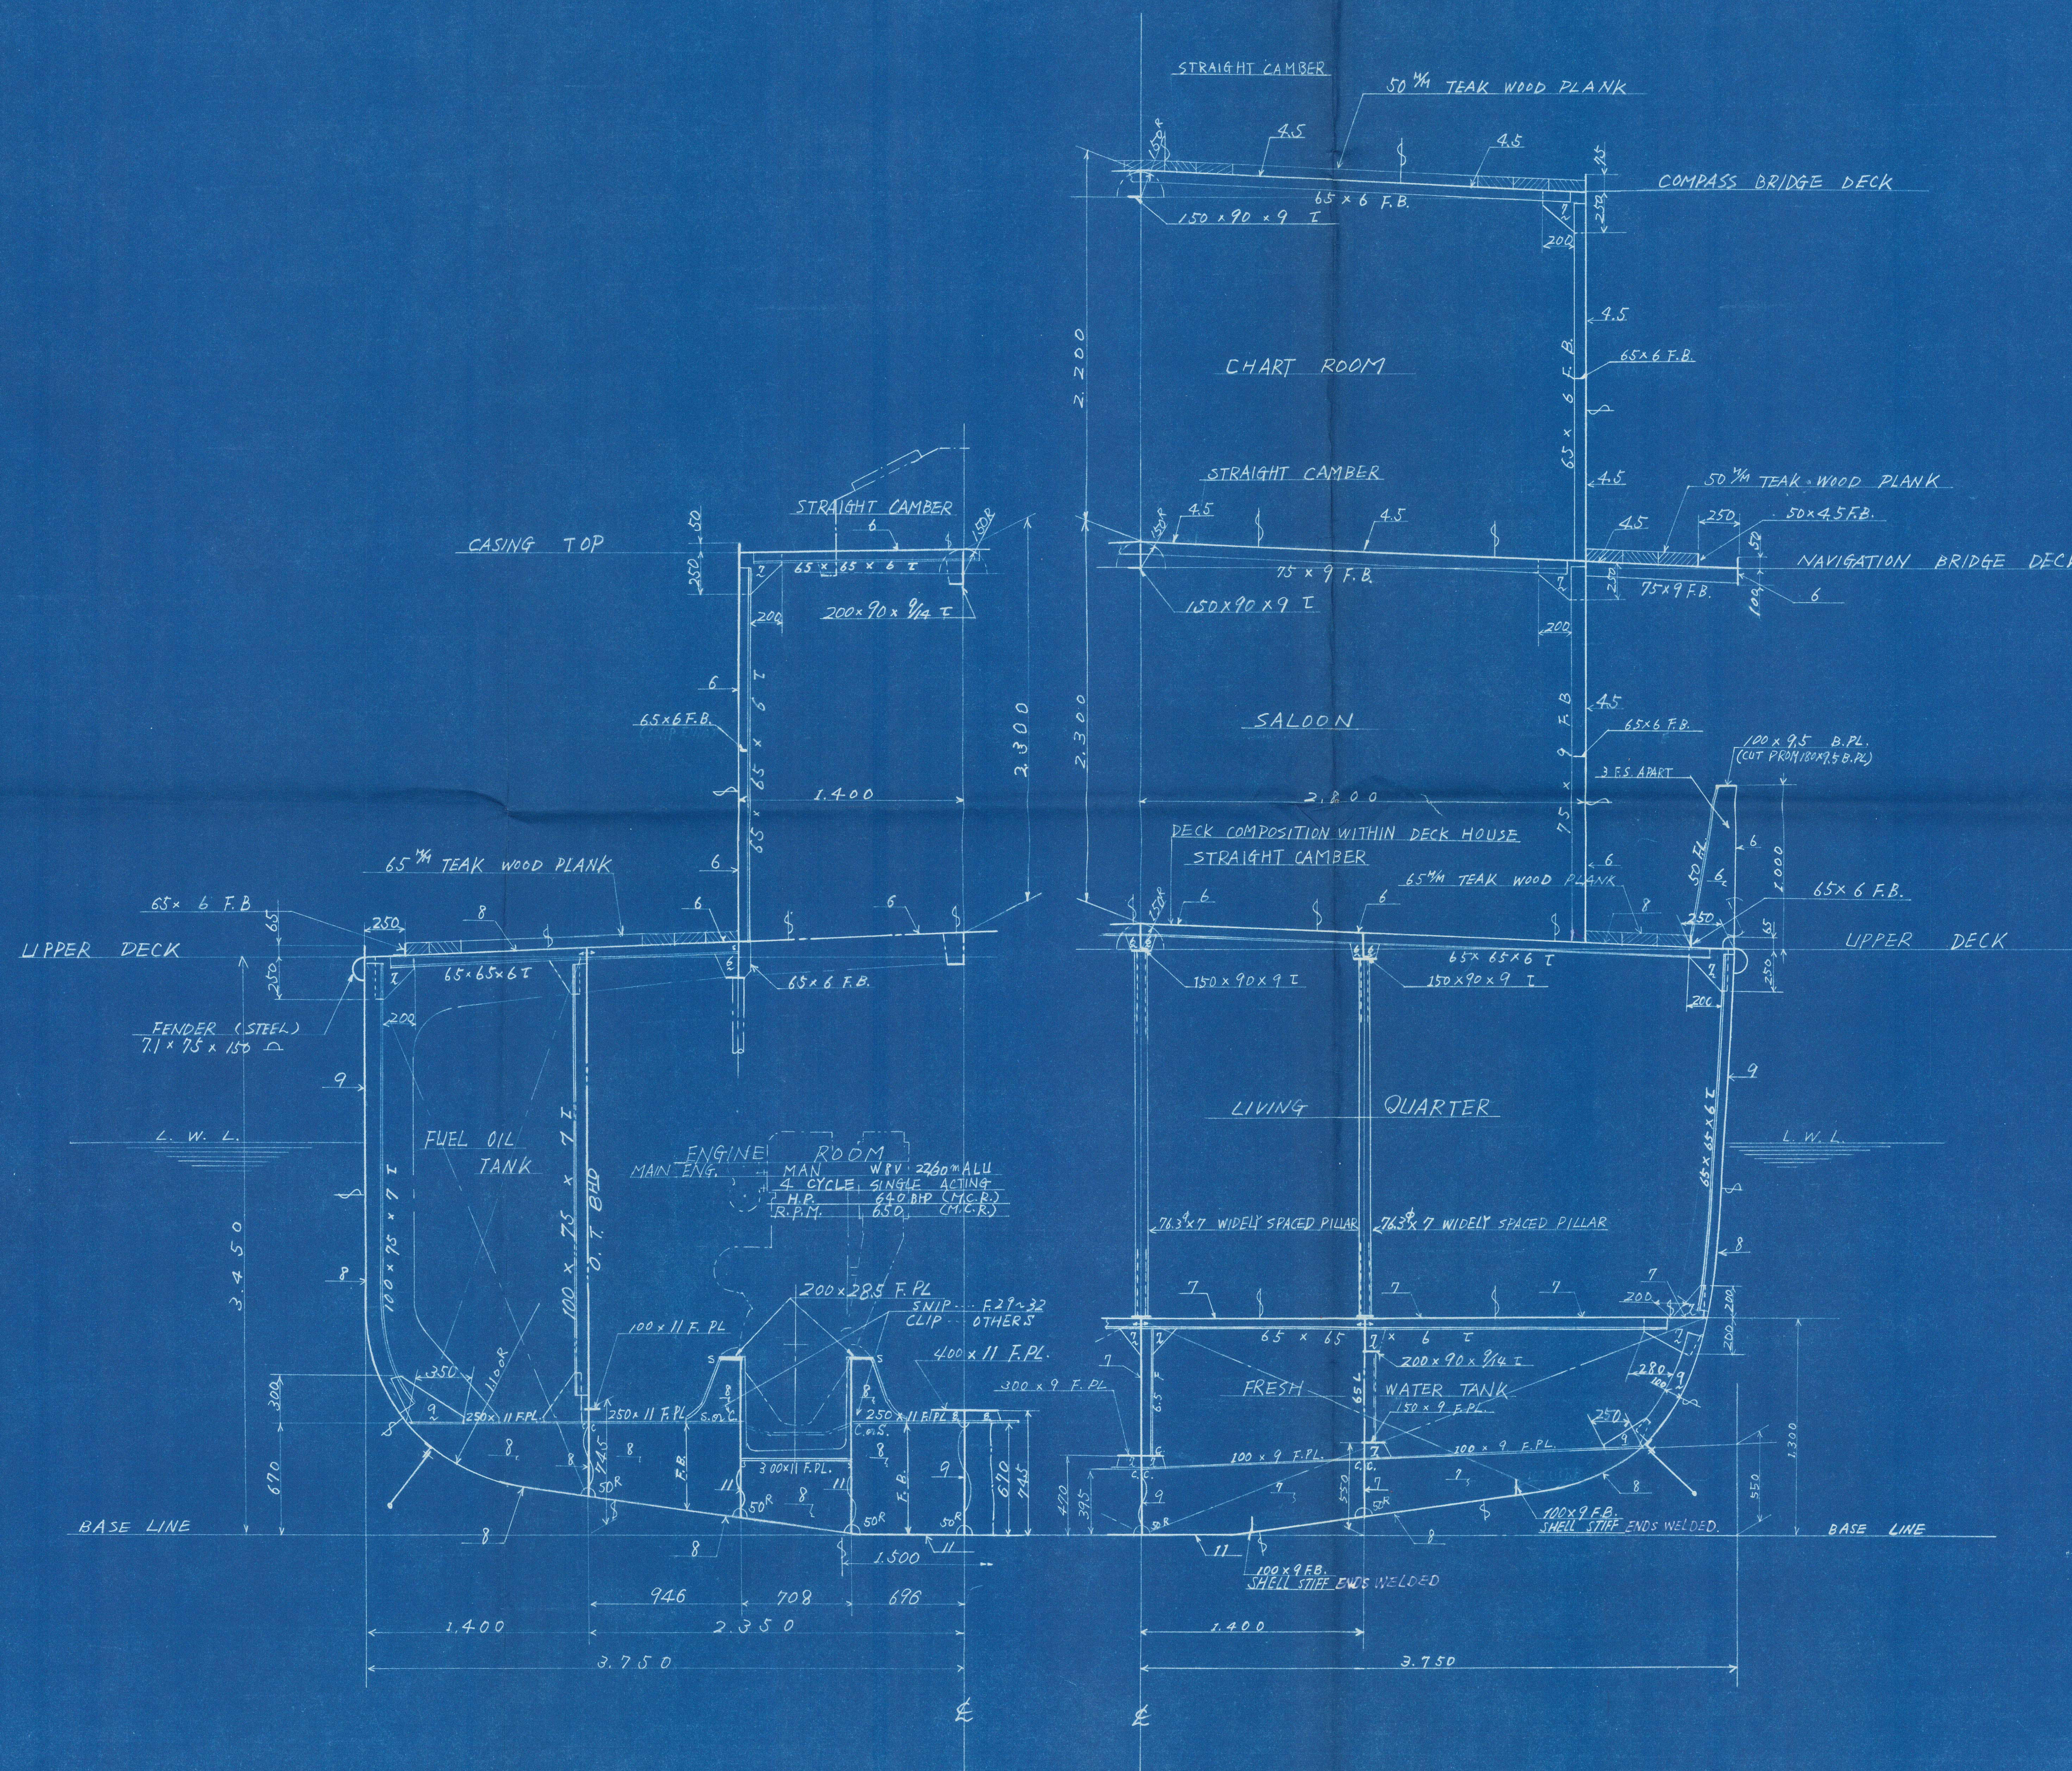



RECORDS DEPT.  
LONDON.

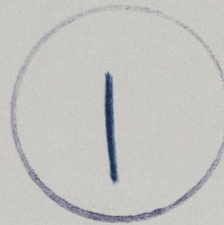

Kobe Rpt. No.	11678
Port of Survey.	MUKAISHIMA
Name of Ship.	POLISI 505
Title of Plan.	MIDSHIP SECTION



© 2021

Lloyd's Register  
Foundation