



B. D. STEENBOK

PROFILE & DECKS

DUMB BOW WELL CENTRE LADDER BUCKET DREDGER

TO LLOYDS CLASS 100A.1 * DREDGER

RESTRICTED SERVICE

SCANTLINGS 10% IN EXCESS OF LLOYDS (THK. ONLY)

SCALE: $\frac{1}{4}'' = 1'-0''$

DIMENSIONS: -

172'-0" B.P. x 36'-6" MLD. x 13'-3" MLD.


M.L.D. DRAFT - 8'-3"

EQUIPMENT TO OWNERS REQUIREMENTS

- 1 BOWER ANCHOR 40 CWTs.
- 1 STERN ANCHOR 25 CWTs.
- 4 SIDE ANCHORS 20 CWTs. EACH
- 300 FMS. $\frac{1}{2}''$ BOW CHAIN (B.S.S. SHORT LINK) IN 15 FM.
- 200 FMS. $\frac{1}{4}''$ STERN CHAIN (B.S.S. SHORT LINK) LENGTHS
- 4 - 250 FMS. 6 x 37 x 7 HEMP CORE 3 CIRC. GALV. F.S.W.R.


MAIN DECK

W T FLATS

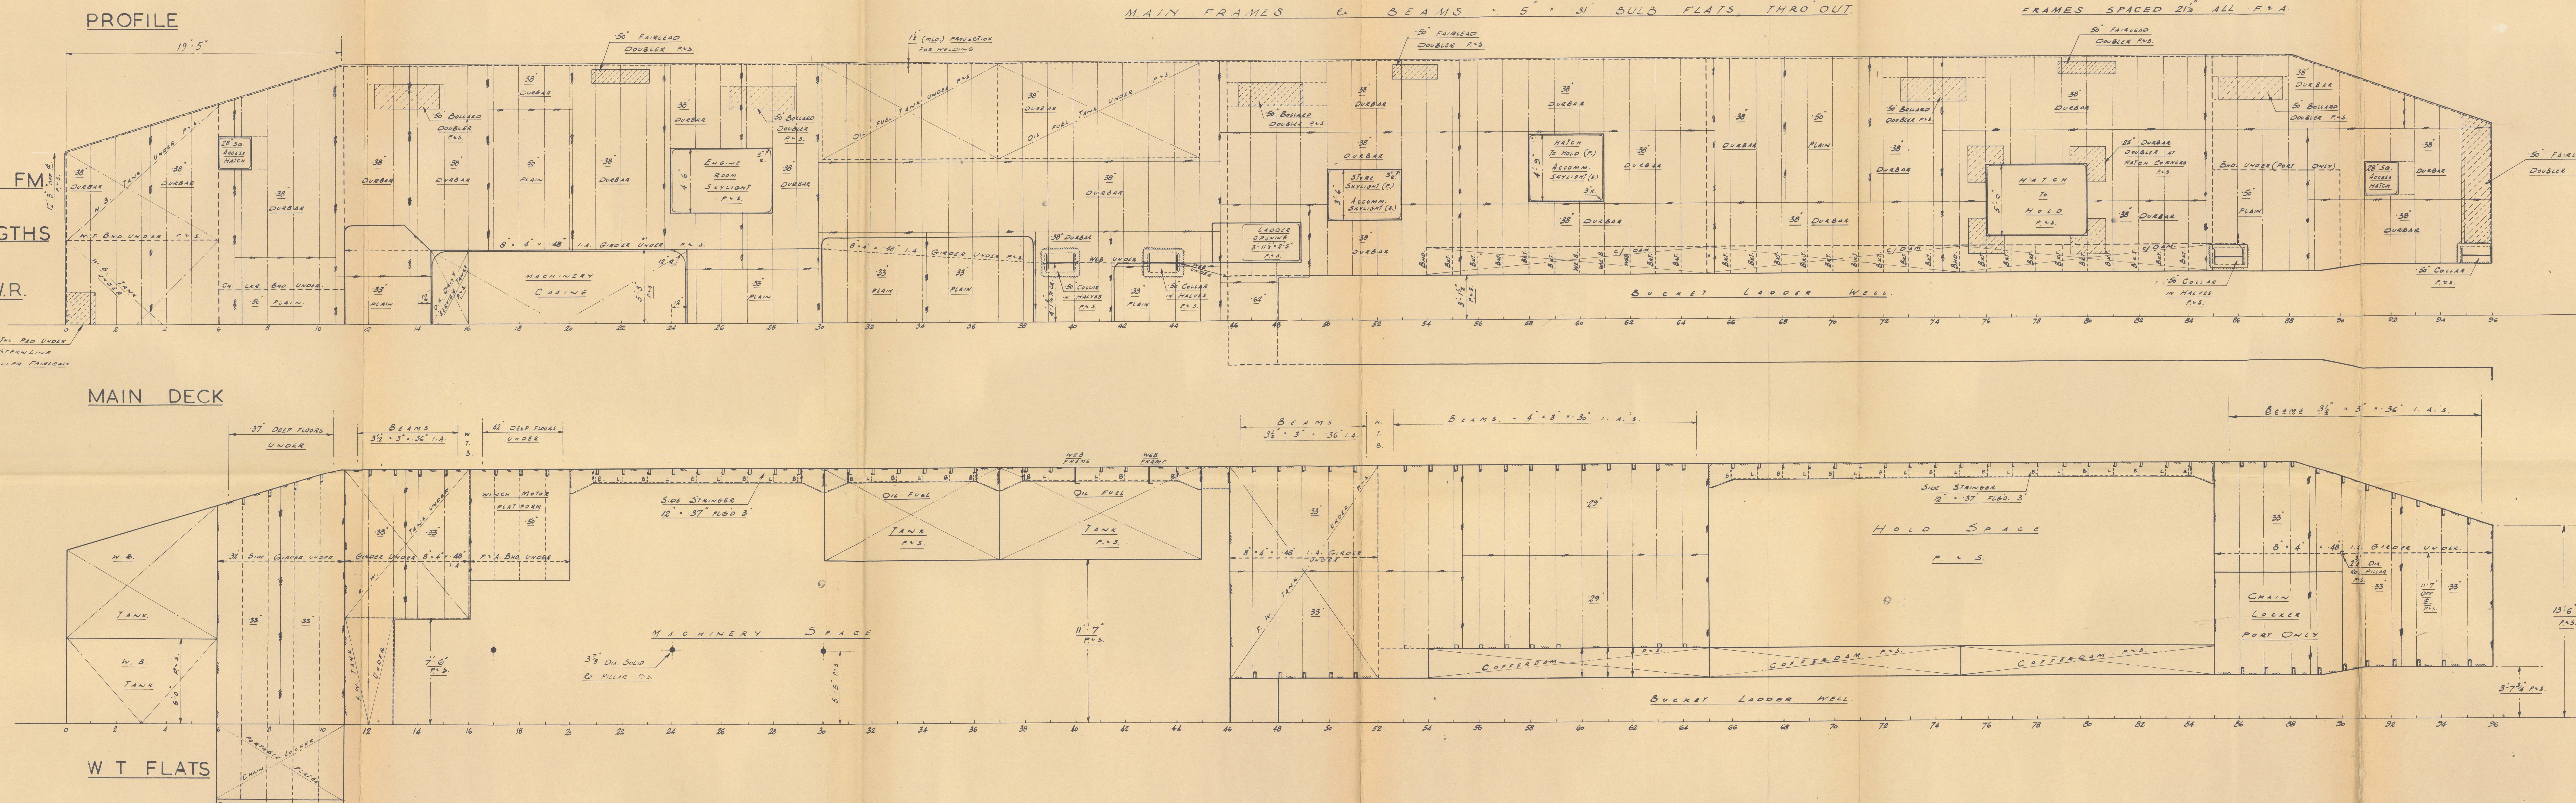

ACCOMMODATION DECK

ACCOMMODATION HOUSE TOP

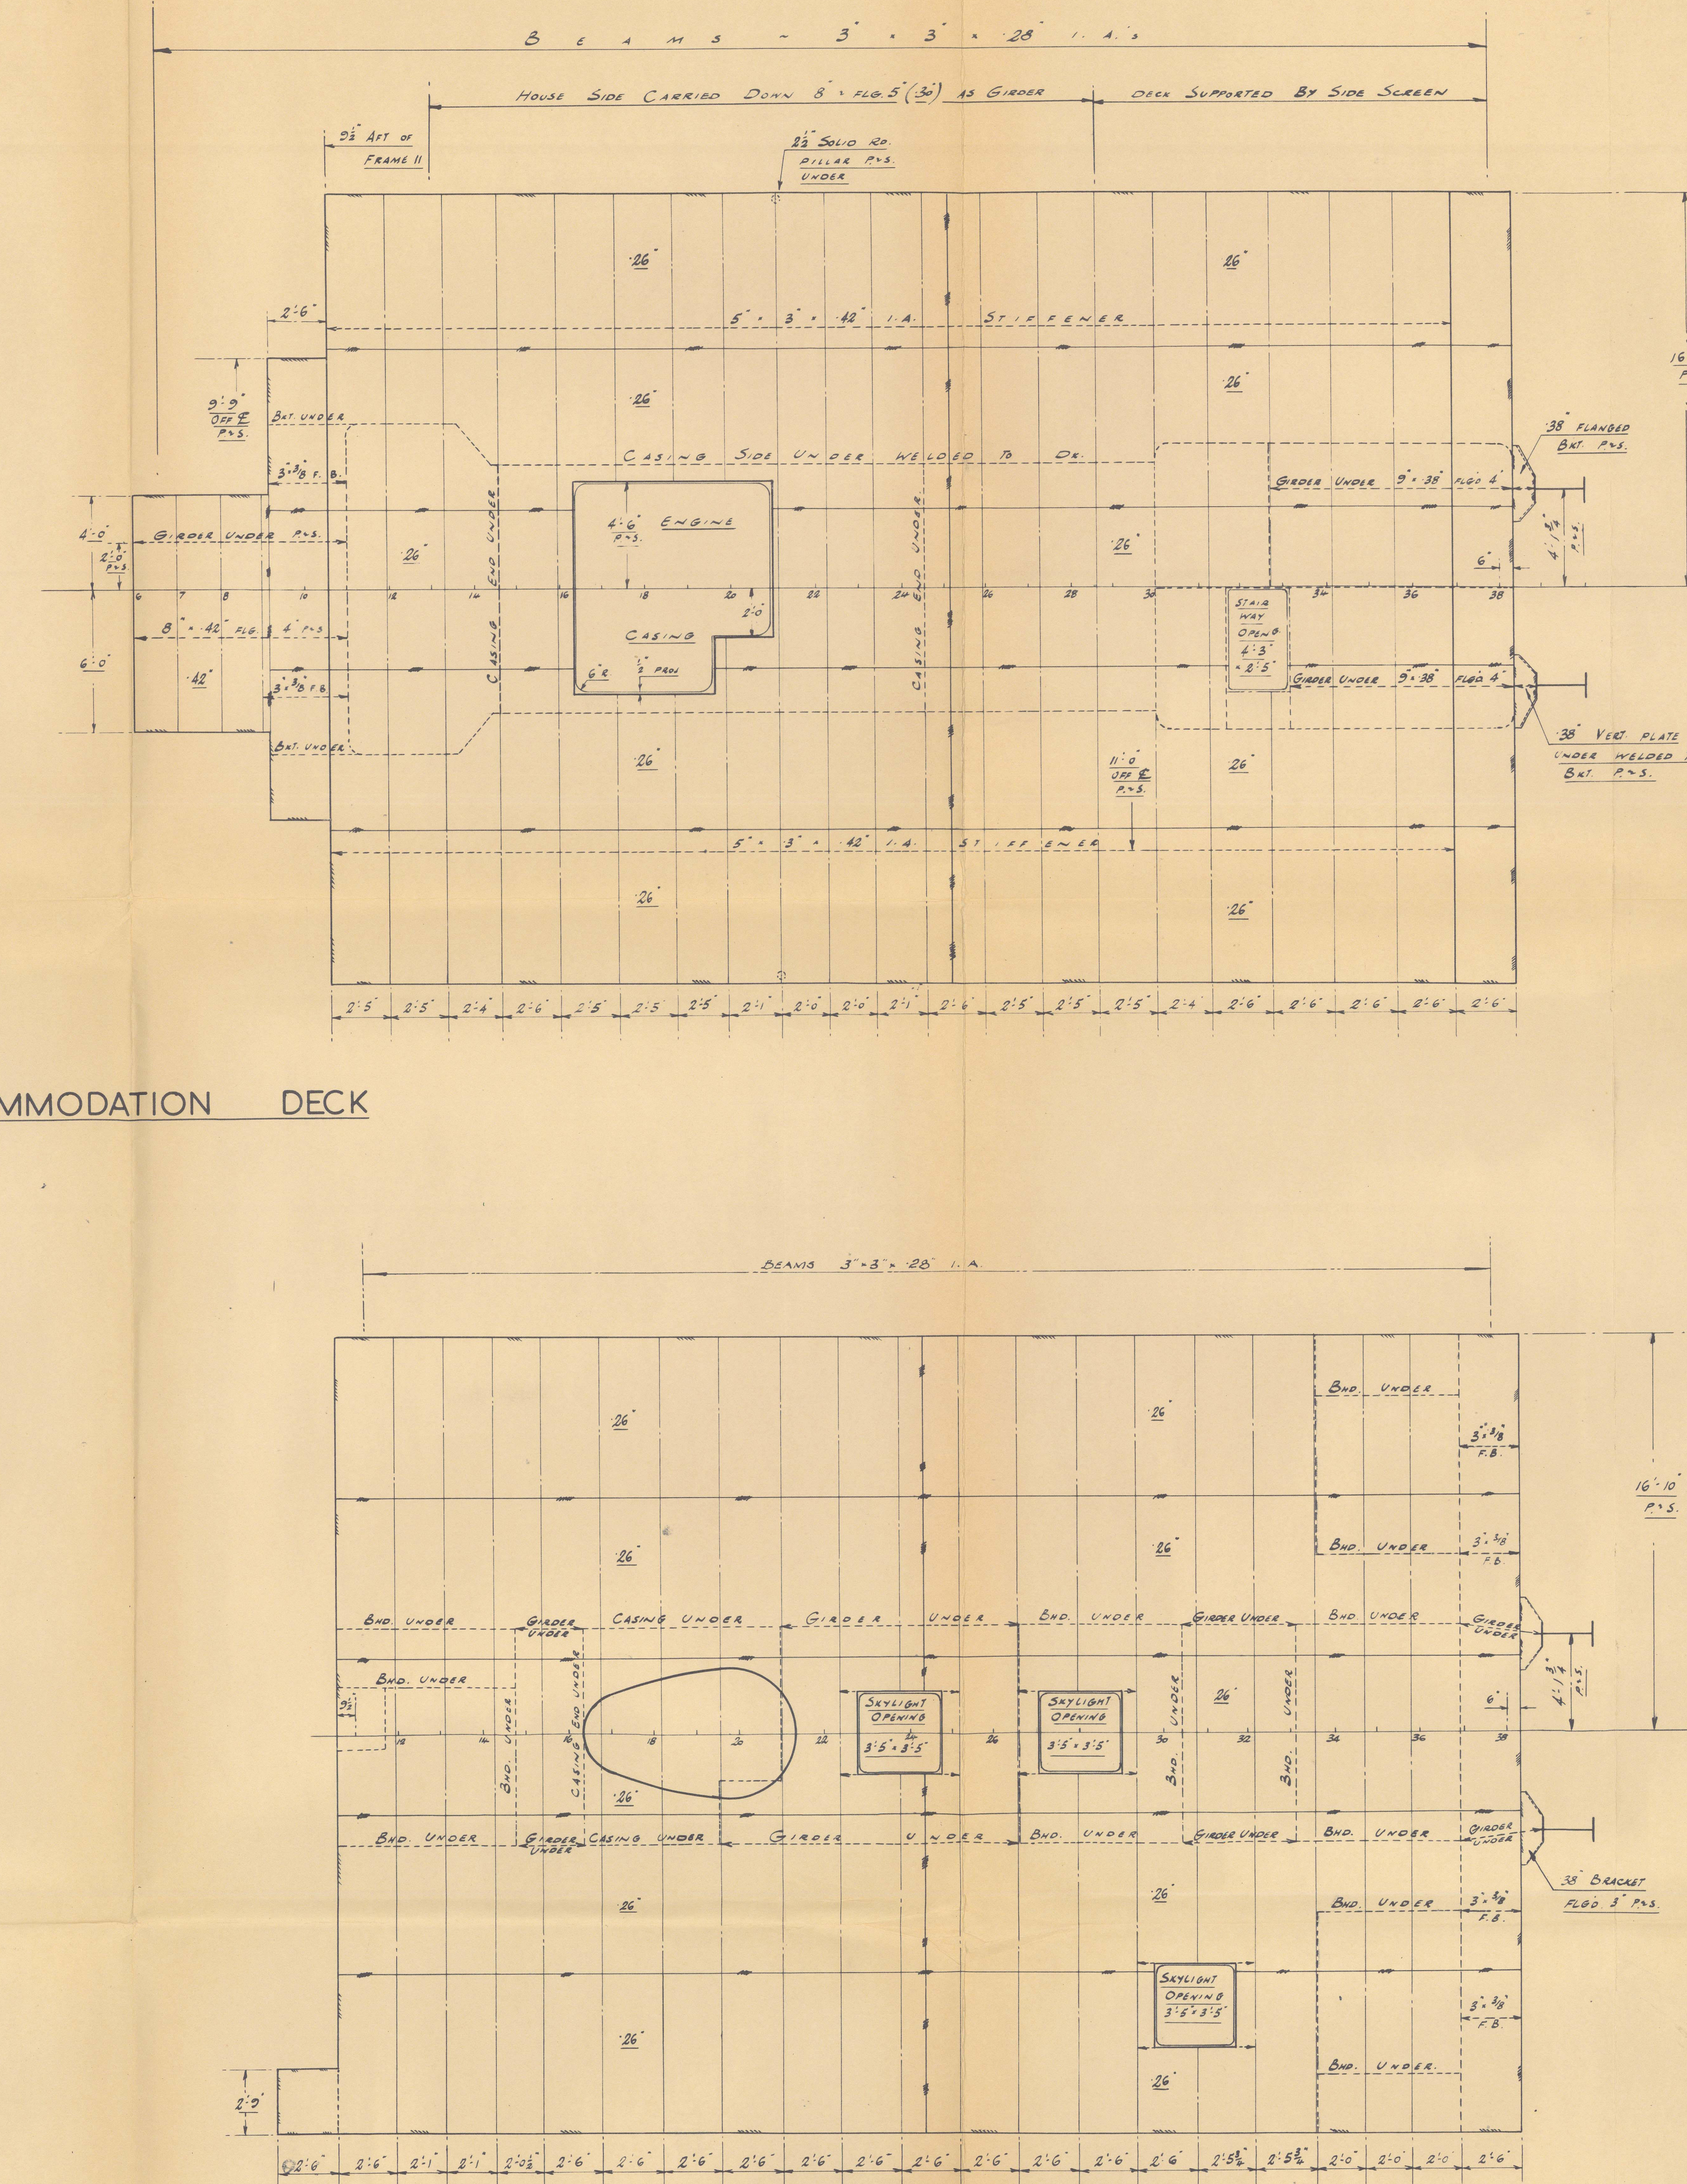

SOUTH AFRICAN RAILWAYS
SUID-AFRIKAANSE SPOORWEE
BESTELLING N° J.C. 3971 J. E.M. REF.
CONTRACT FOR BUCKET DREDGER
KONTRAKT VOOR BAKKER STEENBOK
CONTRACTORS NAME: FERGUSON BROS. (PORT GLASS) LTD.
KONTRAKTEURSENAAM: FERGUSON BROS. (PORT GLASS) LTD.
CONTRACTORS DRAWING
KONTRAKTEURSTEKENING N° 227
S.A. 11/5/57
S.A.S. TOEGEKENDE NT

PROFILE & DECKS


SCALE: $\frac{1}{4}'' = 1'-0''$

C.E. N° J 15957

CERTIFIED BY: J. D. STEENBOK

DATE: 1957

Lloyd's Register Foundation

"STEENBOK" 

FERGUSON BROTHERS LTD.

YARD No. 443.

PROFILE & DECKS.
("AS FITTED")

✓

RECORDS DEPT.
LONDON.

GREENOCK F.E. REPORT No. 27804


3

This plan has been verified with the approved plans, and includes any modifications and/or additions to the original approved arrangements made during construction which have been approved locally as being in accordance with or equivalent to LRS requirements.

Signature Thimothope

Surveyor(s) to Lloyd's Register of Shipping

Date 6th January, 1966

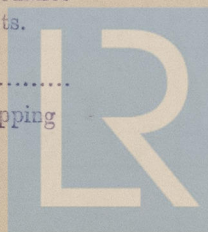

© 2021

Lloyd's Register
Foundation