



## B. D. "STEENBOK."


### HULL SECTIONS.

SCALE:  $\frac{1}{2}$ " = ONE FOOT.

DIMENSIONS:—

172'-0" B.P.  $\times$  36'-6" MLD.  $\times$  13'-3" MLD.

MLD DRAFT 8'-3".

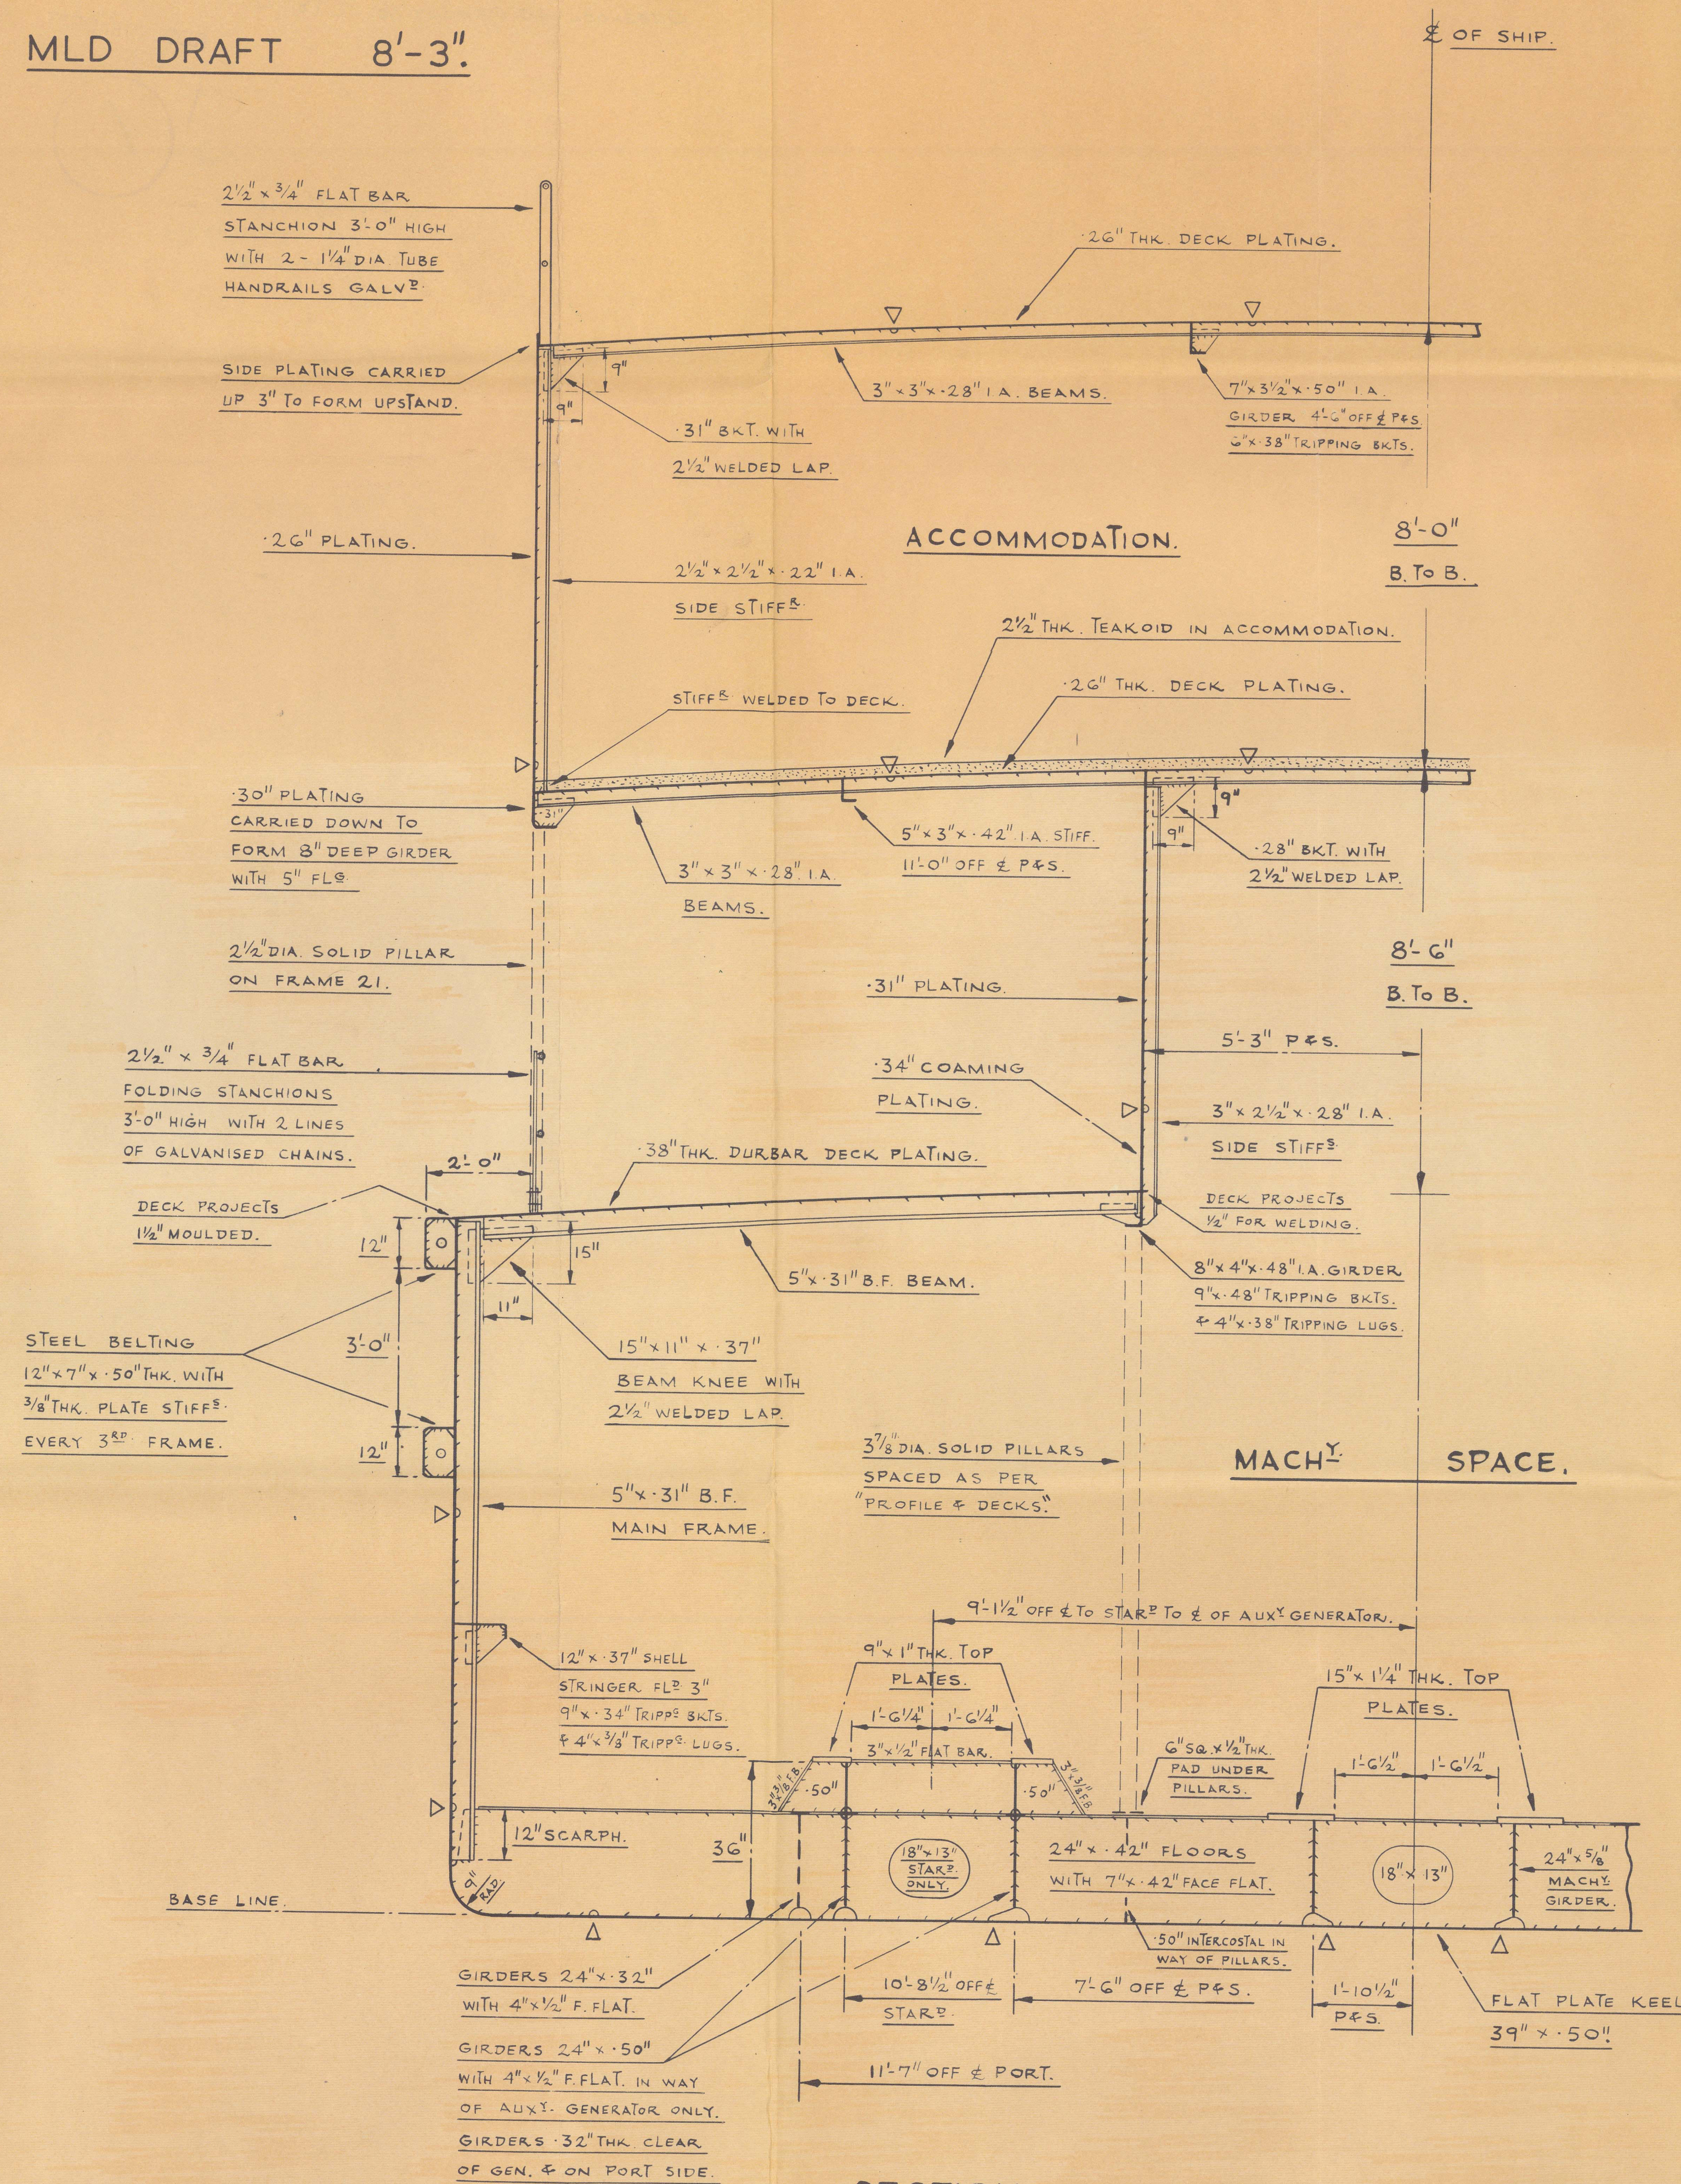

SECTION IN WAY OF MACHY SPACE.

DUMB BOW WELL CENTRE LADDER BUCKET DREDGER


TO LLOYDS CLASS 100 A1  $\times$  DREDGER.

RESTRICTED SERVICE.

SCANTLINGS 10% IN EXCESS OF LLOYDS. (THK. ONLY).

FRAMES SPACED 21 1/2" APART THROUGHOUT.

DECK CAMBER 9".

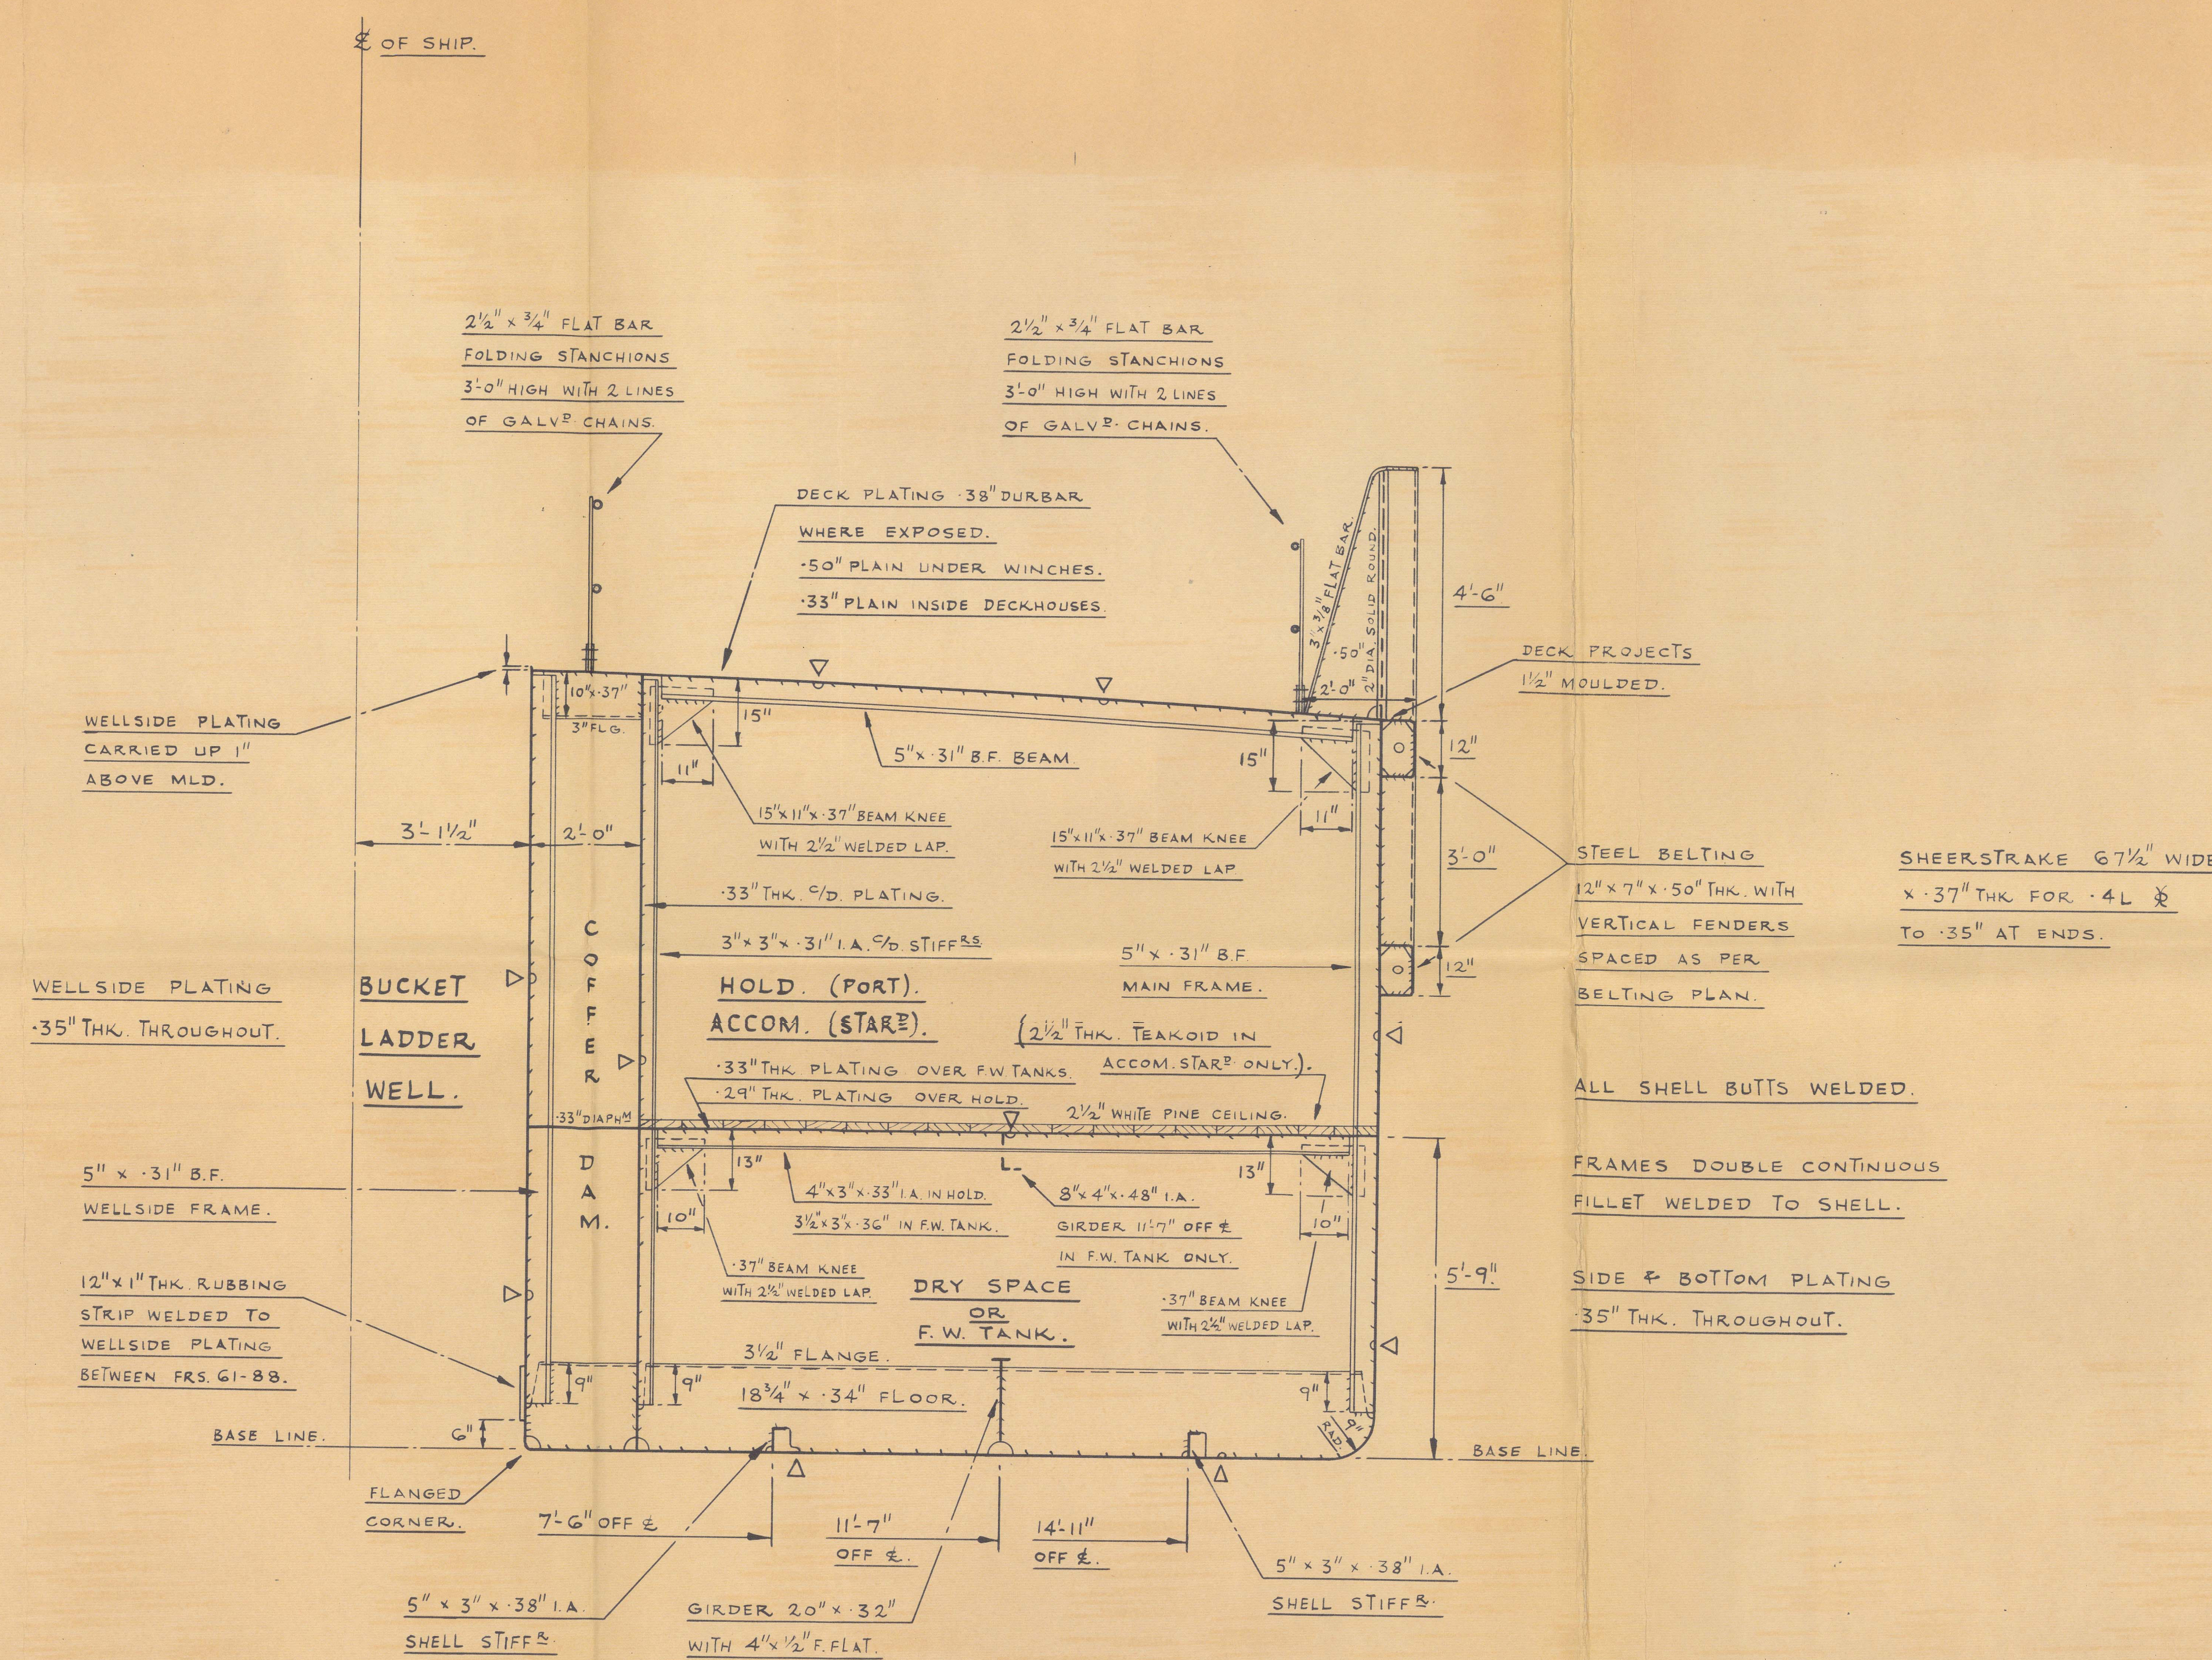

SECTION IN WAY OF LOWER DECK FLAT.

EQUIPMENT TO OWNERS REQUIREMENTS.

1 BOW ANCHOR 40 CWTs.


1 STERN ANCHOR 25 CWTs.

4 SIDE ANCHORS 20 CWTs.

300 FMS. 1 1/2" BOW CHAIN (B.S.S. SHORT LINK).

200 FMS. 1 1/4" STERN CHAIN (B.S.S. SHORT LINK).


4-250 FMS 6  $\times$  24  $\times$  7 HEMP CORE 3" CIRC. GALV<sup>D</sup> F. S. W. R.

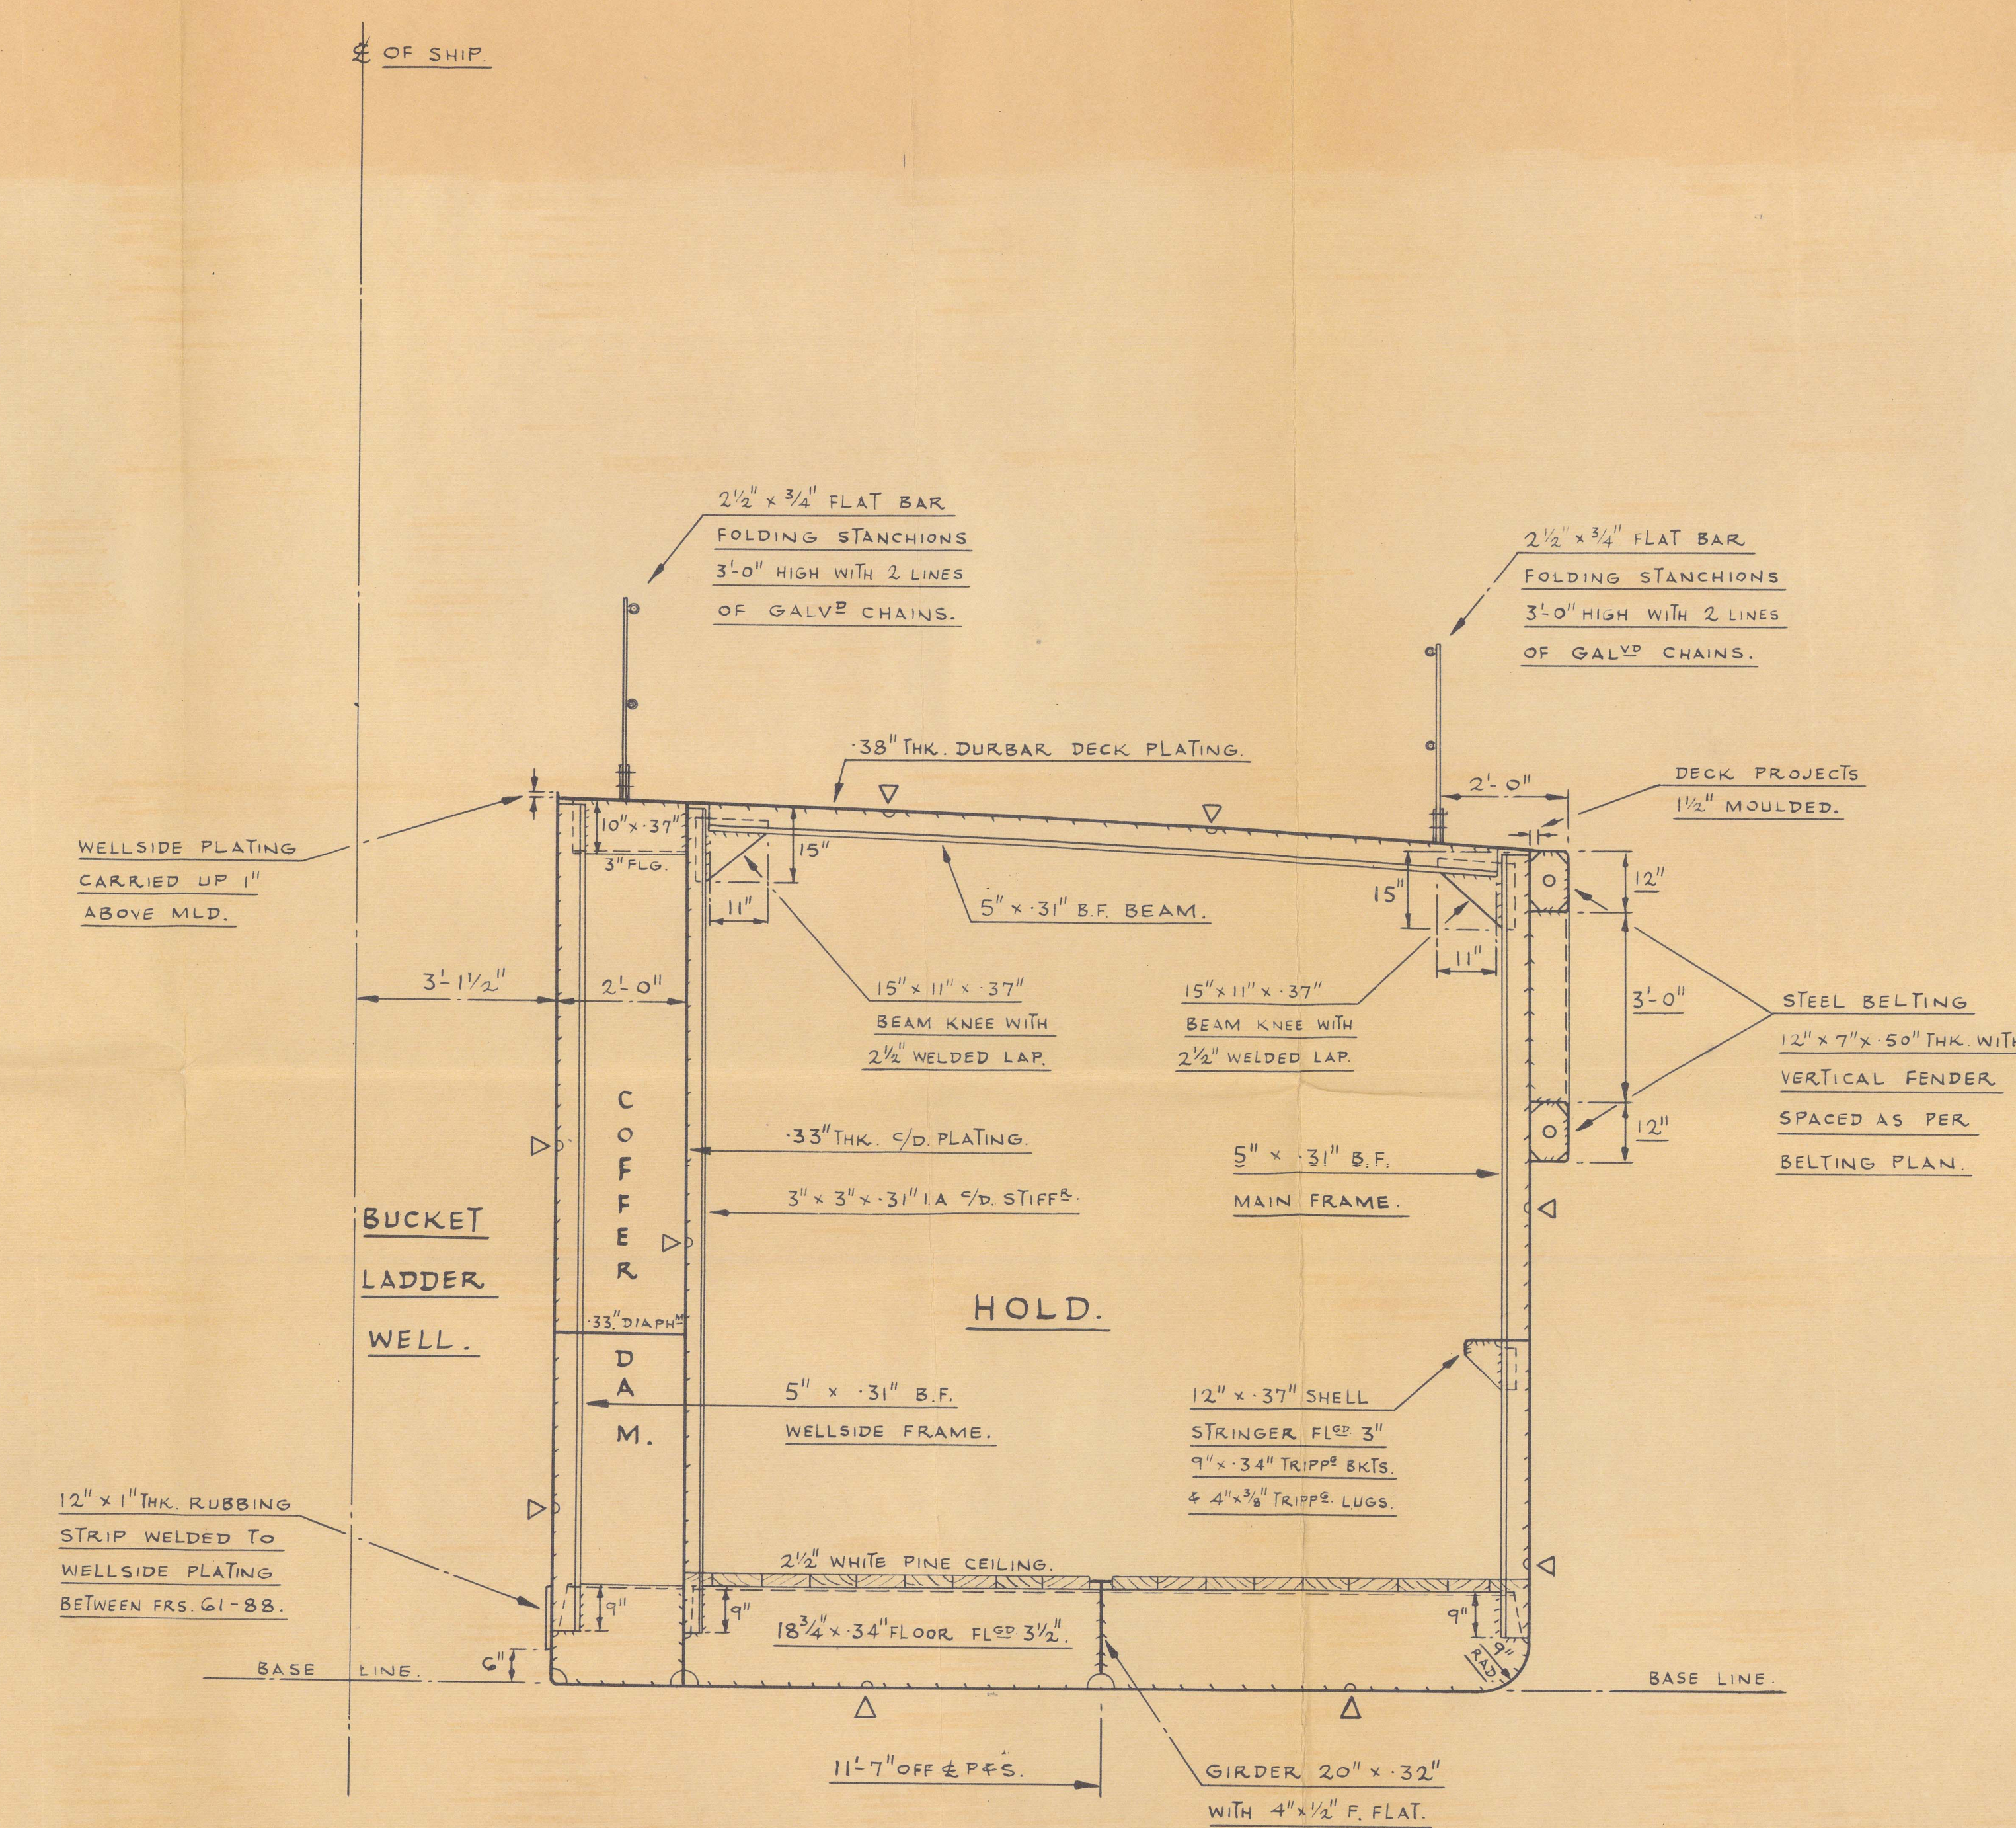

SECTION IN WAY OF FOR<sup>D</sup> HOLD.

SOUTH AFRICAN RAILWAYS SUID-AFRIKAANSE SPOORWEE	
ORDER BESTELLING	NO. J.C. 3071 J. AND VIEW 3142 J.
CONTRACT FOR BUCKET DREDGER	"STEENBOK"
CONTRACTORS NAME	FERGUSON BROS. (PORT GLASGOW) LTD.
CONTRACTORS DRAWING NO.	226
S.A.R. ALLOCATED NO.	S.A.R. TOEGEKENDE
HULL SECTIONS	
SCALE SKAAL	$\frac{1}{2}$ " = ONE FOOT
C.E. NO. J	15957
CERTIFIED BY GESERTIFISEER DEUR	DATE DATUM



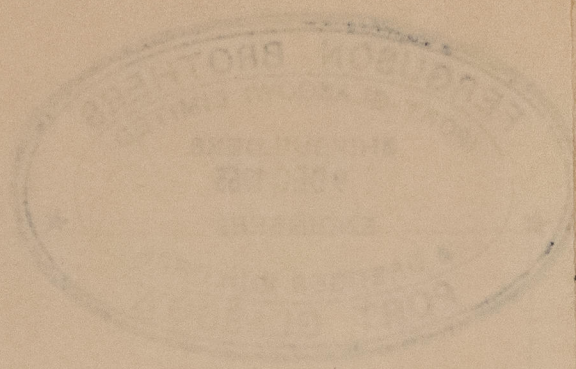

"STEENBOK" ★

FERGUSON BROTHERS LTD.

YARD No. 443

MIDSHIP SECTION  
(As Fitted) ✓

GREENOCK F.E. REPORT No. 27804


RECORDS DEPT.  
LONDON

This plan has been verified with the approved plans, and includes any modifications and or additions to the original approved arrangements made during construction which have been approved by the Surveyor in accordance with or equivalent to the requirements.

Signature Thlinthrops

Surveyor(s) to Lloyd's Register of Shipping

Date 6th January 1966

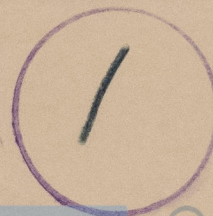

© 2021

Lloyd's Register  
Foundation