
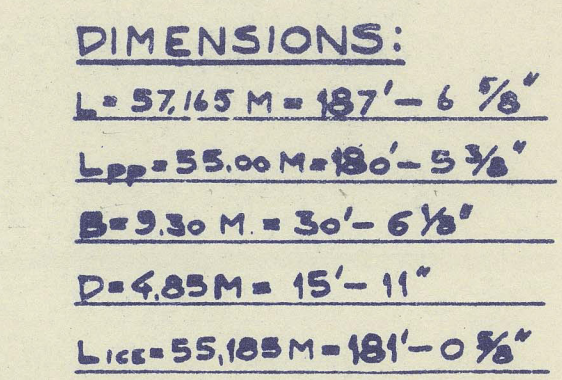
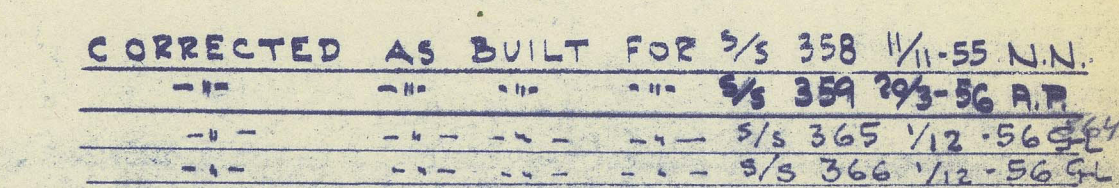
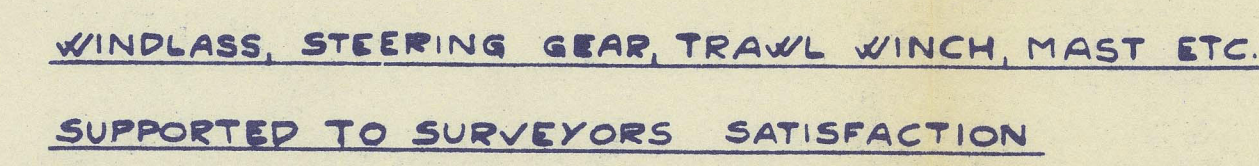


STOCKHOLM REPORT No. 10908.
#1 "Impressat"


$$D = 15.912'$$
$$L \times D = 2984$$

LLOYD'S REGISTER # 100 A1 STEAM TRAWLER
(STRENGTHENED FOR NAVIGATION IN ICE AS
FOR MERCHANT VESSELS. OWNERS REQUIREMENT).
ELECTRICALLY WELDED.

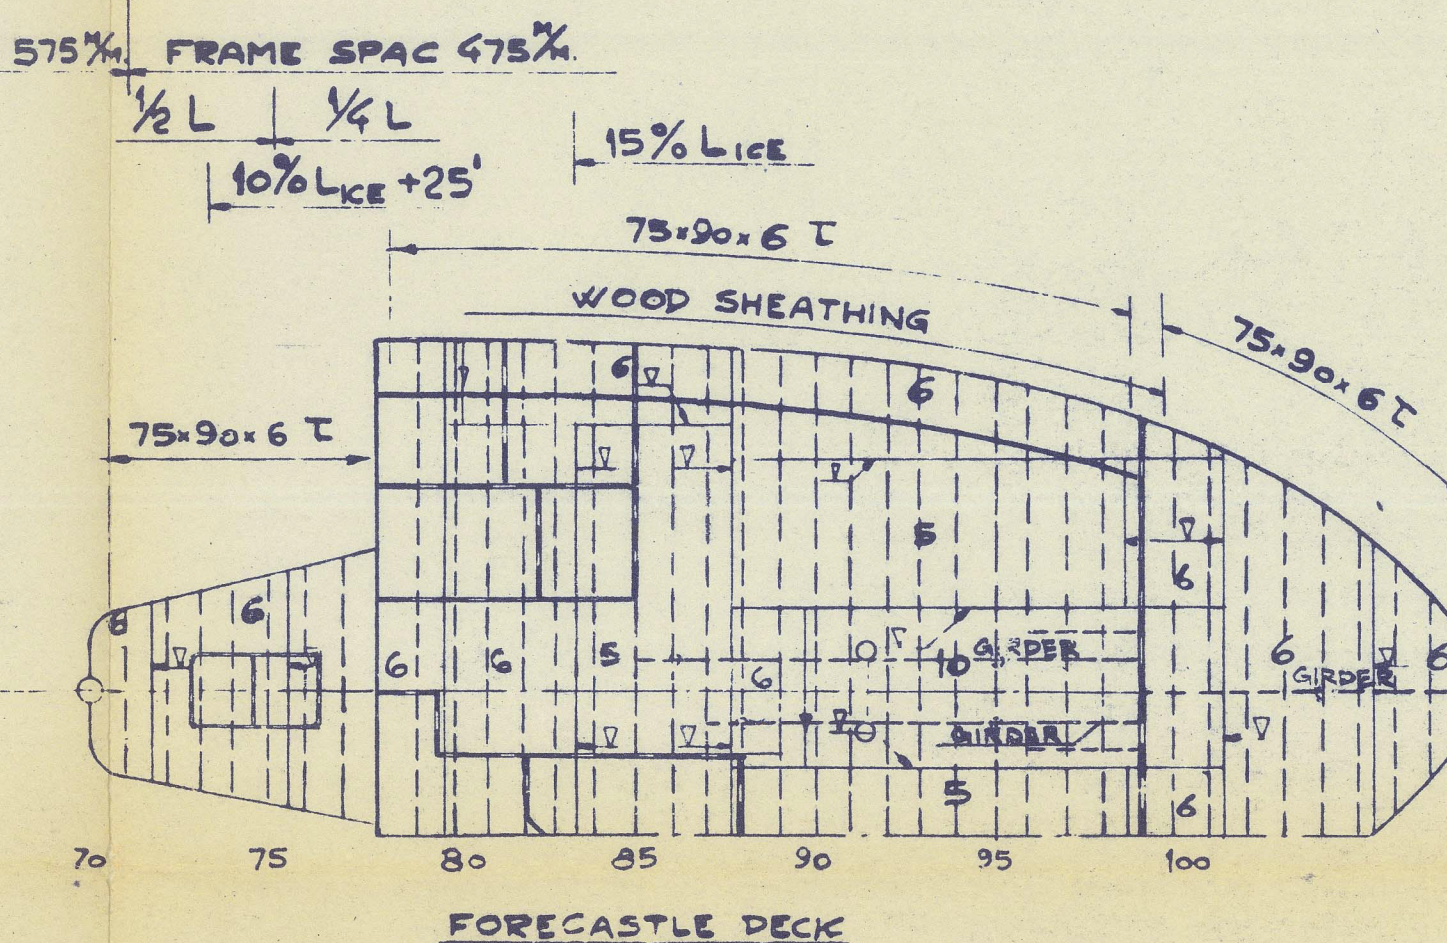

As levit

DATE	1100
ART. NO. 1007	
FINNDODA VARF	
STOCKHOLM	
DATE:	358/4
S/S 358/357, 365, 366	
LONGITUDINAL SECTION	
AND PLANS	

© 2021