

16 DEC 1960

DIMENSIONS

- LENGTH MLD - 87'-6"
- BREADTH MLD - 39'-0" (At DECK)
- DEPTH MLD - 14'-0"
- DRAFT - 5'-0"

PONTOON FOR FLOATING PNEUMATIC GRAIN ELEVATOR

To LLOYDS CLASS A1 For service to Hull Docks ^{Since} with the ^{Descriptive notation} Grain Elevator Pontoon

EQUIPMENT

EQUIPMENT LETTER - C

- 2 - 8" CWT. STACKLESS POWER ANCHORS
- 2 1/2" x 1/2" STREAM ANCHORS *Omitted per Surveyor letter 12.12.60.*
- 10 LENGTHS OF 15 FATHOMS - 1/2" STUD LINK CHAIN CABLE
- 50 FATHOMS 2 1/2" CWT. WIRE
- 80 FATHOMS 2 1/4" CWT. 6/16 GAUGE TOWLINE
- 2 LENGTHS OF 30 FATHOMS 1/2" CWT. 3/16" O.W.C. MENDING LINE




MAIN ENGINES: RUSTON & PROCTOR 5VEE3 TYPE
300 H.P. AT 600 R.P.M.
ALTERNATOR SET: RUSTON - PAXMAN TYPE G RPHZ
100 KVA AT 1000 R.P.M.

WELDING



- MAIN FRAMES TO SHELL - 20A 3/16" T.C.S.
- WELDS TO BE CONT^d IN WAY OF END BUTTS.
- BEAMS TO DECK - AS FOR MAIN FRAMES.
- FLOORS TO SHELL - 20A 3/16" T.C.S. (DOUBLE AT ENDS)
- CONT^d IN WAY OF ENGINES, PUMPS ETC.
- REV. FLATS TO FLOORS - 20A 3/16" T.C.S.
- CONT^d IN WAY OF ENGINES, PUMPS ETC.
- C.K. KEELSON TO SHELL - 20A 3/16" T.C.S.
- C.K. KEELSON TO FLOORS - 20A 3/16" T.C.S.
- SIDE KEELSON TO SHELL - 20A 3/16" T.C.S.
- TOP FLATS TO KEELSON - 20A 3/16" T.C.S.

DETAILS OF CASINGS ARE TO BE SUBMITTED IN A SEPARATE DRAWING.

DETAILS OF CASINGS ARE TO BE SUBMITTED IN A SEPARATE DRAWING.

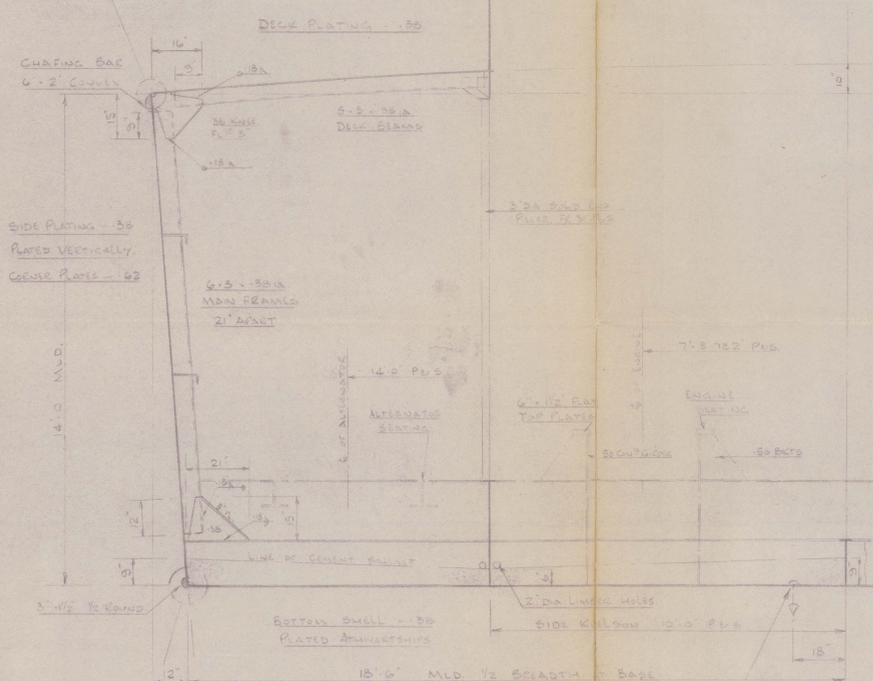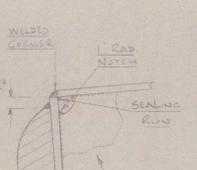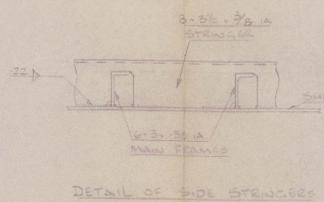

FLOORS - 15' x 30" WITH 6" x 6" EDG. FLATS TO BE CONTINUOUS ACROSS SHIP.
DECK FLOORS AT PORT & STARBOARD 30" x 30" WITH 6" x 6" EDG. FLATS.
C.K. KEELSON - 15' x 30" WITH 4" x 3/8" TOP FLATS.
SIDE KEELSON FOR 20' x 4" 30" x 30" WITH 4" x 3/8" T.C.S. FLATS.
ENGINE & ALTERNATOR BEATINGS ARE TO BE THE SUBJECT OF A SEPARATE DRAWING.
DECK FLOORS ARE TO BE SLITTED TO A DEPTH OF 2" TO TAKE ENGINE SEAT GADGERS.

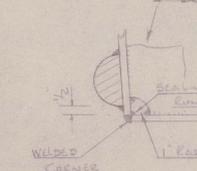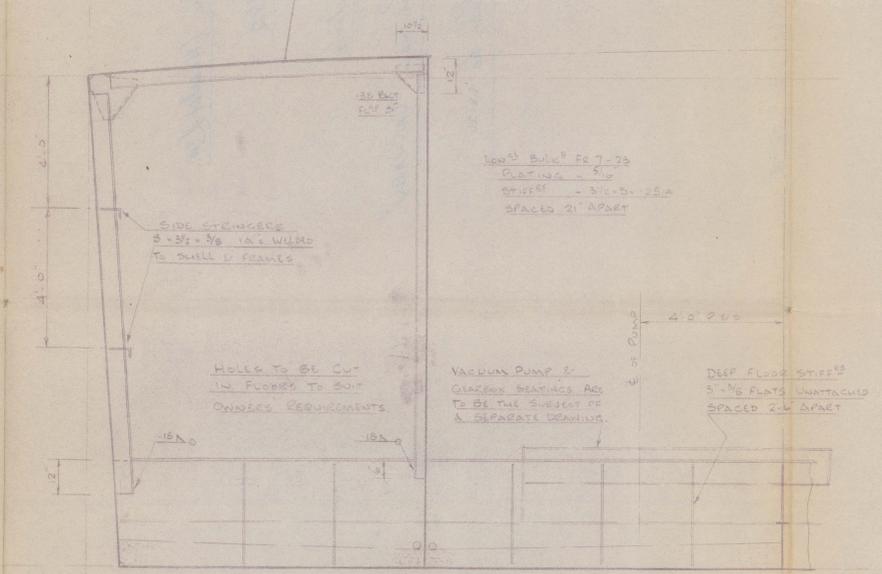

BOTTOM SHELL BUTTS TO BE ALTERNATELY 1" RAD. NOTCH IN FIELD PLATES OVER BUTT

G.H.10
16.12.60

RICHARD DUNSTON LTD.
SHIPBUILDERS,
THORNE, YORKSHIRE.

DRAWN BY T.R.B.	DATE 24.11.60	
TRACED BY	DATE	
CHECKED BY	DATE	
REVISIONS		
No.	DATE	PARTICULARS

This Drawing and the information it contains are the Property of RICHARD DUNSTON LTD. It is not to be Traced, Copied or Published without their Written Consent, nor is the Information thereon to be misused in any way.

YARD N° 5 782 DRG. N° 5740/1

TITLE:— MIDSHIP SECTION

SCALE: 1/2" TO ONE FOOT

Richard Dunston (Hessle) Ltd.

Yard no 782

Midship Section

Grain Elevator Pontoon 'CARNABY'

Sub. F.E. Rept. no 681261



© 2021

Lloyd's Register
Foundation

014556-014565-0378

S. 782



© 2021

Lloyd's Register
Foundation

014556-014565-0378