


CLASSED B.S.\*

British transportation

FOR SCANTLINGS ONLY

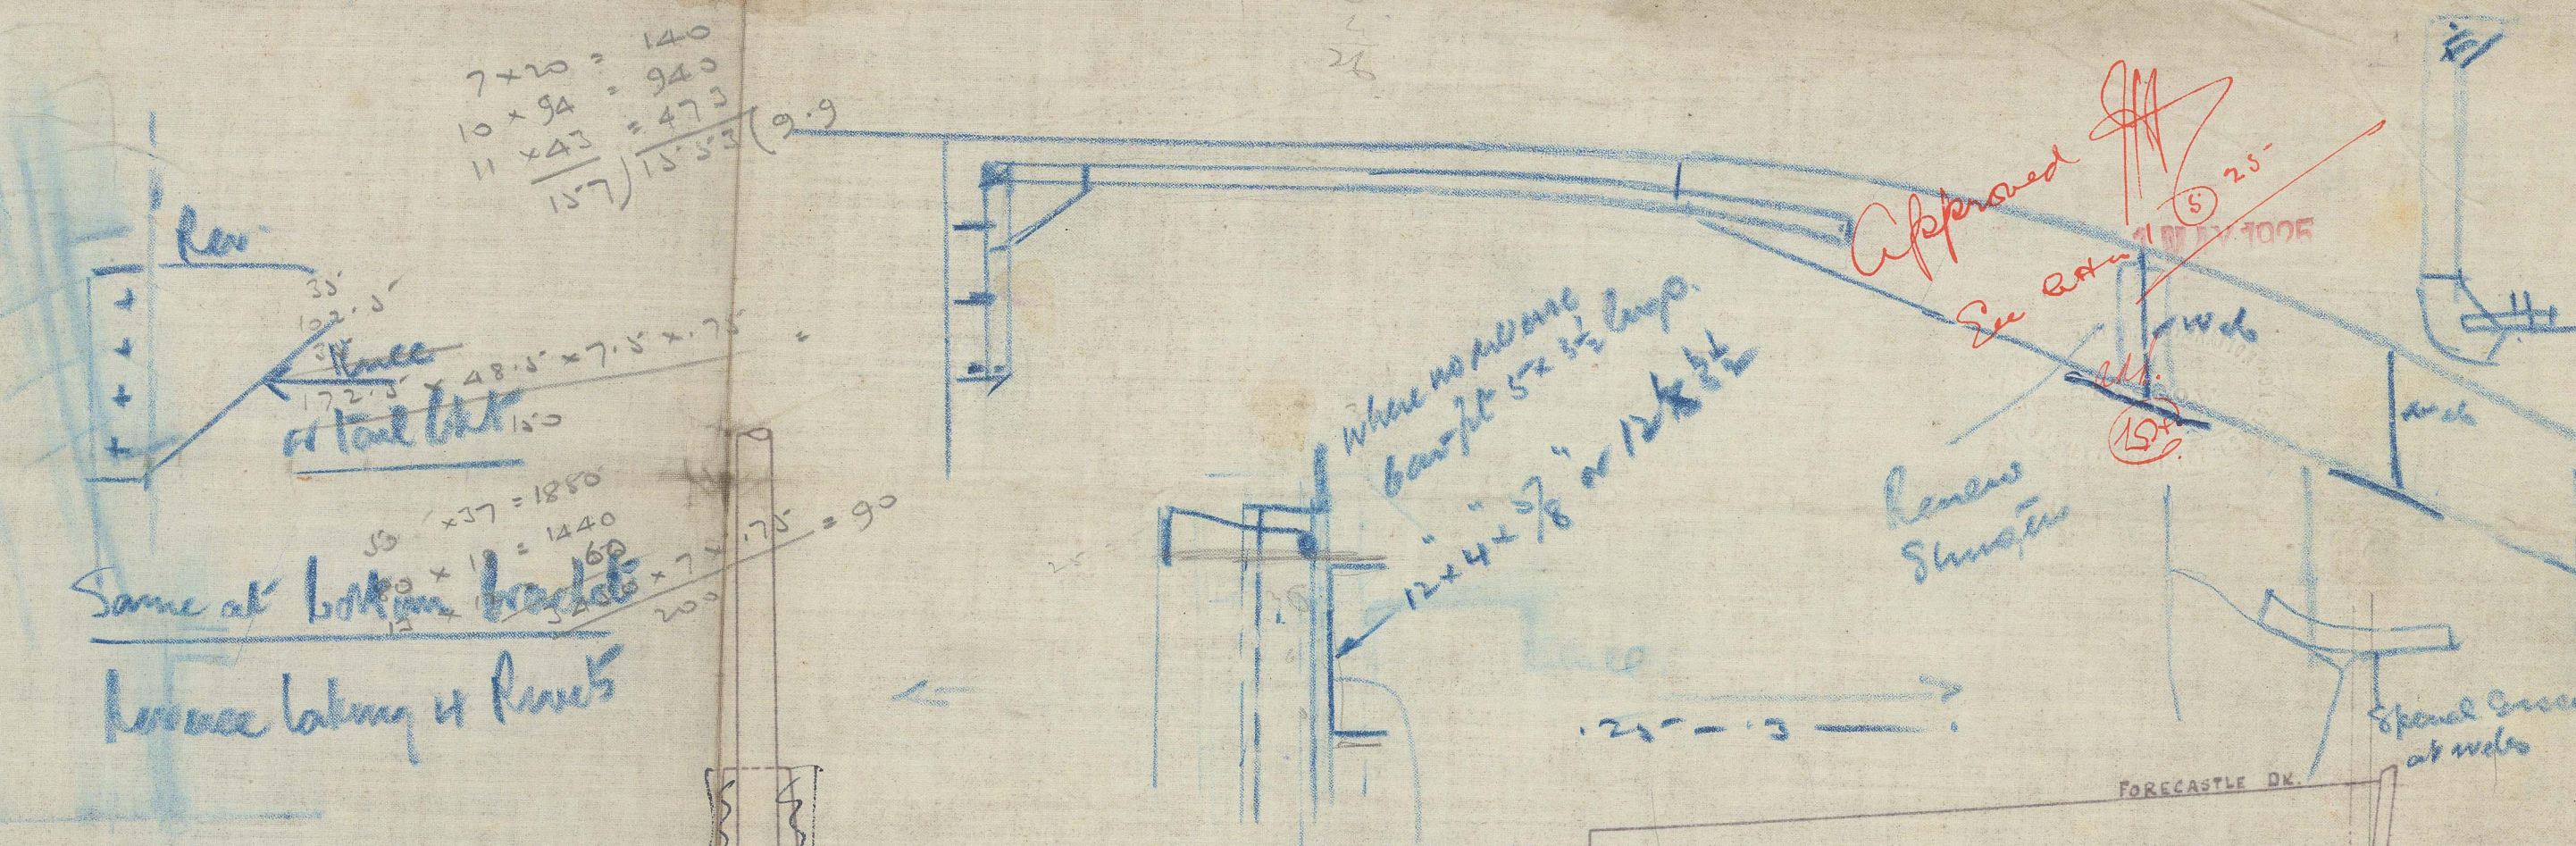


AMENDMENTS IN BLUE  
CARRIED OUT AT 2<sup>ND</sup> SPECIAL SURVEY  
N1 (SEPT 1944) AT GREENOCK

See detail Plan of  
Slipper Sk. Appended



B. Brythwaite Dk Co.

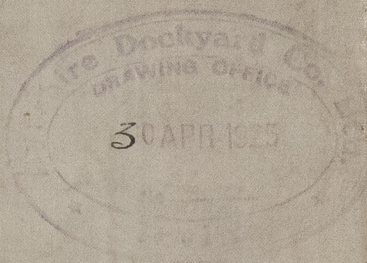

0281

L 96

9. 1. 1925

014566 - 014573 - 0281

Reg

N/N

ESTRELLA

T.C. 20/5/25-

AYRSHIRE DK. COY.

496

PROFILE & DKS

1-5-25.

BARON HAIG

5.



© 2021

Lloyd's Register  
Foundation