


Lloyd's Register of Shipping.

SURVEYS FOR FREEBOARD.
(CONDITIONS OF ASSIGNMENT.)

16 NOV 1950

Ship's Name BARON FAIRLIEPort of Survey HULL.Official Number 146719Surveyor's Signature T.L. DIXONNationality and Port of Registry BRITISH. AROROSSAN.Date of Survey 16.8.50, 31.8.50, 5.9.50, 27.9.50, 12.10.50

Disposition and dimensions of superstructures, trunks, deckhouses and machinery casings, to be inserted in the diagrams and tabular statement:—

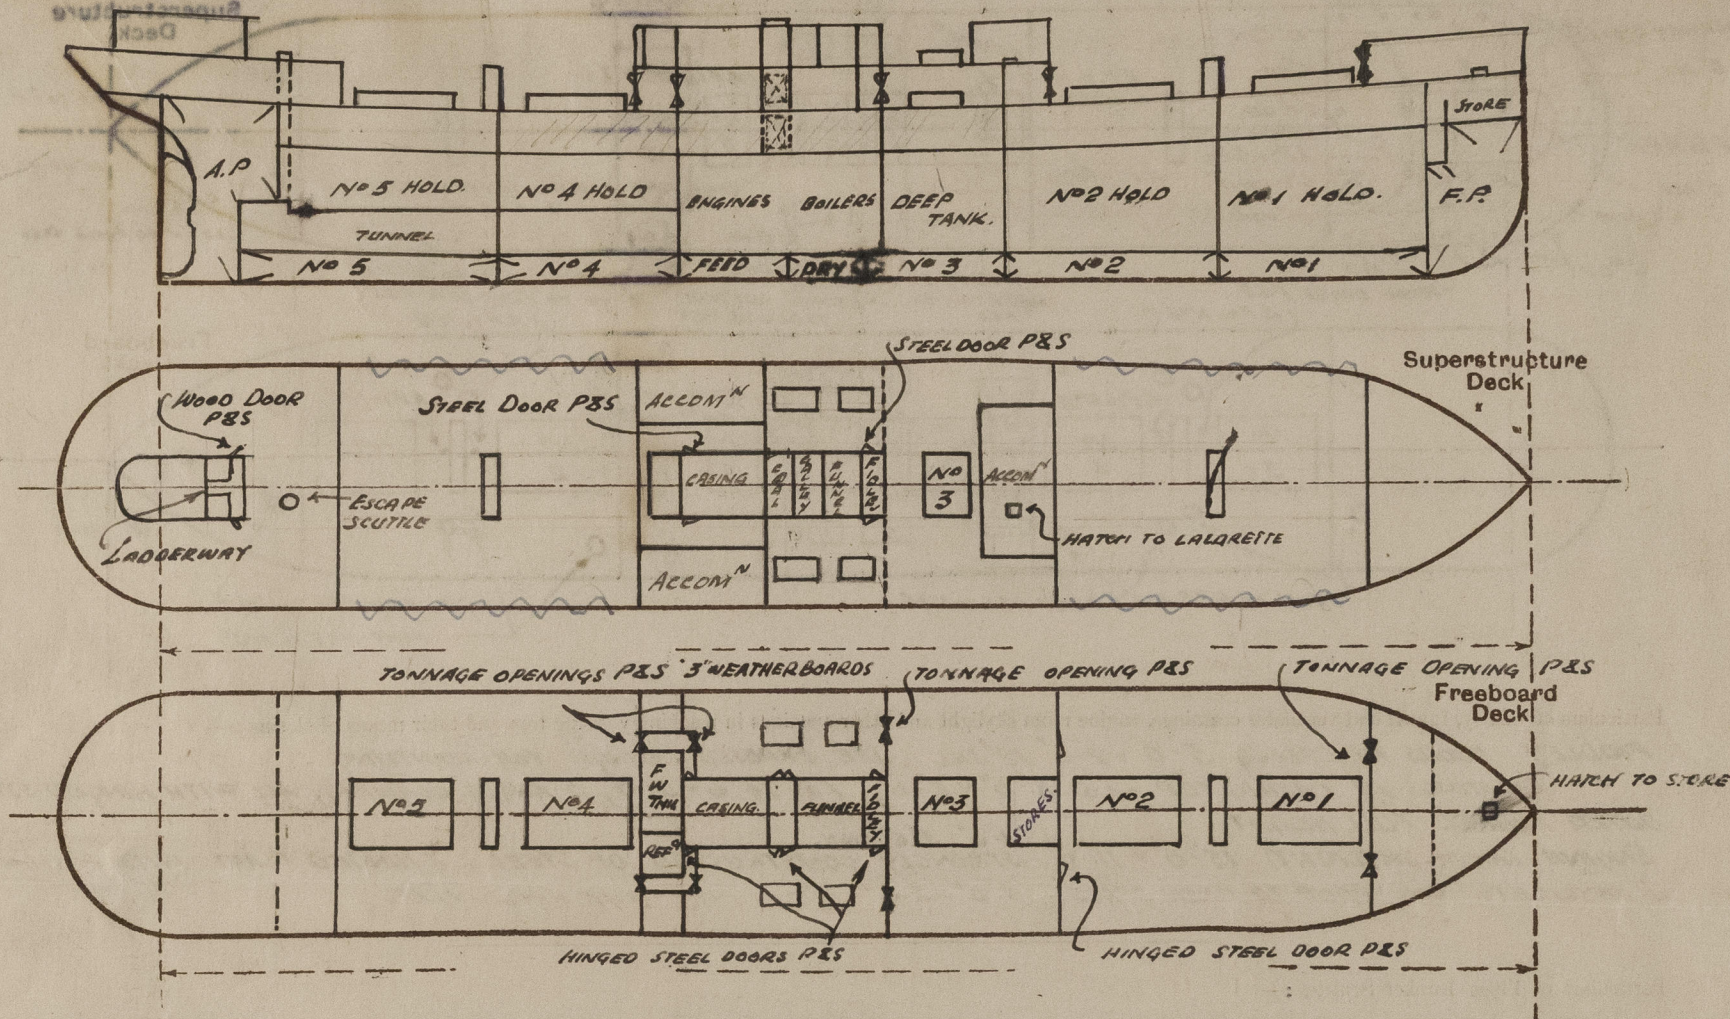

Particulars of Superstructures, Trunks, Casings, Deckhouses.

	Coaming	Plating	Stiffeners	Spacing	End Attachments of Stiffeners	Size of Openings	Height of Sills	Height of Casings
Poop Bulkhead	40	40	7 x 3 1/2 - 18BA	30"	JOINTER	NONE	—	—
Raised Quarter Deck Bulkhead ...	—	—	—	—	—	—	—	—
Bridge, After Bulkhead	38	38	4 x 3 - 32	32" - 34"	NONE	20 5' 0" x 3' 6"	18"	—
Bridge, Forward Bulkhead	44	44	9 1/2 x 3 1/2 x 44 BA	30"	LUGGED T & B	20 5' 0" x 3' 3"	18"	—
Forecastle Bulkhead	34	30	3 x 3 - 38	24"	JOINTER	20 5' 0" x 4' 0"	18"	—
Trunk, Aft	—	—	—	—	—	—	—	—
Trunk, Forward	—	—	—	—	—	—	—	—
Exposed Machinery Casings on Freeboard or Raised Quarter Decks ...	—	—	—	—	—	—	—	—
Exposed Machinery Casings on Superstructure Decks	38"	30"	3 x 3 - 36"	36"	BKT AT TOP	40 5' 0" x 2' 0"	18"	7' 9"
Machinery Casings within Superstructures not fitted with Class I Closing Appliances	38"	30"	3 x 3 - 36"	36"	—	20 8' 9" x 4' 4"	18"	—
Deckhouses on Flush Deck Ships ...	—	—	—	—	—	40 5' 0" x 22"	15"	—

Particulars of Closing Appliances (state if capable of being manipulated from both sides).

Poop Bulkhead	NO OPENINGS
Raised Quarter Deck Bulkhead ...	—
Bridge, After Bulkhead	WEATHERBOARDS IN CHANNELS FULL HEIGHT
Bridge, Forward Bulkhead	HINGED STEEL DOORS CLIPPED ON OUTSIDE ONLY.
Forecastle Bulkhead	WEATHERBOARDS IN CHANNELS FULL HEIGHT.
Exposed Machinery Casings on Freeboard or Raised Quarter Decks ...	—
Exposed Machinery Casings on Superstructure Decks	HINGED STEEL DOORS OPERATED BOTH SIDES.
Machinery Casings within Superstructures not fitted with Class I Closing Appliances	SADDLEBACK DOORS, HINGED STEEL OPERATED OUTSIDE ONLY.
Deckhouses on Flush Deck Ships ...	HINGED STEEL DOORS OPERATED BOTH SIDES.

PARTICULARS OF PROTECTION TO OPENINGS, ETC.

HATCHWAYS ON FREEBOARD AND SUPERSTRUCTURE DECKS.											
	← FREEBOARD DECK →					← BRIDGE DECK →					
Description of Hatchway ...	N°1	N°2	N°3	N°4	N°5	BUNKER FOR P&S	BUNKER AFT P&S	STORE IN F&BLE	N°3	BUNKER FOR P&S	BUNKER AFT P&S
Dimensions of Hatchway ...	31'6" x 22'0"	36'0" x 22'0"	18'0" x 22'0"	36'0" x 22'0"	30'0" x 22'0"	6'0" x 4'0"	9'0" x 4'0"	3'0" x 3'0"	15'0" x 22'0"	6'0" x 4'4"	7'9" x 4'4"
COAMINGS {											
Height above Deck ...	30"	30"	30"	30"	30"	9"	9"	9"	30"	30"	30"
Thickness { Sides44	.44	.44	.44	.44	3 1/2	3 1/2	3 1/2	.44	.40	.40
Stiffeners ... Ends44	.44	.44	.44	.44	3 1/2	3 1/2	3 1/2	.44	.40	.40
Brackets, Stays ...	9 x 3 x 50 BA	11 x 3 1/2 x 50 BA	7 x 3 1/2 x 50 BA	11 x 3 1/2 x 50 BA	9 x 3 x 50 BA	.50 BA	.50 BA	.50 BA	8 x 3 1/2 x 50 BA	—	—
HATCH BEAMS {											
Number ...	6	7	3	7	5				2		
Spacing ...	4'6"	4'6"	4'6"	4'6"	5'0"				5'0"		
Scantling and Sketch ...	←	PLATE 19	←	4 1/2 x 3 x 36	—		NONE		As 1		NONE
Bearing Surface ...	3 1/2"	3 1/2"	3 1/2"	3 1/2"	3 1/2"				3 1/2"		
FORE AND AFTERS {											
Number ...											
Spacing ...											
Unsupported Lengths ...											
Scantling* and Sketch ...											
Bearing Surface ...											
HATCH COVERS {											
Material ...	W.W							W.W		W.W	W.W
Thickness ...	3							3		3	3
How fitted ...	F&A	As 1	As 1	As 1	As 1	As 1	As 1	ATHW	As 1	ATHW	ATHW
Bearing Surface ...	3							3		3	3
Spacing of Cleats ...	21'22"					20"	20"	24"	21'22"	20"	20"
Number of Tarpaulins ...	3	As 1	As 1	As 1	As 1	2	2	2	3	2	2
<p>*Are wood fore and afters steel shod at all bearing surfaces? NONE</p> <p>Are battens and wedges efficient and in good condition? YES</p> <p>Are tarpaulins in good condition and in accordance with rule requirements? YES</p> <p>Are lashings provided in accordance with rule requirements? YES STEEL CLAMPS.</p>											

Particulars of any special features:—

Endorsement at first survey and at surveys for renewal of Certificate:—

The fittings and appliances are in accordance with the particulars shown on this form (or as now modified), and are in good

FREEBOARD AND SUPERSTRUCTURE DECKS.		
POOP TUNNEL ESCAPE	CASING TOP BUNKER. JADOLEBACK	BRIDGE LAZARETTE IN HOUSE
2'0" DIA	8'0" x 18'3"	3'0" x 3'0"
18"	8"	3
1/4"	3	3
	50 B.A.	3/8
ADMIRALTY PATTERN ESCAPE SCUTTLE	NONE	
STEEL 1/4"	W.W 3	GRATING
HINGED	F&A 3	
HINGED CLIPS	22" 2	
its?		

Particulars of doors
in bridge discharge.



© 2021

Lloyd's Register
Foundation