


3 - APR 1944

SCALE: 1" = 1 FT. & AS MARKED

1297~8-9-1300-1-2-3-4

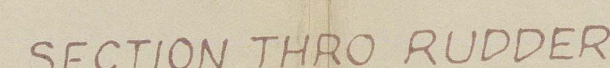

A circular purple ink stamp. The outer ring contains the text "COCHRANE & SONS LIMITED" at the top and "SELBY" at the bottom, separated by two small stars. In the center, the number "2566" is stamped above the word "SHIPBUILDERS", which is above the date "25 MAR 1944".

Shill F.E.

Rpt. Nos

Empire Flora

53089

" Stella

53154

" Sheila

53171

" Clara

NV. AIRMAN

53172

" Martha

53200

" Vera

53250

" Greta

53312

" Nina

53433

014654-014665-0190

Cochrane & Sons Yard


Nos. 1294-1304.

STERN FRAME +

RUDDER.

RECORDS DEPT.

LONDON

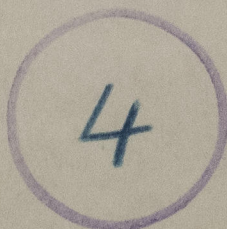

© 2021

Lloyd's Register
Foundation

0190

Stemframe & rudder



© 2021

Lloyd's Register
Foundation

0190

1297



© 2021

Lloyd's Register
Foundation