






*Tw. Sc. M/S* "SANTA RITA"

BURMEISTER & WAIN,  
COPENHAGEN,


NEWB: No: 553.

*Copenhagen Report: 7981.*  
LONGITUDINAL-SECTION.

Plan as vessel built.

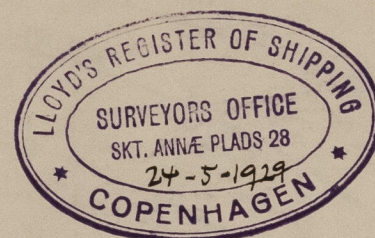

Sister vessel: *M/S* "Santa Inez".  
*Gen. Rep. 7942.*

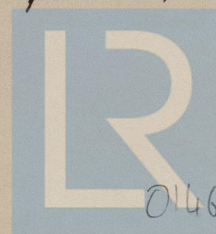

© 2021

Lloyd's Register  
Foundation

014666-014674-0086