


Found

S/S War Pintail Hull # 30751
" 1st Entry " 30782

3/5 Apple Box ash

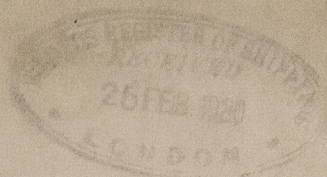

Standard Vessel.

Type E.

Radio No 633. ~~637~~

Salazarashm

AMENDED

MIDSHIP SECTION.



ST
ET ANGL

5 x 32 x 50 ST
MANHOL
UNDER H

LATING



© 2021

Lloyd's Register
Foundation

014686-014694-014692