

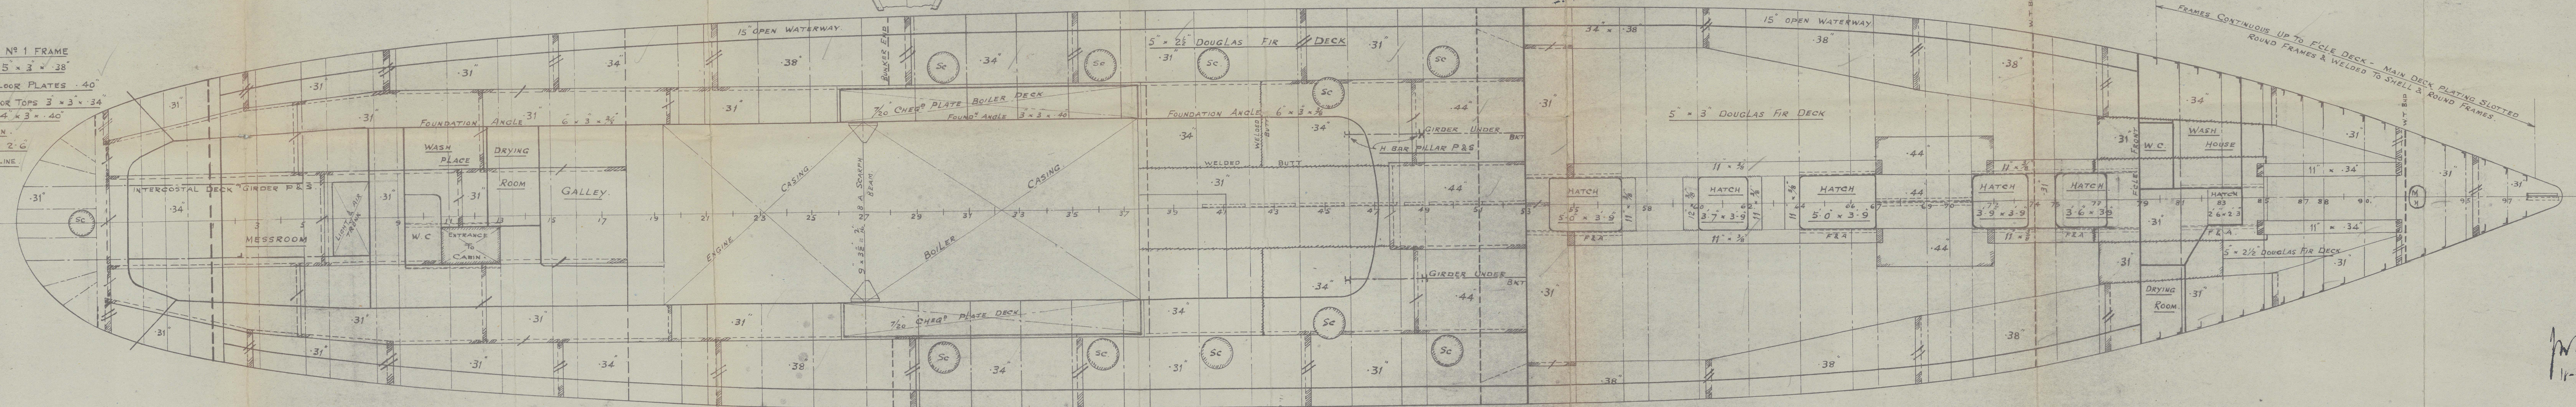
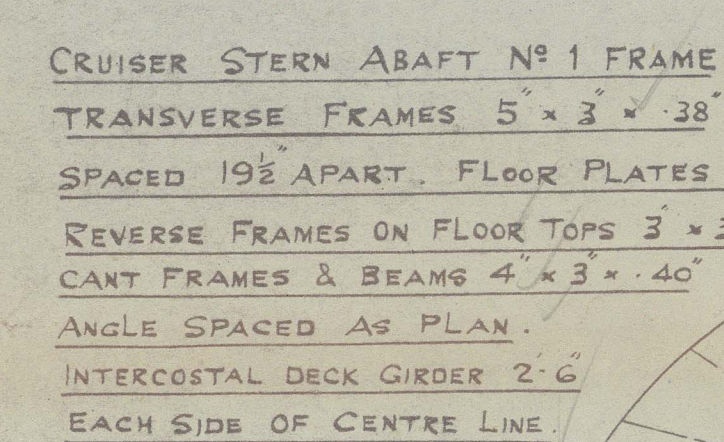
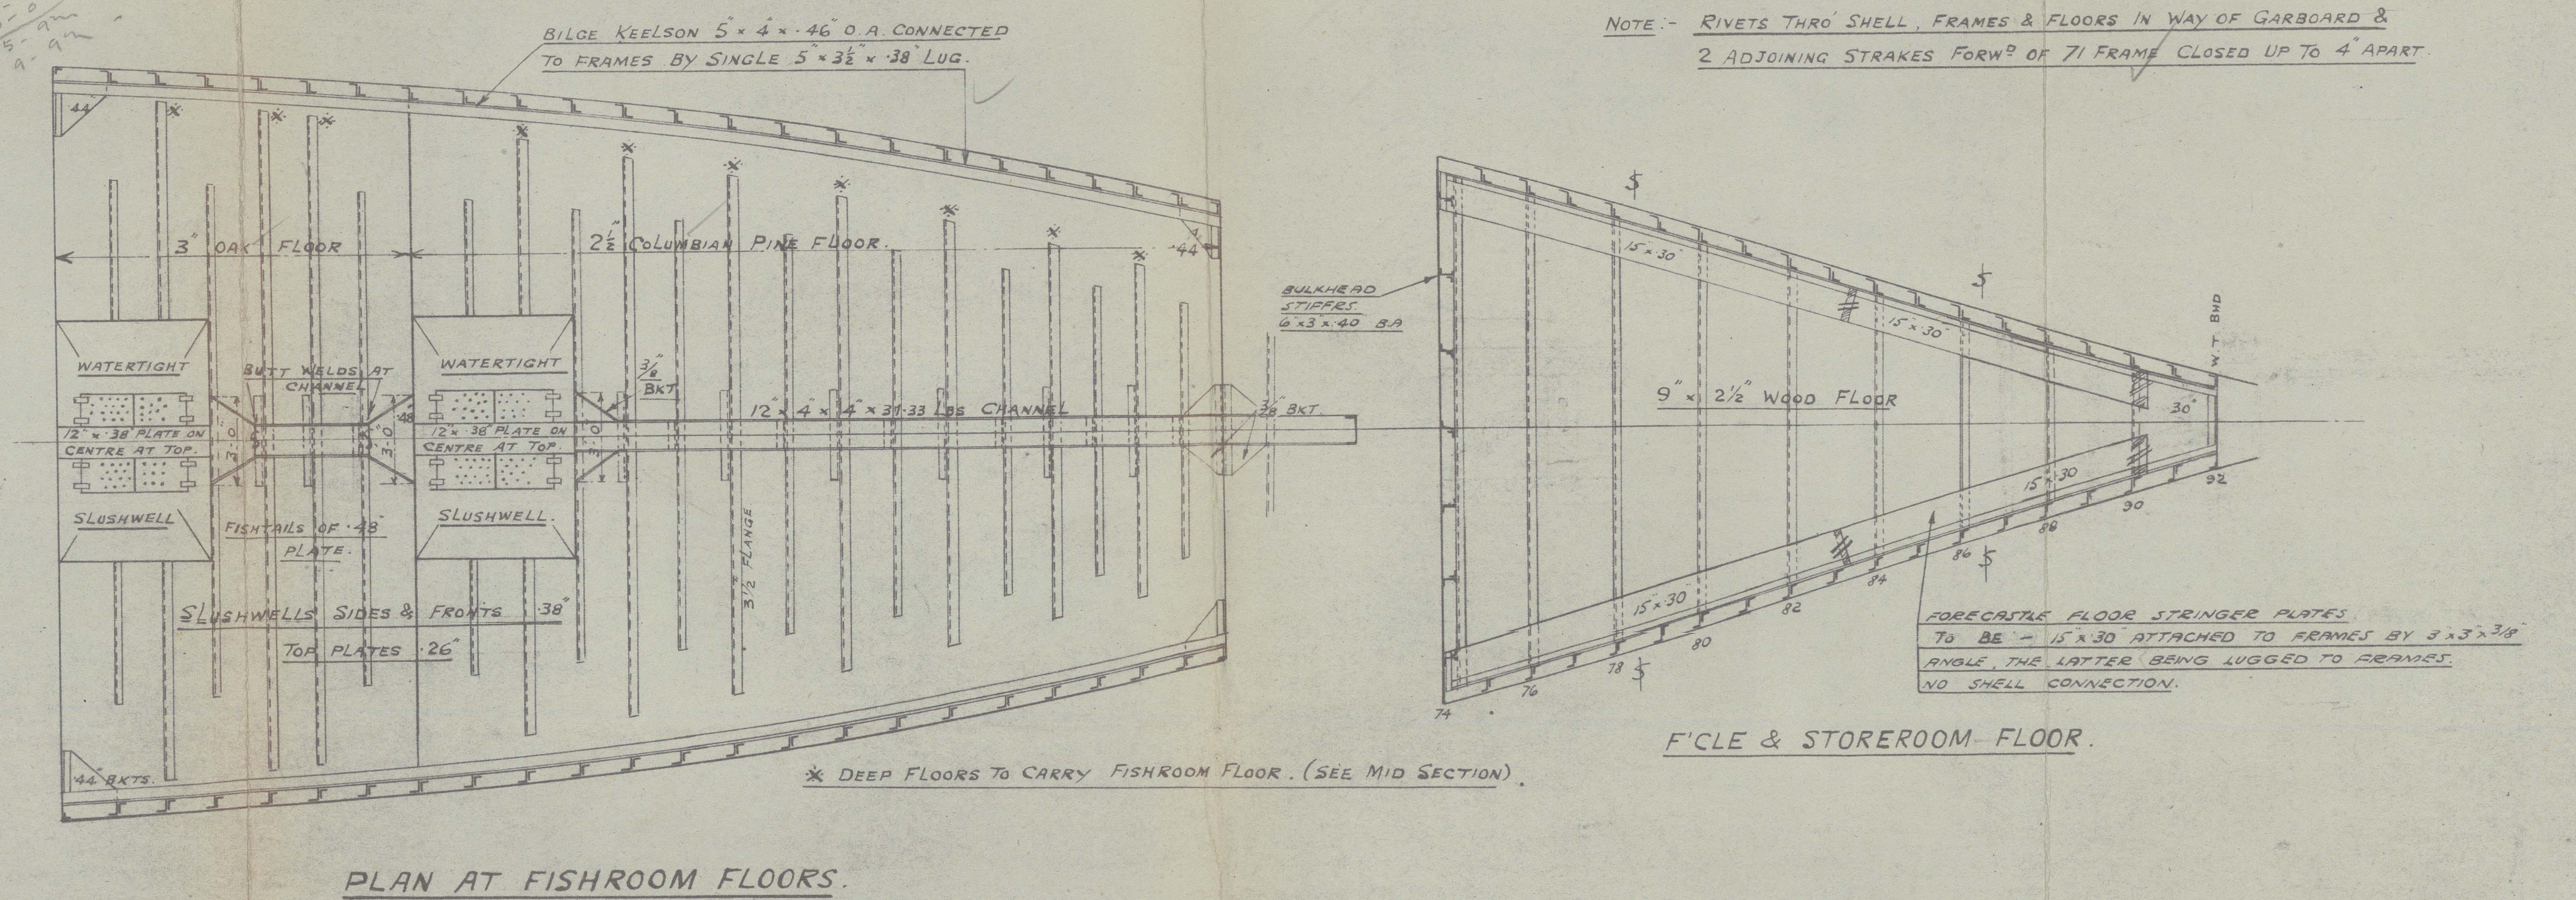
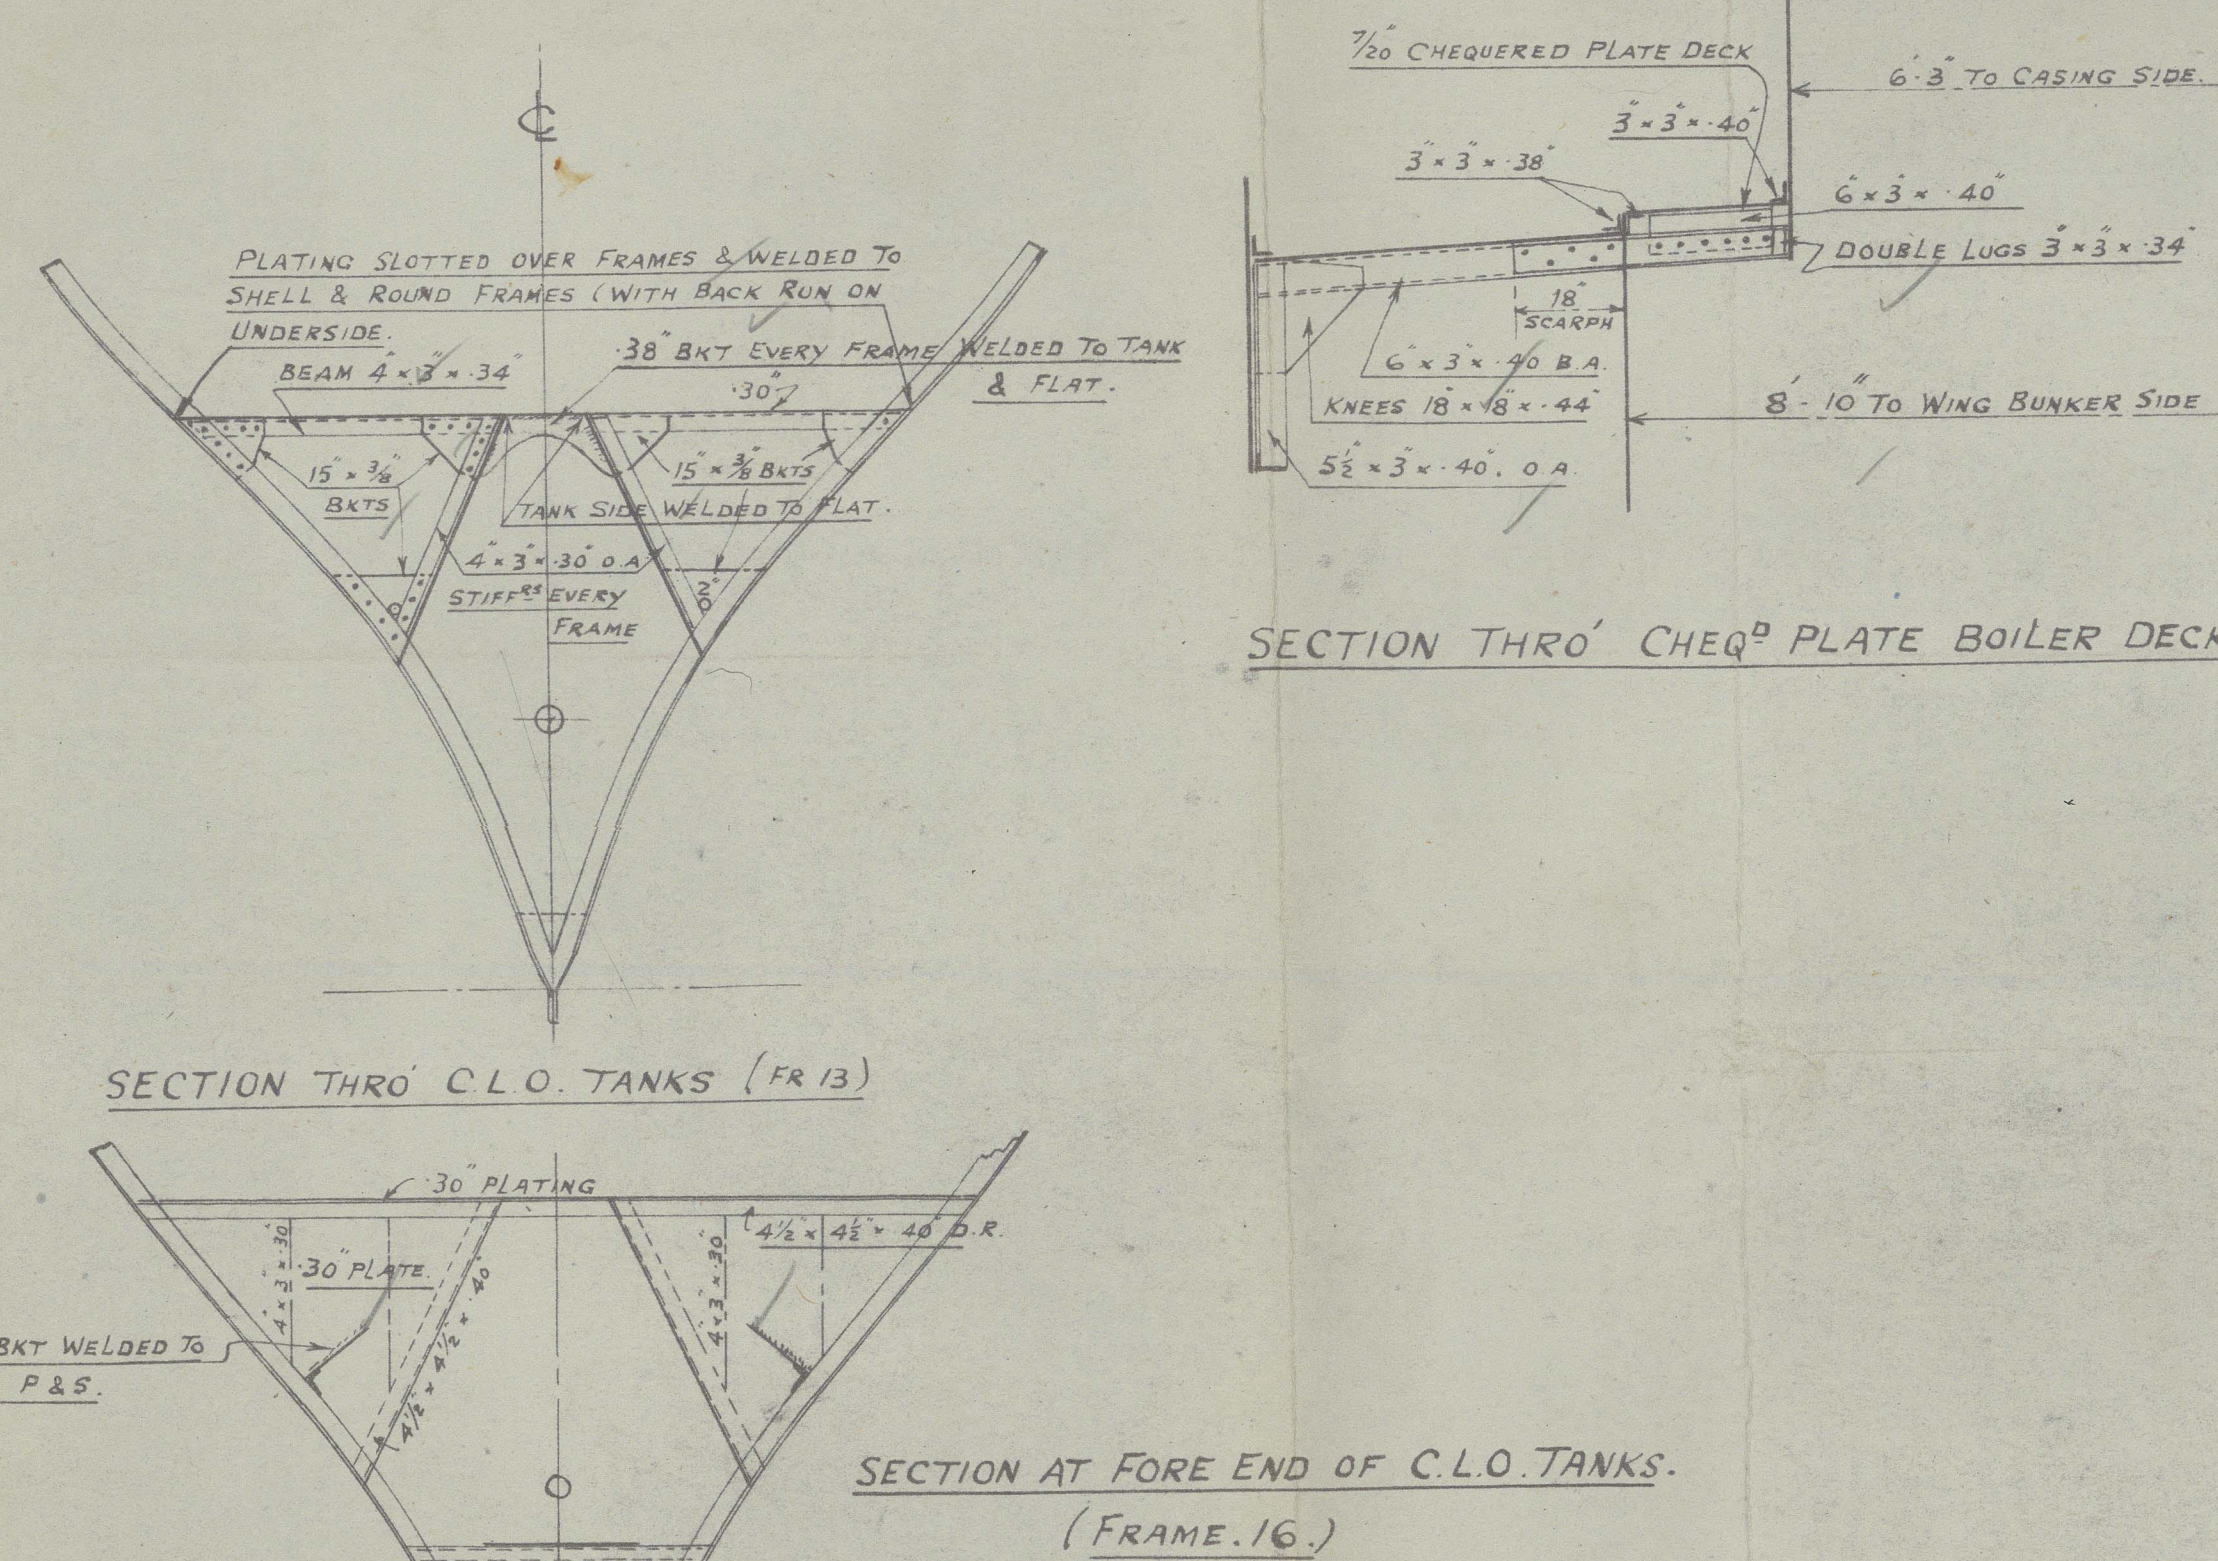
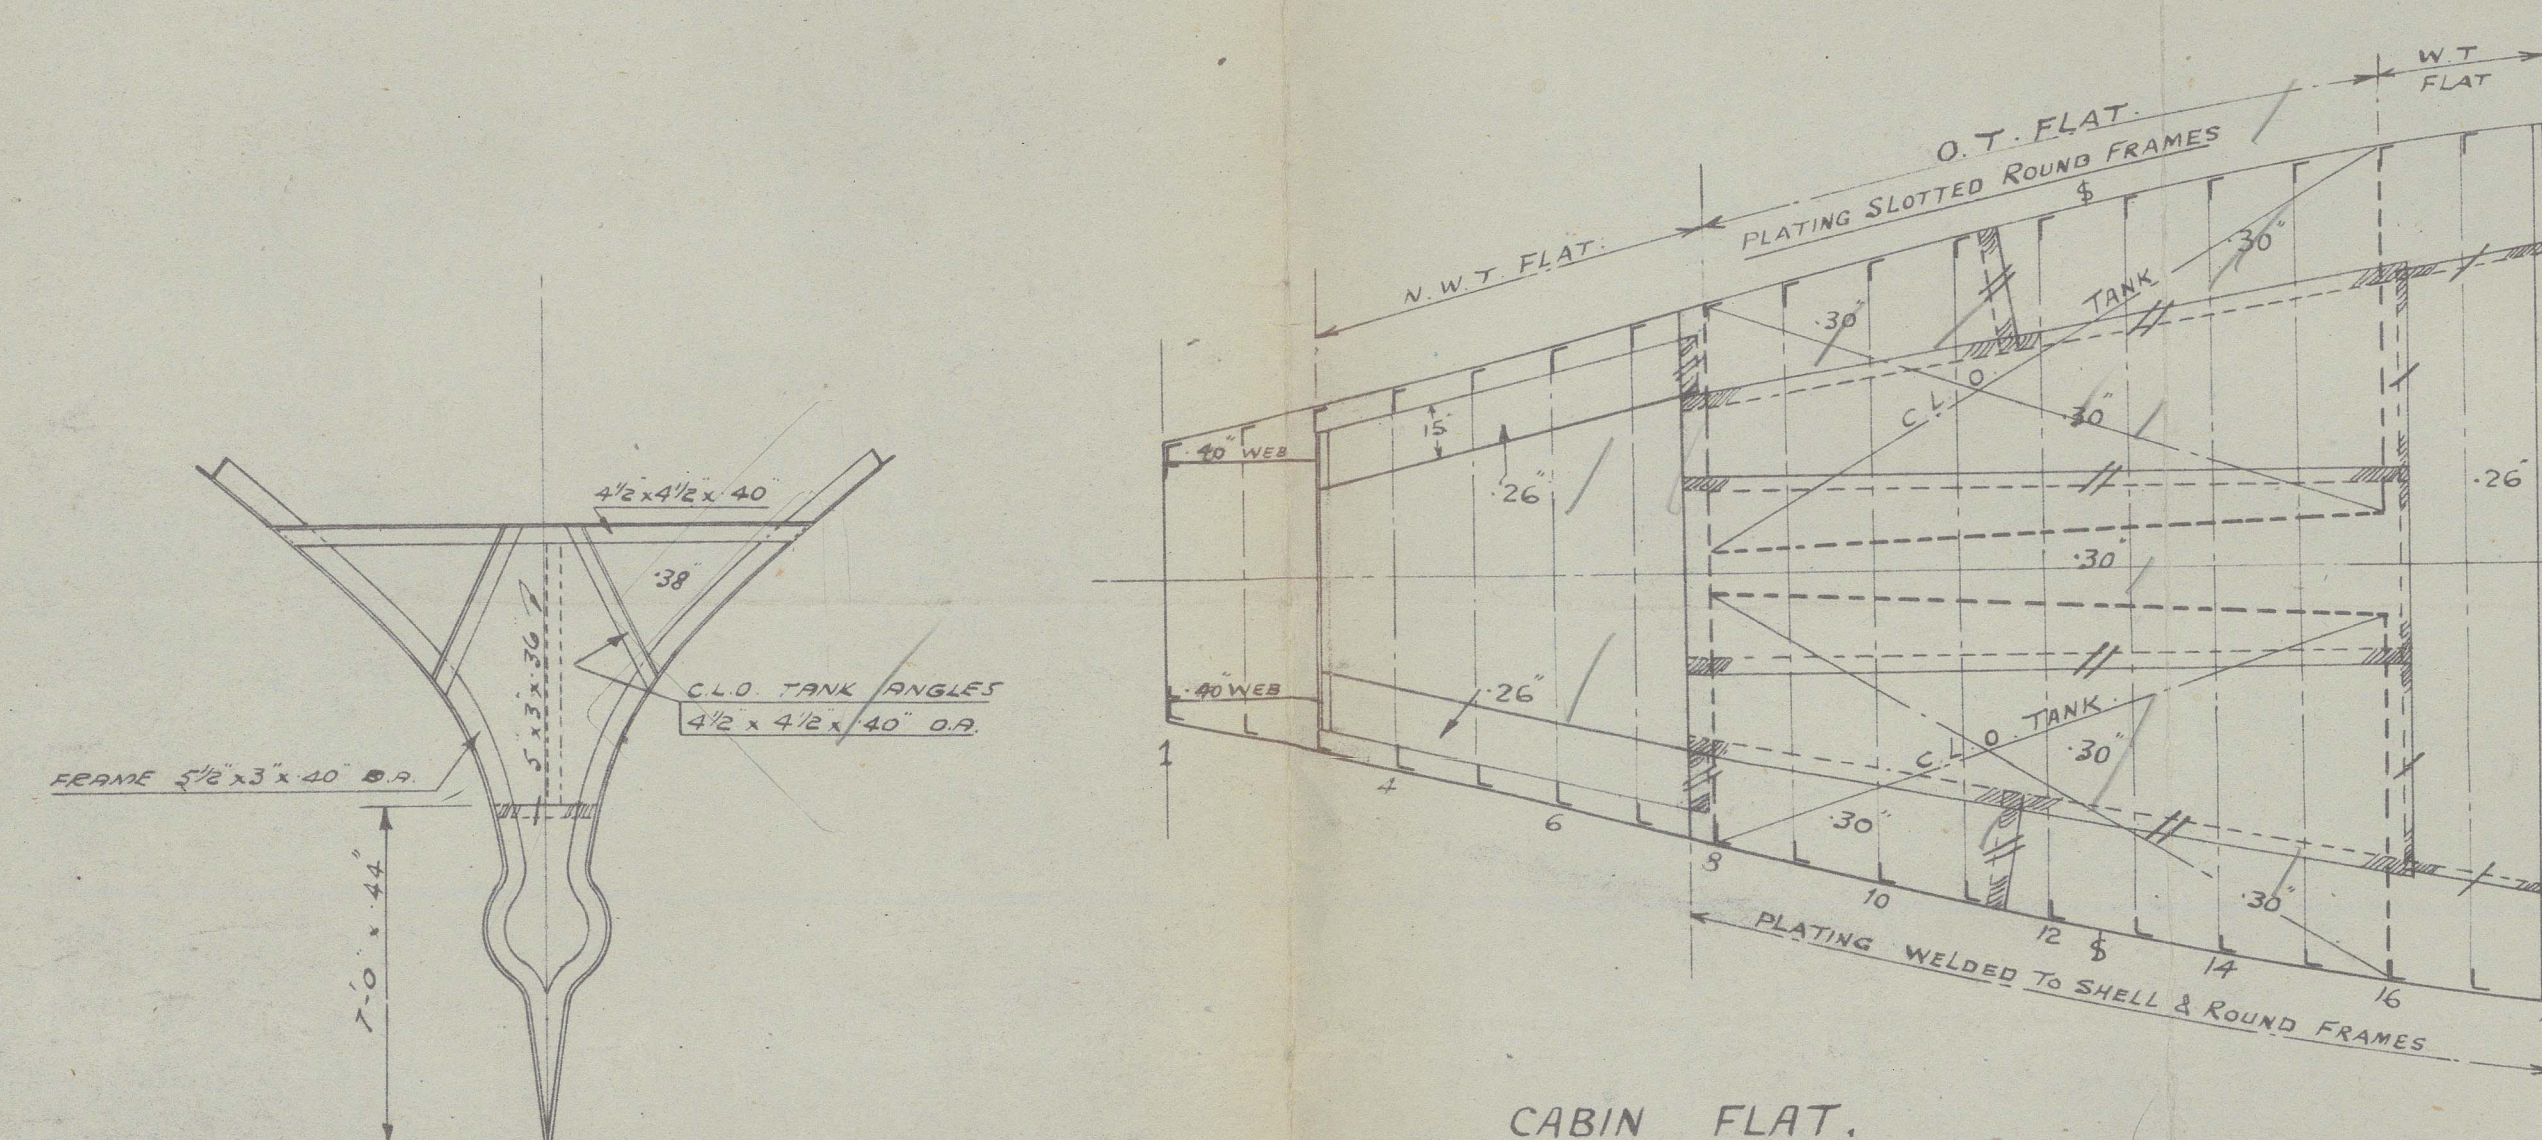


COOK, WELTON & GEMMELL LTD.
16 JUL 1945
Shipbuilders, GROVE HILL, BEVERLEY

CHARTERED AND
WHEELHOUSE

ACCOMMODATION 4. 6" x 24" x 8" B&R PILLARS BRANDED
UNDER PILLARS.

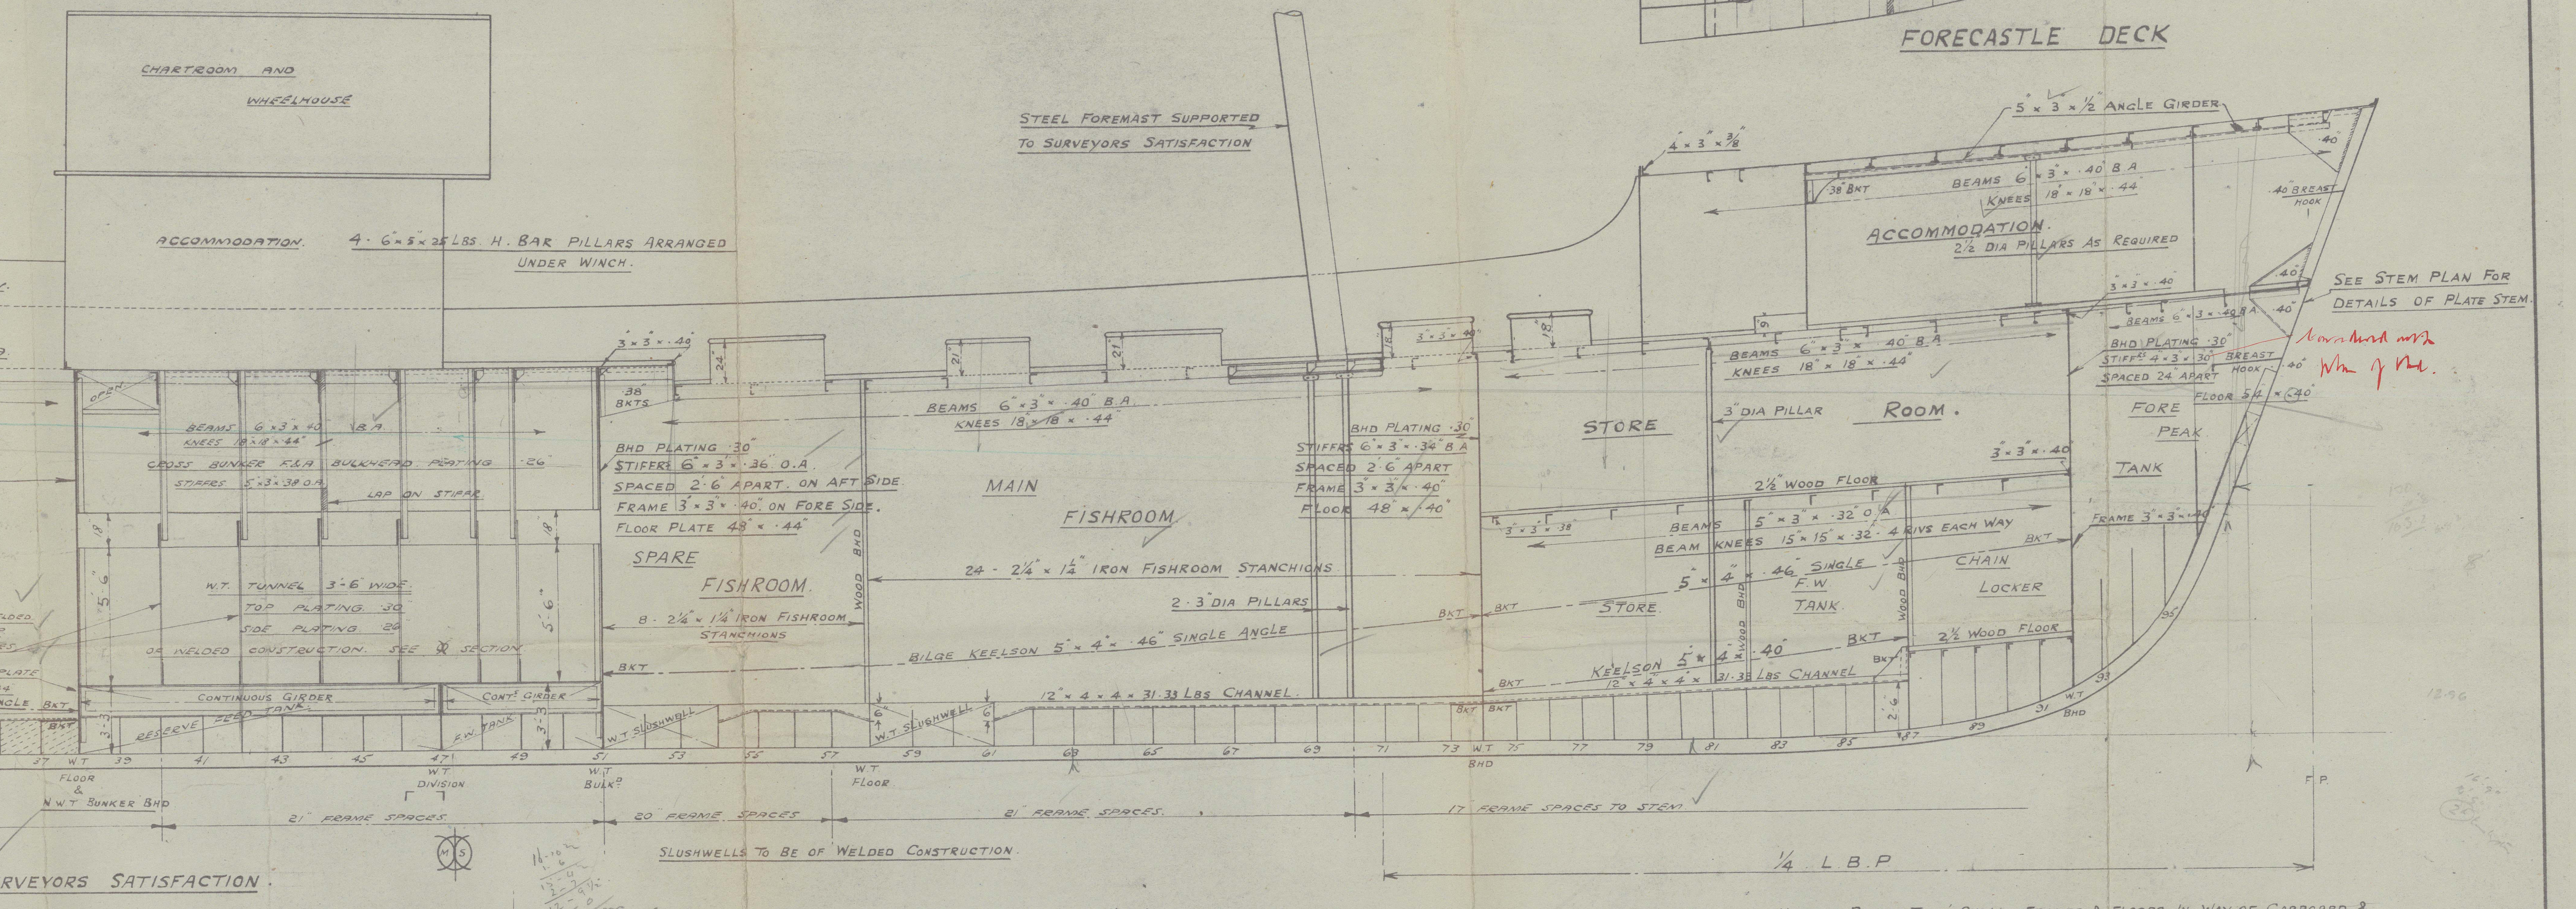

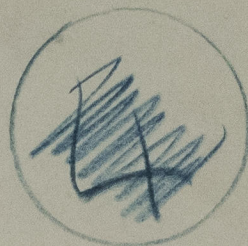



2

COOK WELTON & GEMMELL

YARD NO. 462.

PROFILE & DECKS

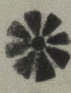"Borella" 

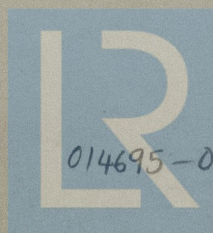

© 2021

014695-014703-0347

Lloyd's Register
Foundation

0347

HULL

Cook Welter & Gemmell & Co

Yard no 762

Profile & Decks

Office



© 2021

Lloyd's Register
Foundation