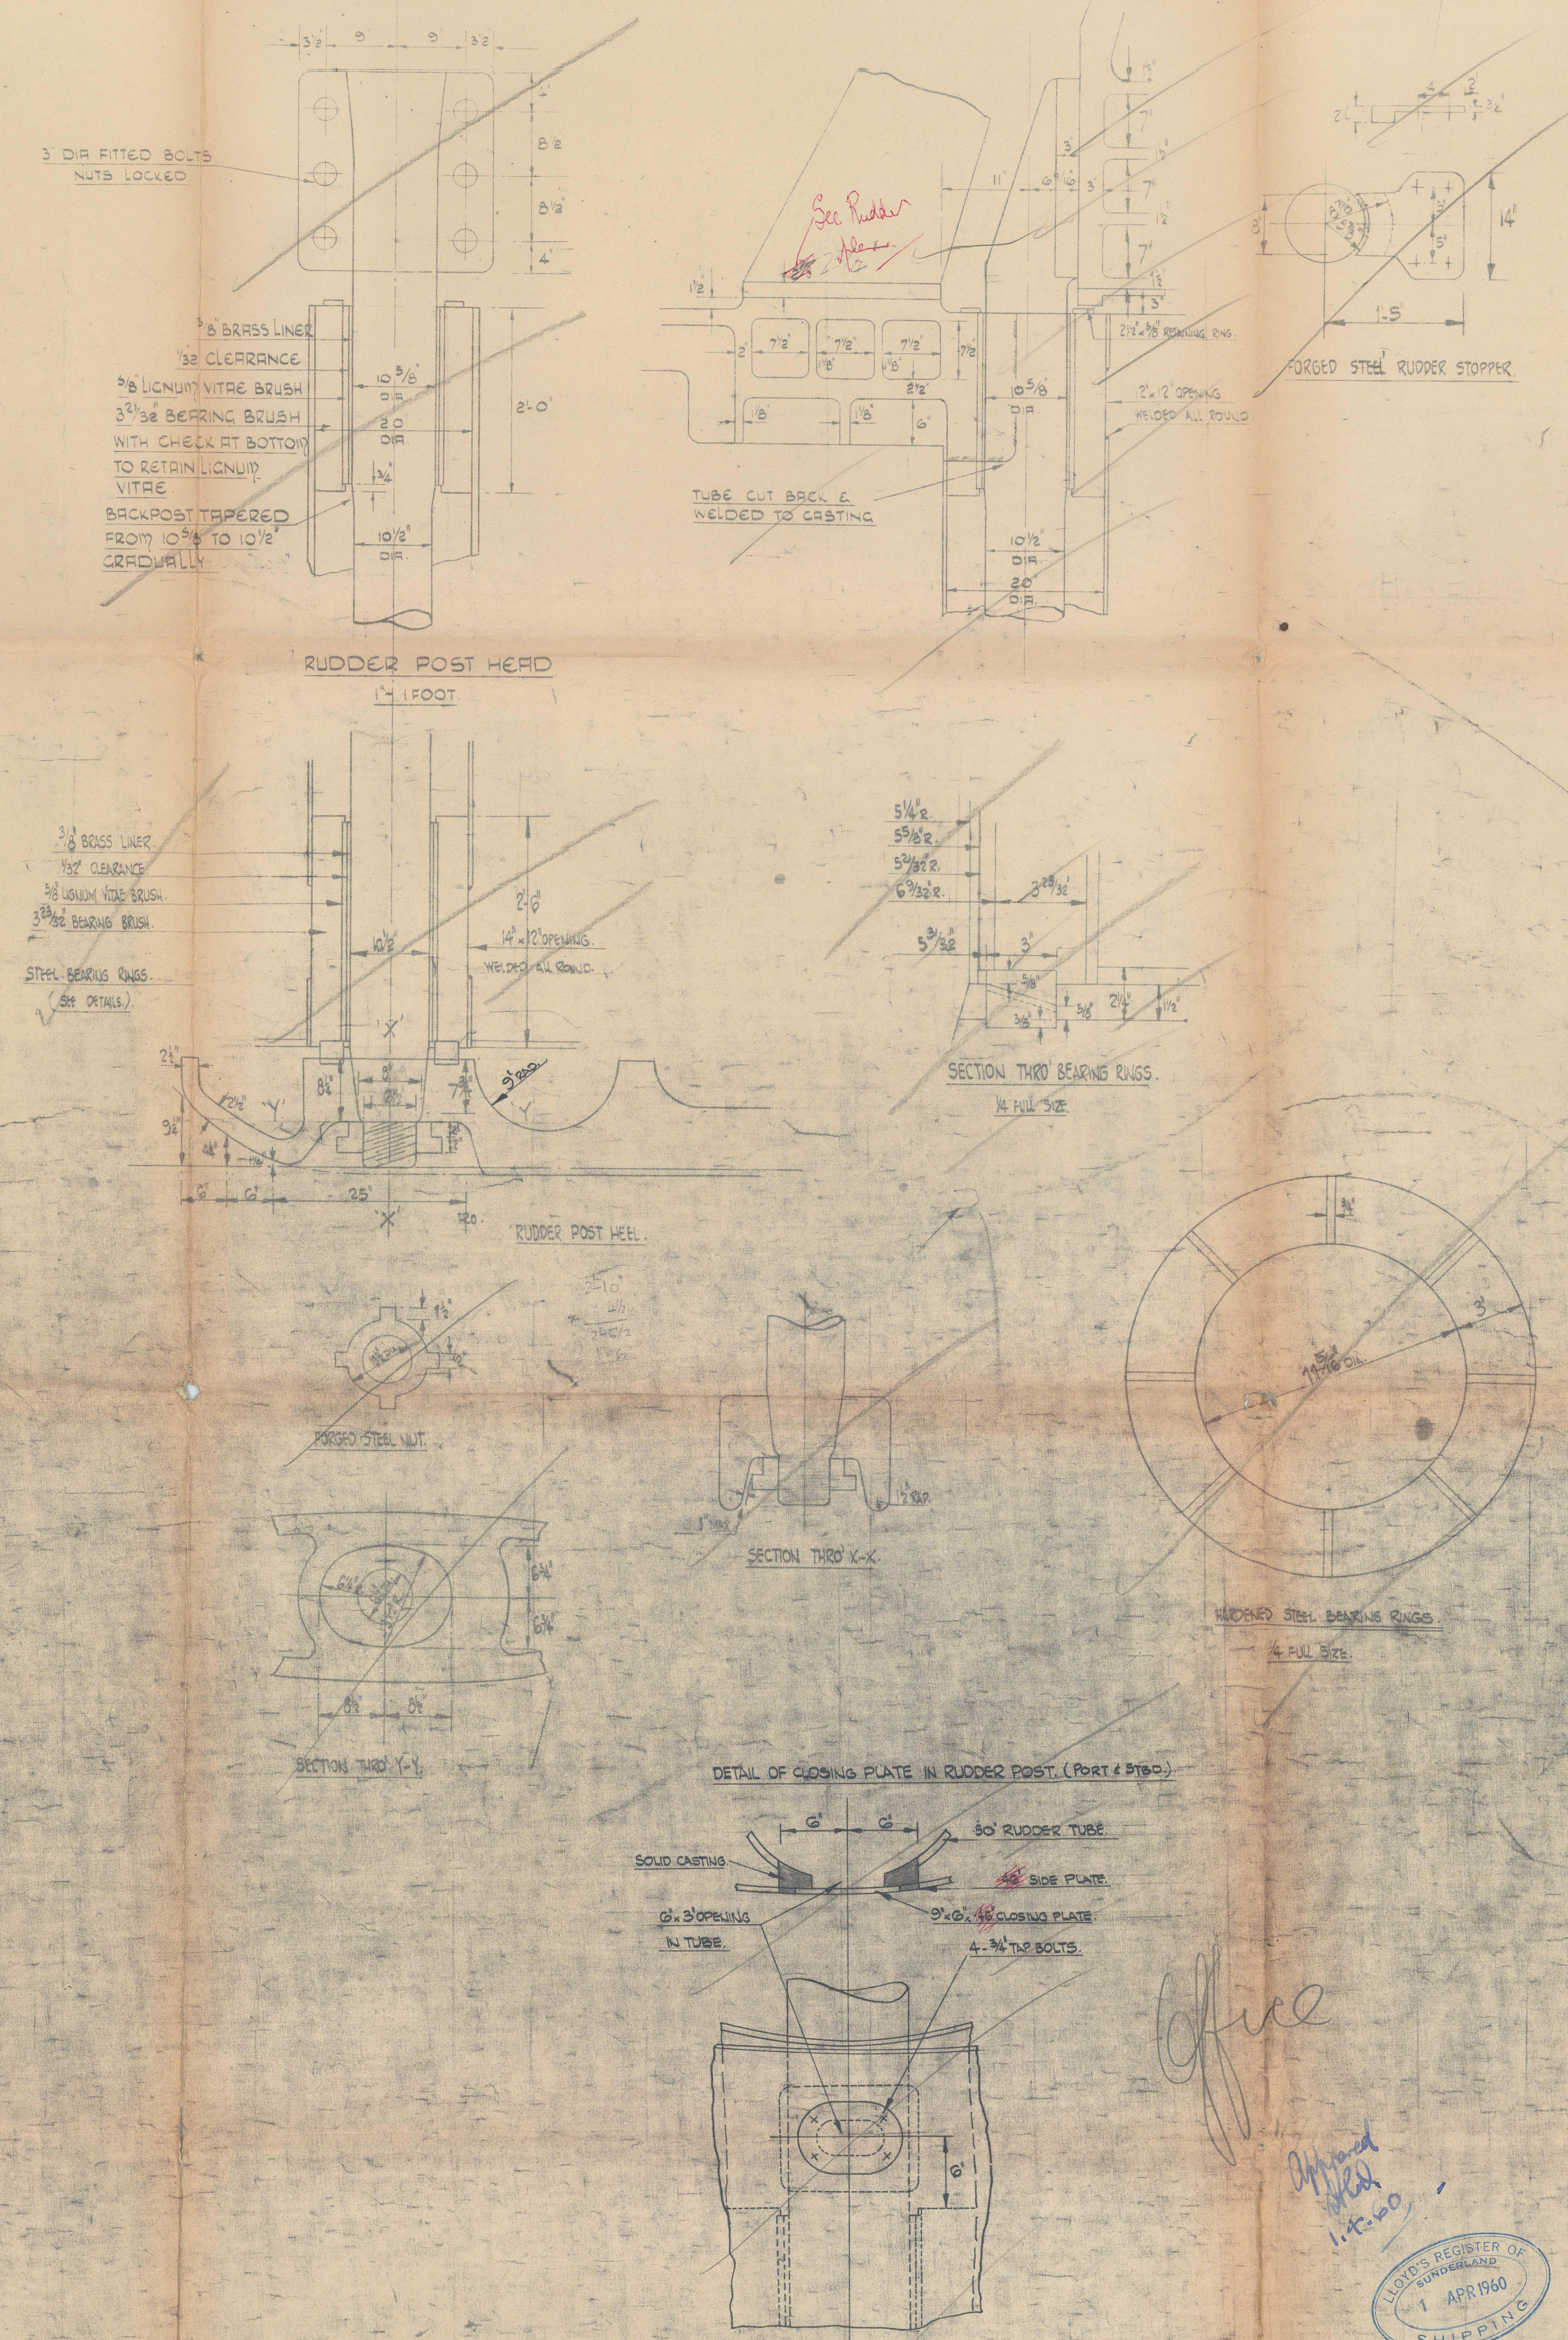
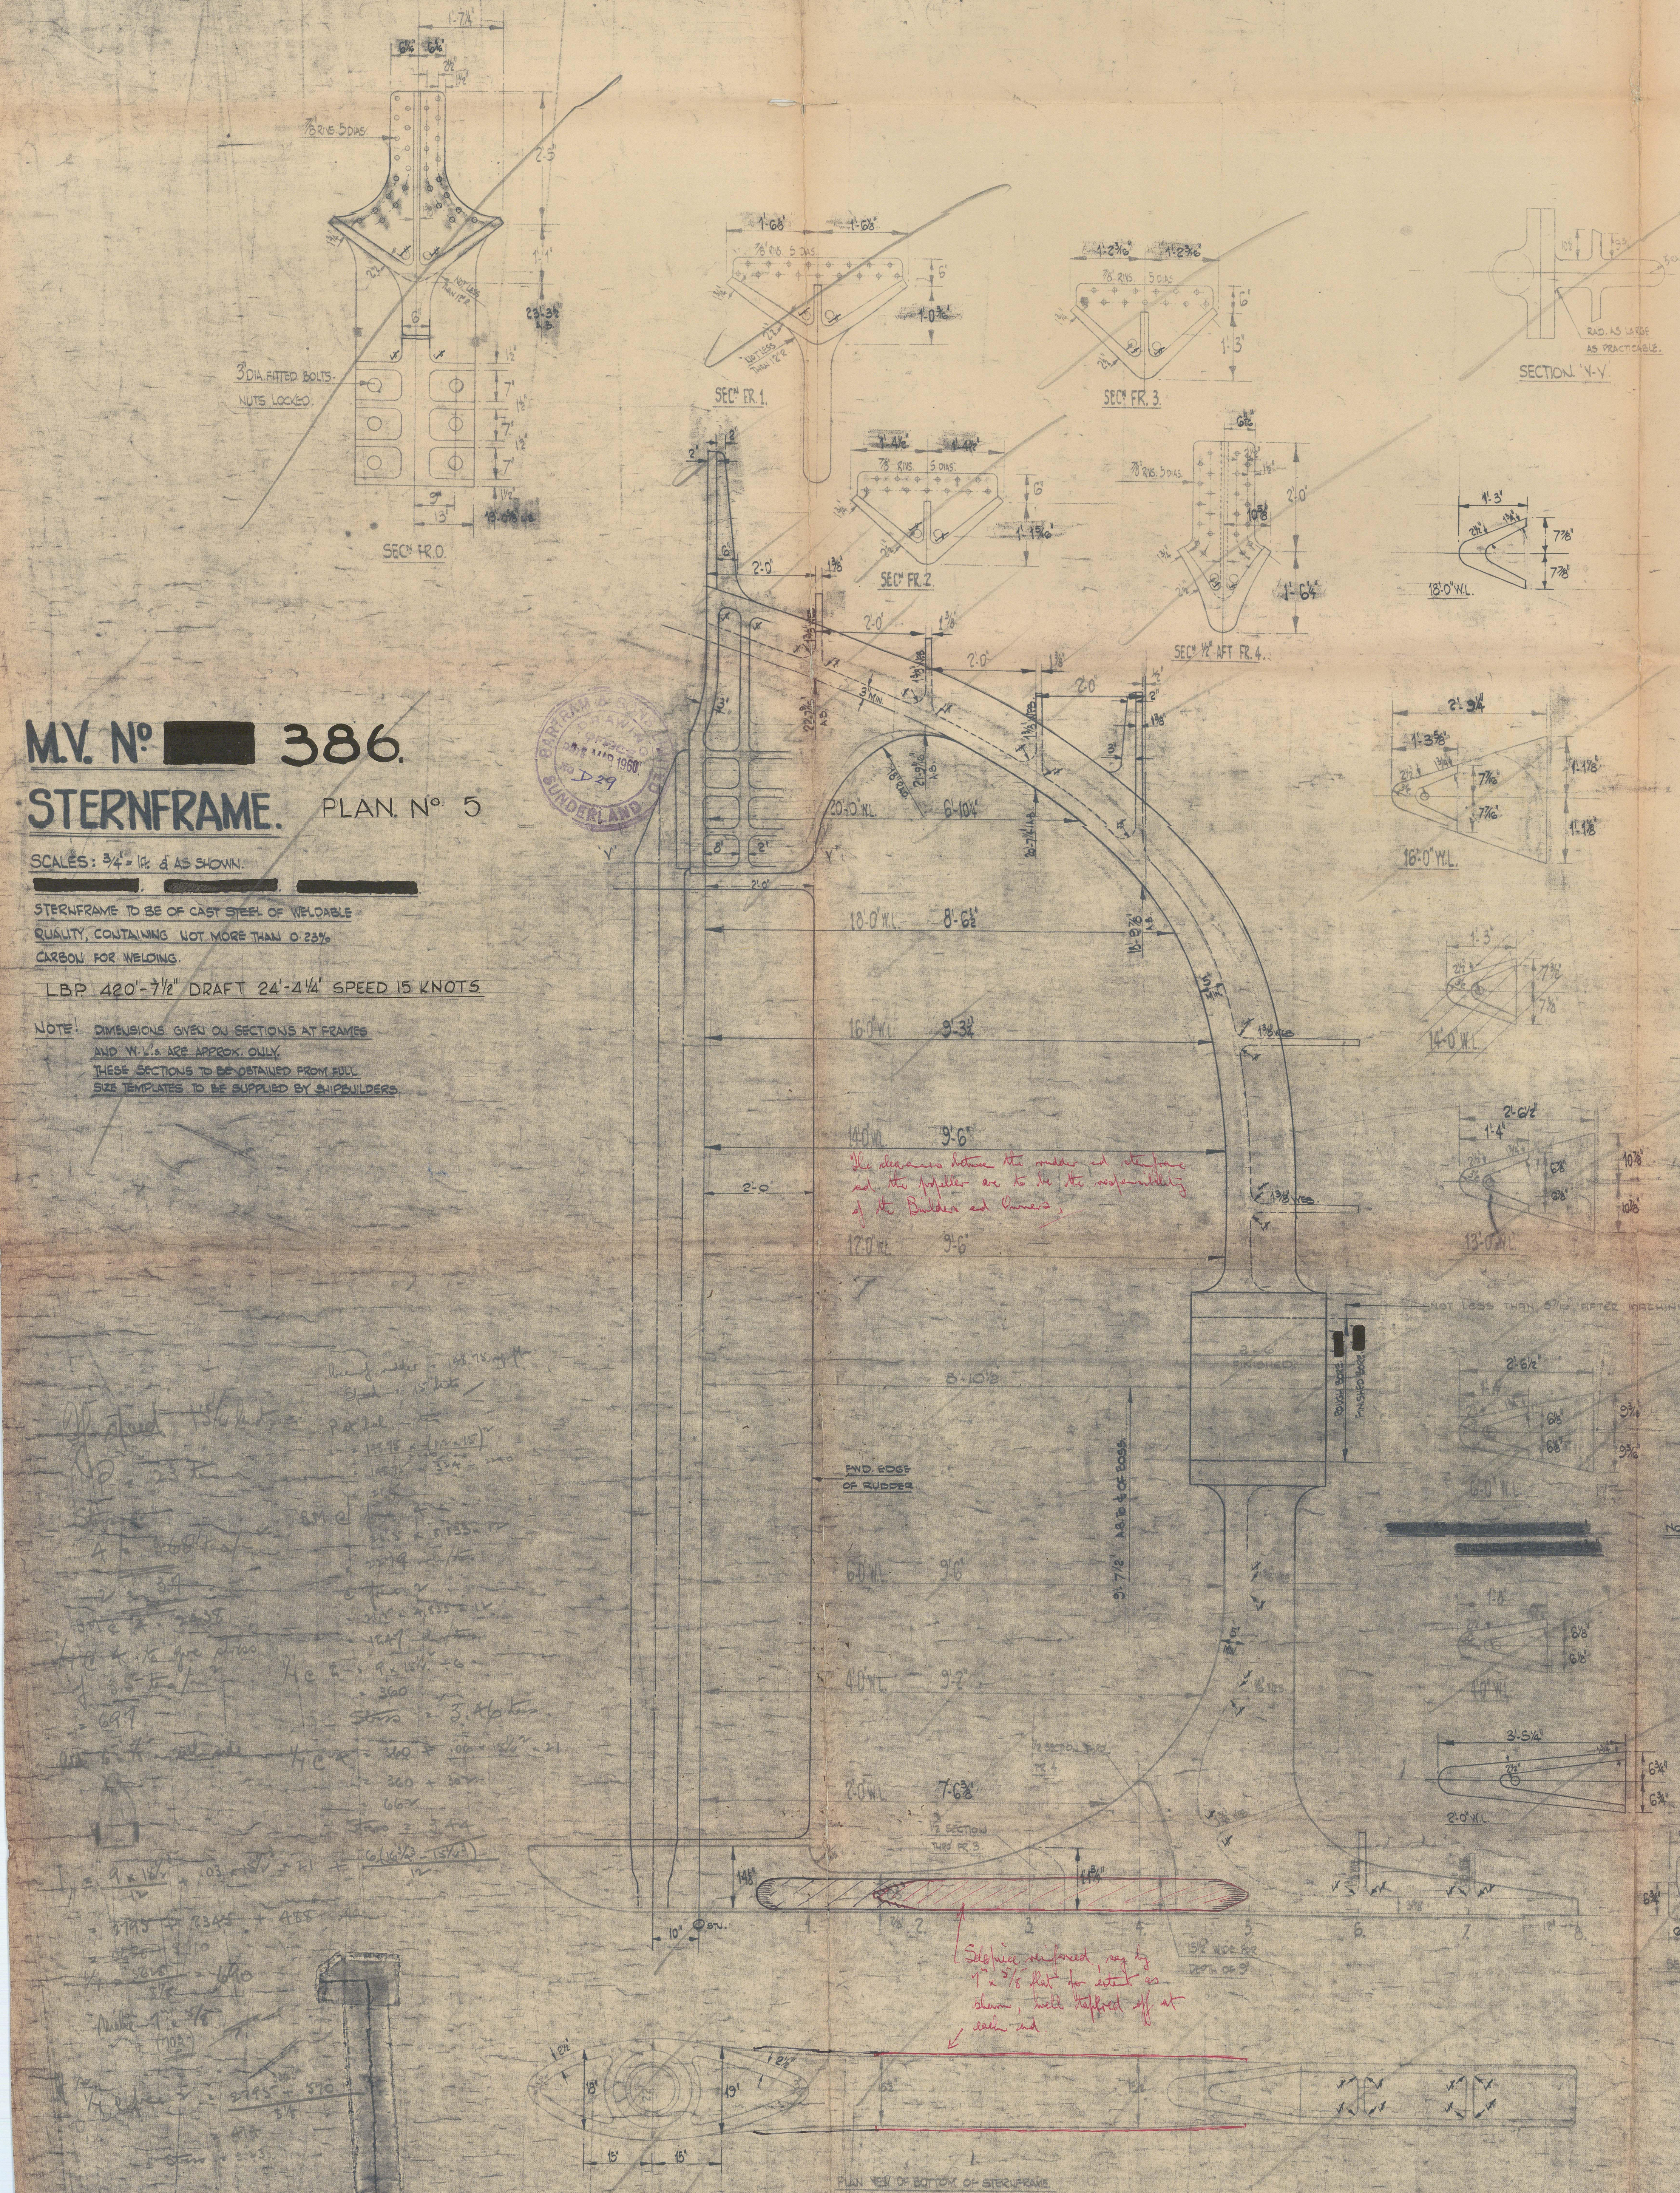


SCALES: $3/4 = 1/4$ d AS SHOWN.
[REDACTED]
[REDACTED]
[REDACTED]
STERNFRAME TO BE OF CAST STEEL OF WELDABLE
QUALITY, CONTAINING NOT MORE THAN 0.23%
CARBON FOR WELDING.
LBP 420' $\pm 7/8$ " DRAFT 24'-4 1/4" SPEED 15 KNOTS

NOTE! DIMENSIONS GIVEN ON SECTIONS AT FRAMES
AND W.L.'S ARE APPROX. ONLY
THESE SECTIONS TO BE OBTAINED FROM FULL
SIZE TEMPLATES TO BE SUPPLIED BY SHIPBUILDERS.

[illegible]

Chase

Approved
S.D.
1.4.60



4


BARTRAM & SONS, LTD

SHIP No. 386

Steinframe.

CONCORDIA - LAFD

EX
MONTROSE
SLD RPT. NO A38
SHIP 386

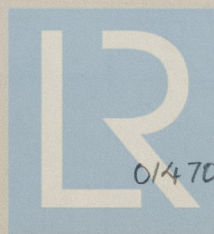

© 2021

Lloyd's Register
Foundation

014704-014711-0059