

PROFILE & DECK.

SINGLE SCREW SELF-TRIMMING COLLIER.

DIMNS:- 140'-0" B.P. x 21'-6" MLD. x 10'-6" MLD.


SCALE:- $\frac{1}{4}$ " = 1 FT.

A CLASS:- FOR SEVERN RIVER & ESTUARY WORK.
LIMITING PORT:- CARDIFF.


NO PILLARS TO BE FITTED IN CARGO HOLD.
PILLAGING ELSEWHERE TO SURVEYORS SATISFACTION.

See in the above
Class as instructed by Admiralty
100 At 'Coasting Service, Great Britain
& Ireland'
(See letter 18/8/42)



ALL BUTTS & SEAMS ON POOP DECK
DECK SINGLE RIVETED.

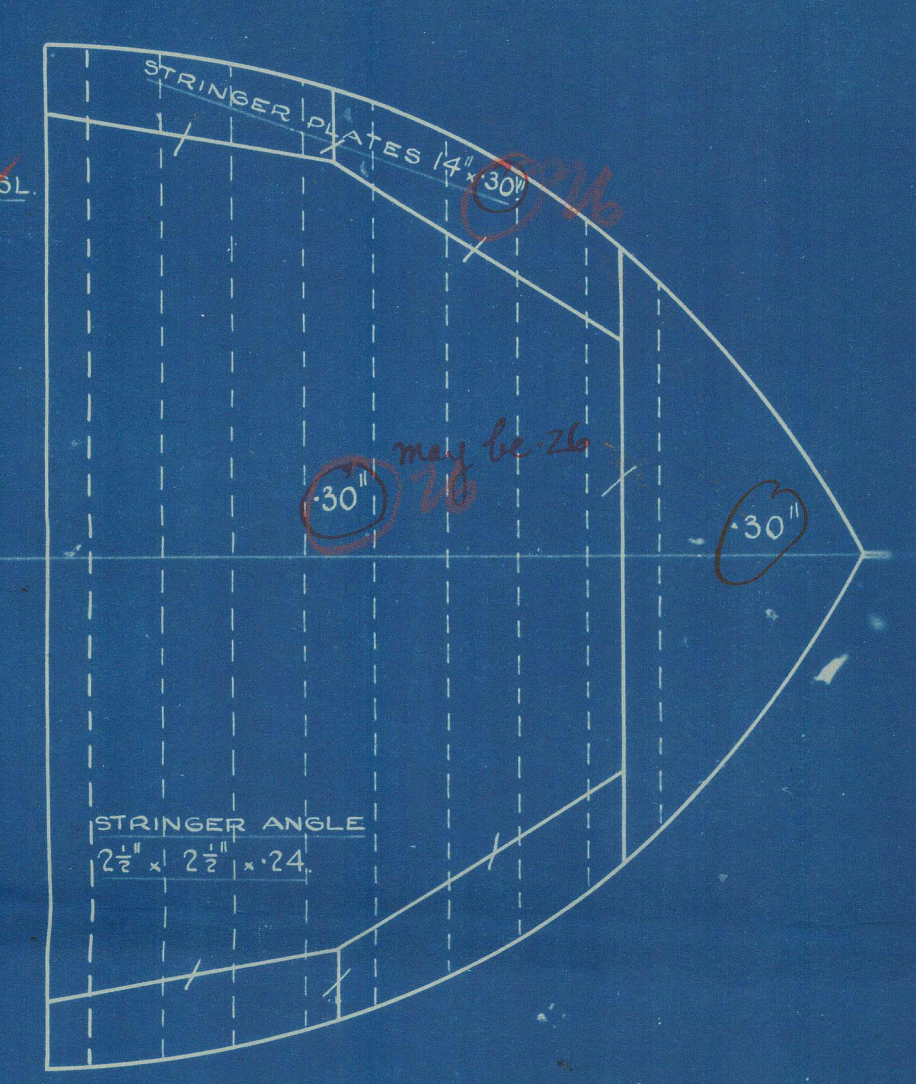

FORECASTLE DECK.
SIDE PLATING 24'.

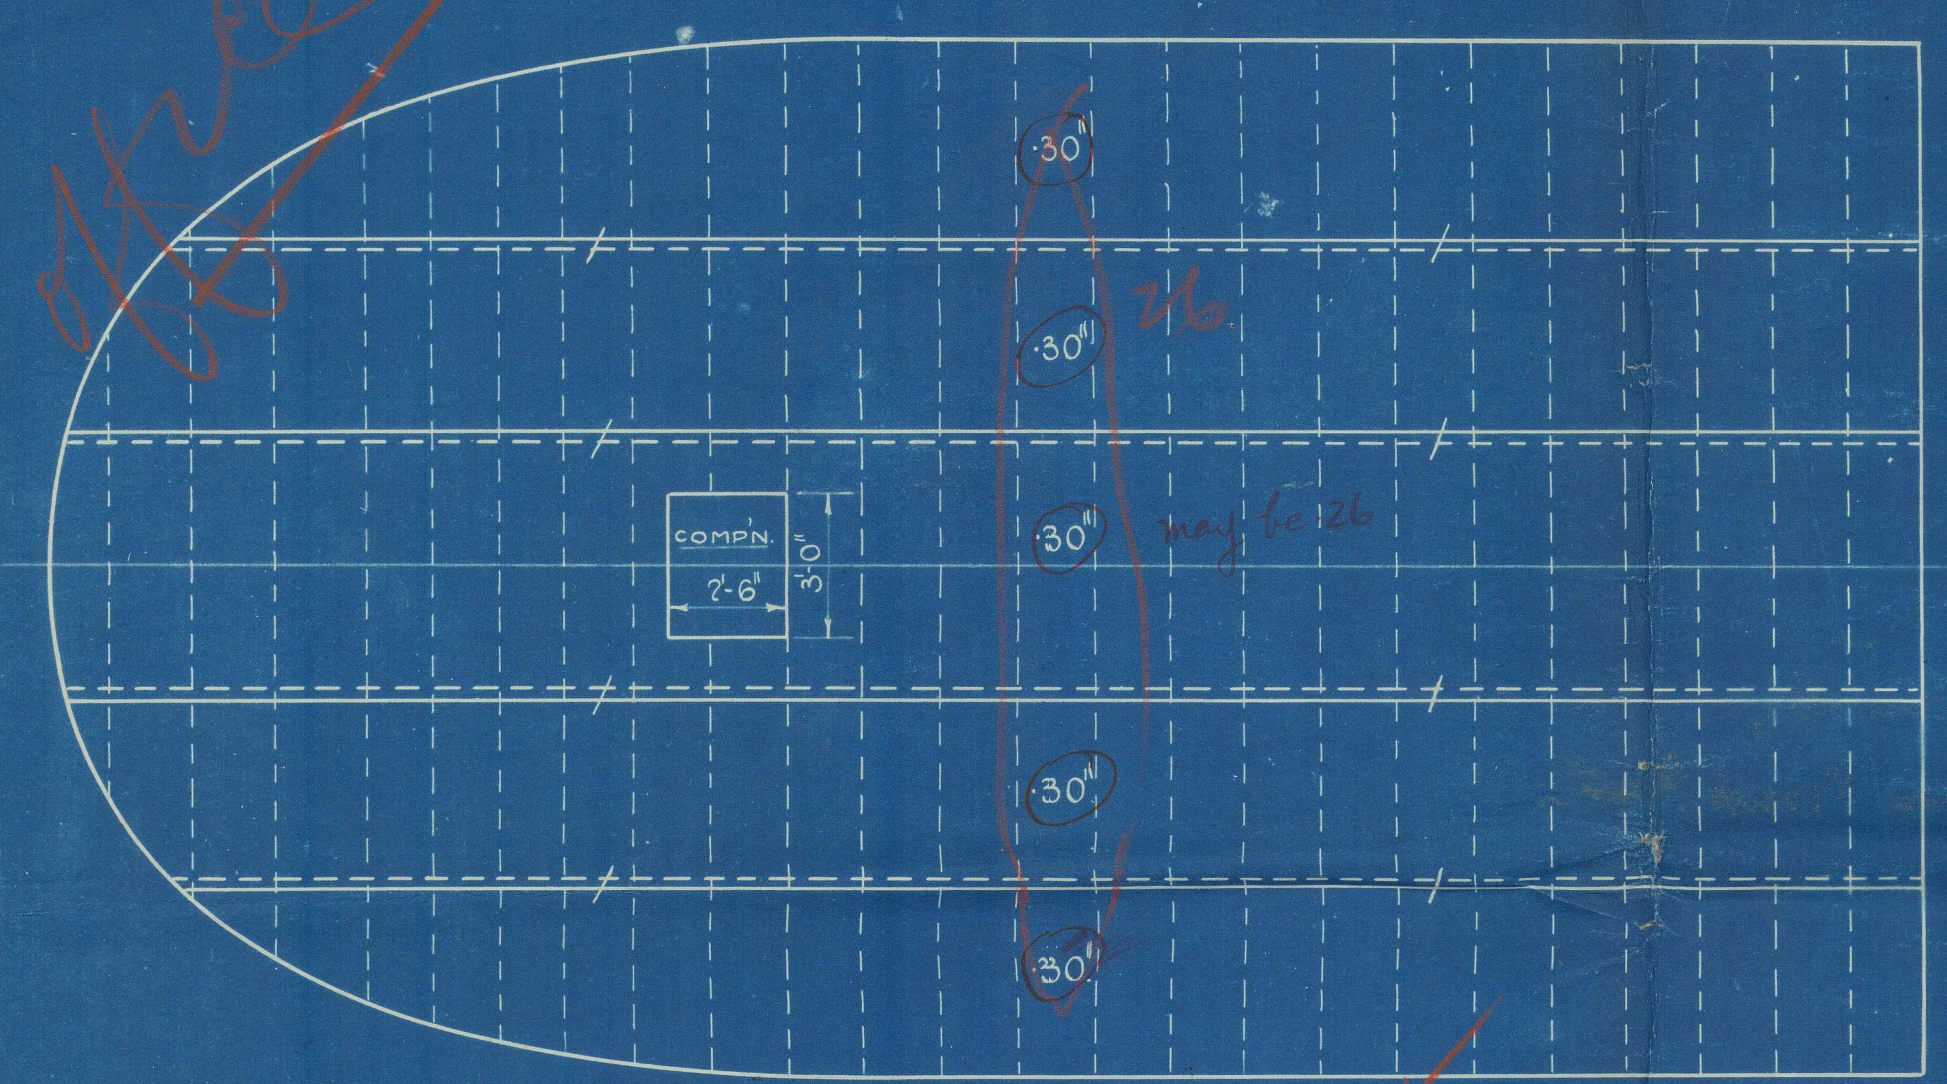

POOP DECK.
SIDE PLATING 24'.

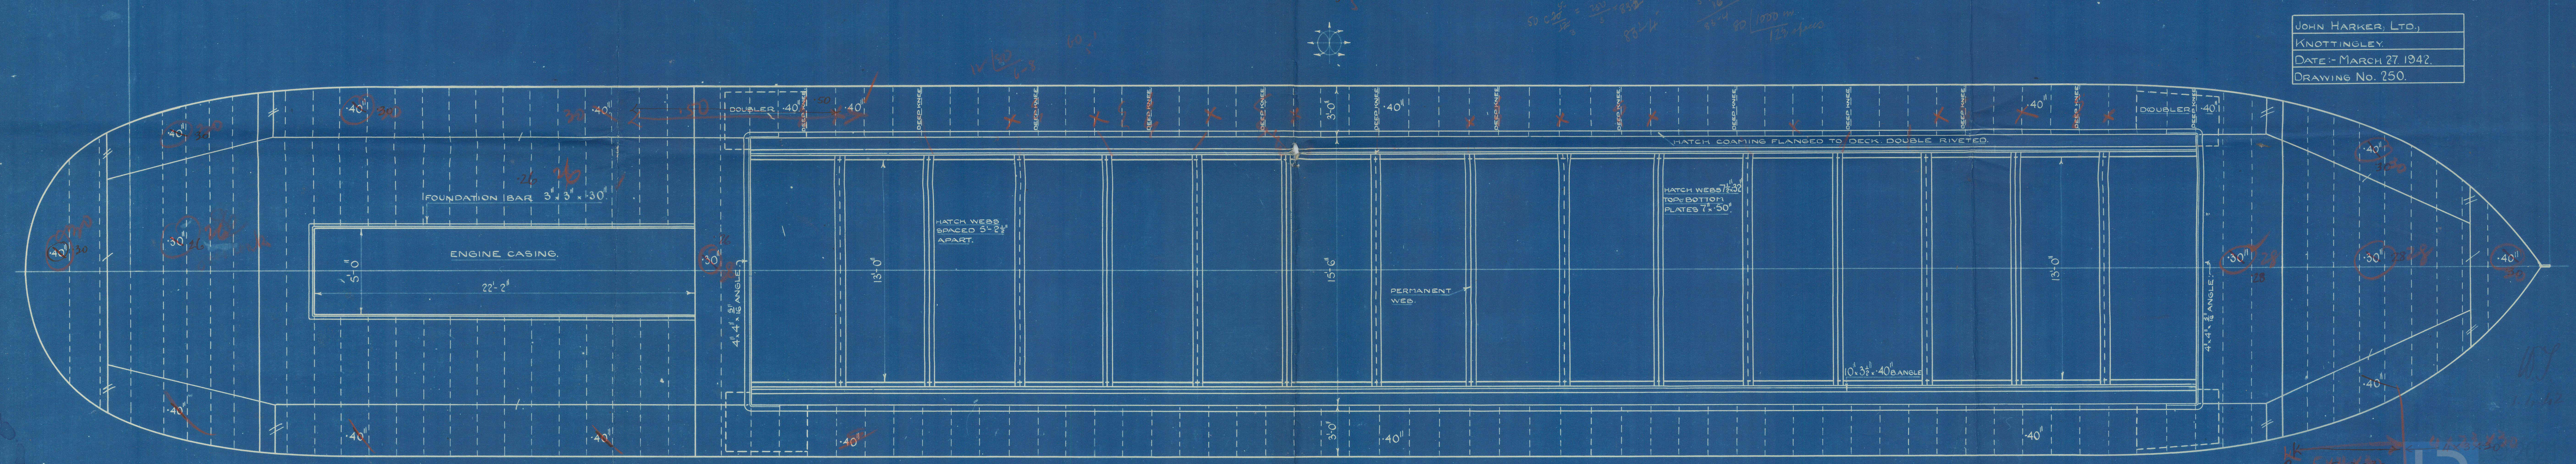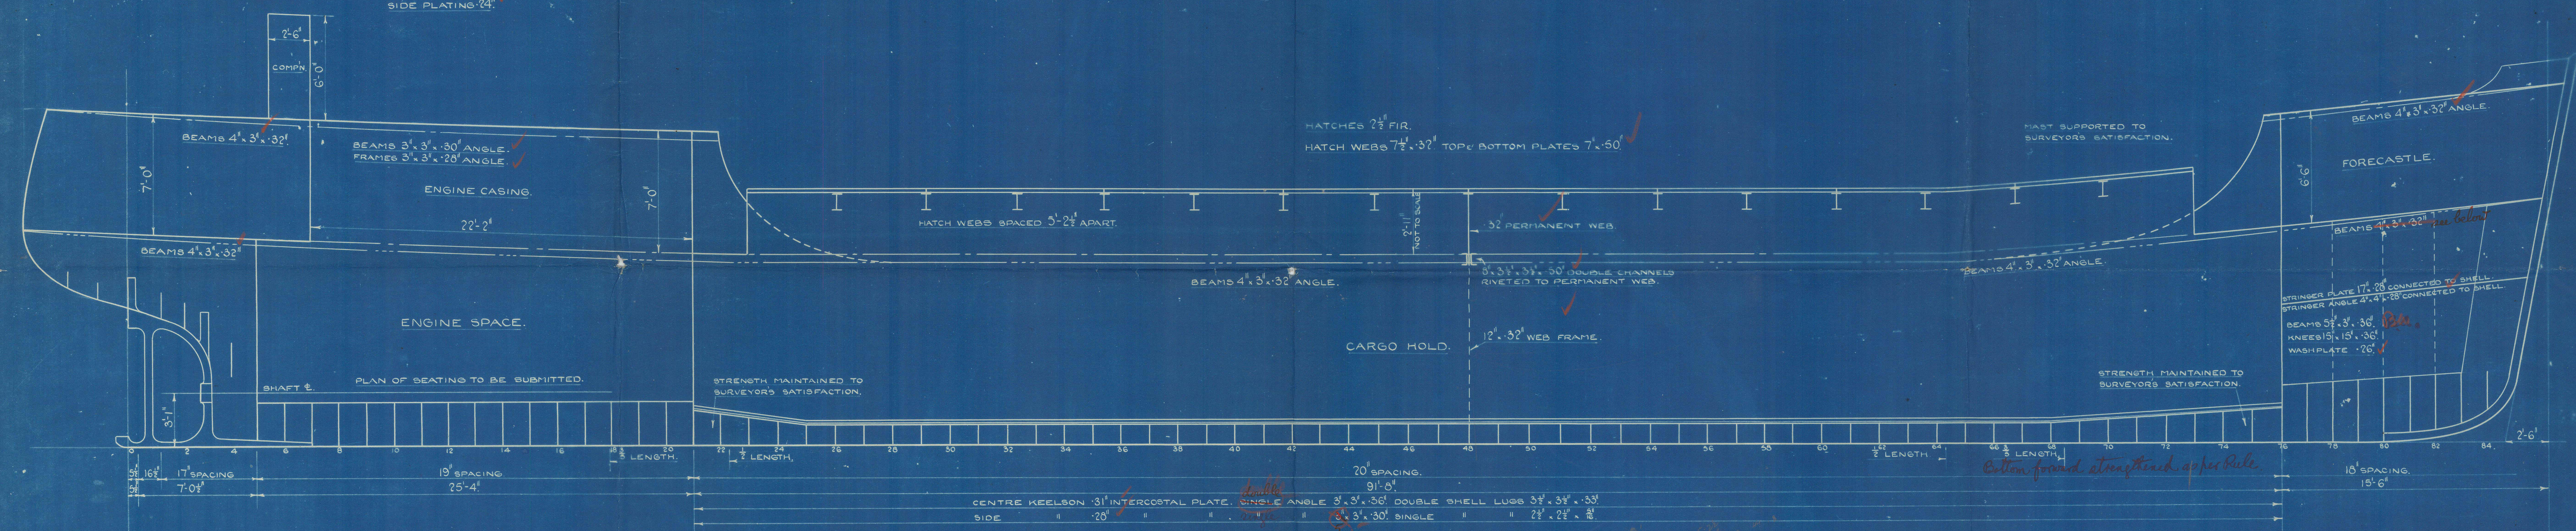

JOHN HARKER, LTD.,
KNOTTINGLEY.
DATE:- MARCH 27, 1942.
DRAWING No. 250.

RECORDS DEPT.
LONDON

Profile & deck
John Harker Ltd
Yd. nos. 146/7

6

78

HULL

John Harker Ltd
Yard no. 146/7
A/MS 474/5
Profile & Deck

Lennyw
Ex
Moreton Corbet

146/7
John Harker self trimming colliers
Profile & deck

App'd
11/10/22



© 2021

Lloyd's Register
Foundation

014738-014750-0002