

15.4.14
20.4.14
1.5.14
29.10.14



SINGLE SCREW HOPPER BARGE.

DIM. 170'-0" 30'-0" 15'-0" M^{LD}.
LLOYD'S CLASS 100.A1. HOPPER BARGE. +

No 428

ENGINE AND BOILER CASING.

COAMINGS.	30
SIDES.	26
TOP.	24
DECK ANGLES.	3x3x30
STIFFENERS.	3x2 1/2 x 26
BEAMS.	4x2 1/2 x 26
CORNER ANGLES.	2 1/2 x 2 1/2 x 24



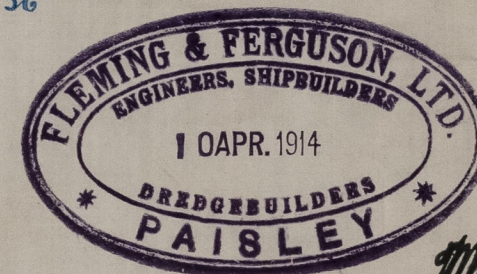
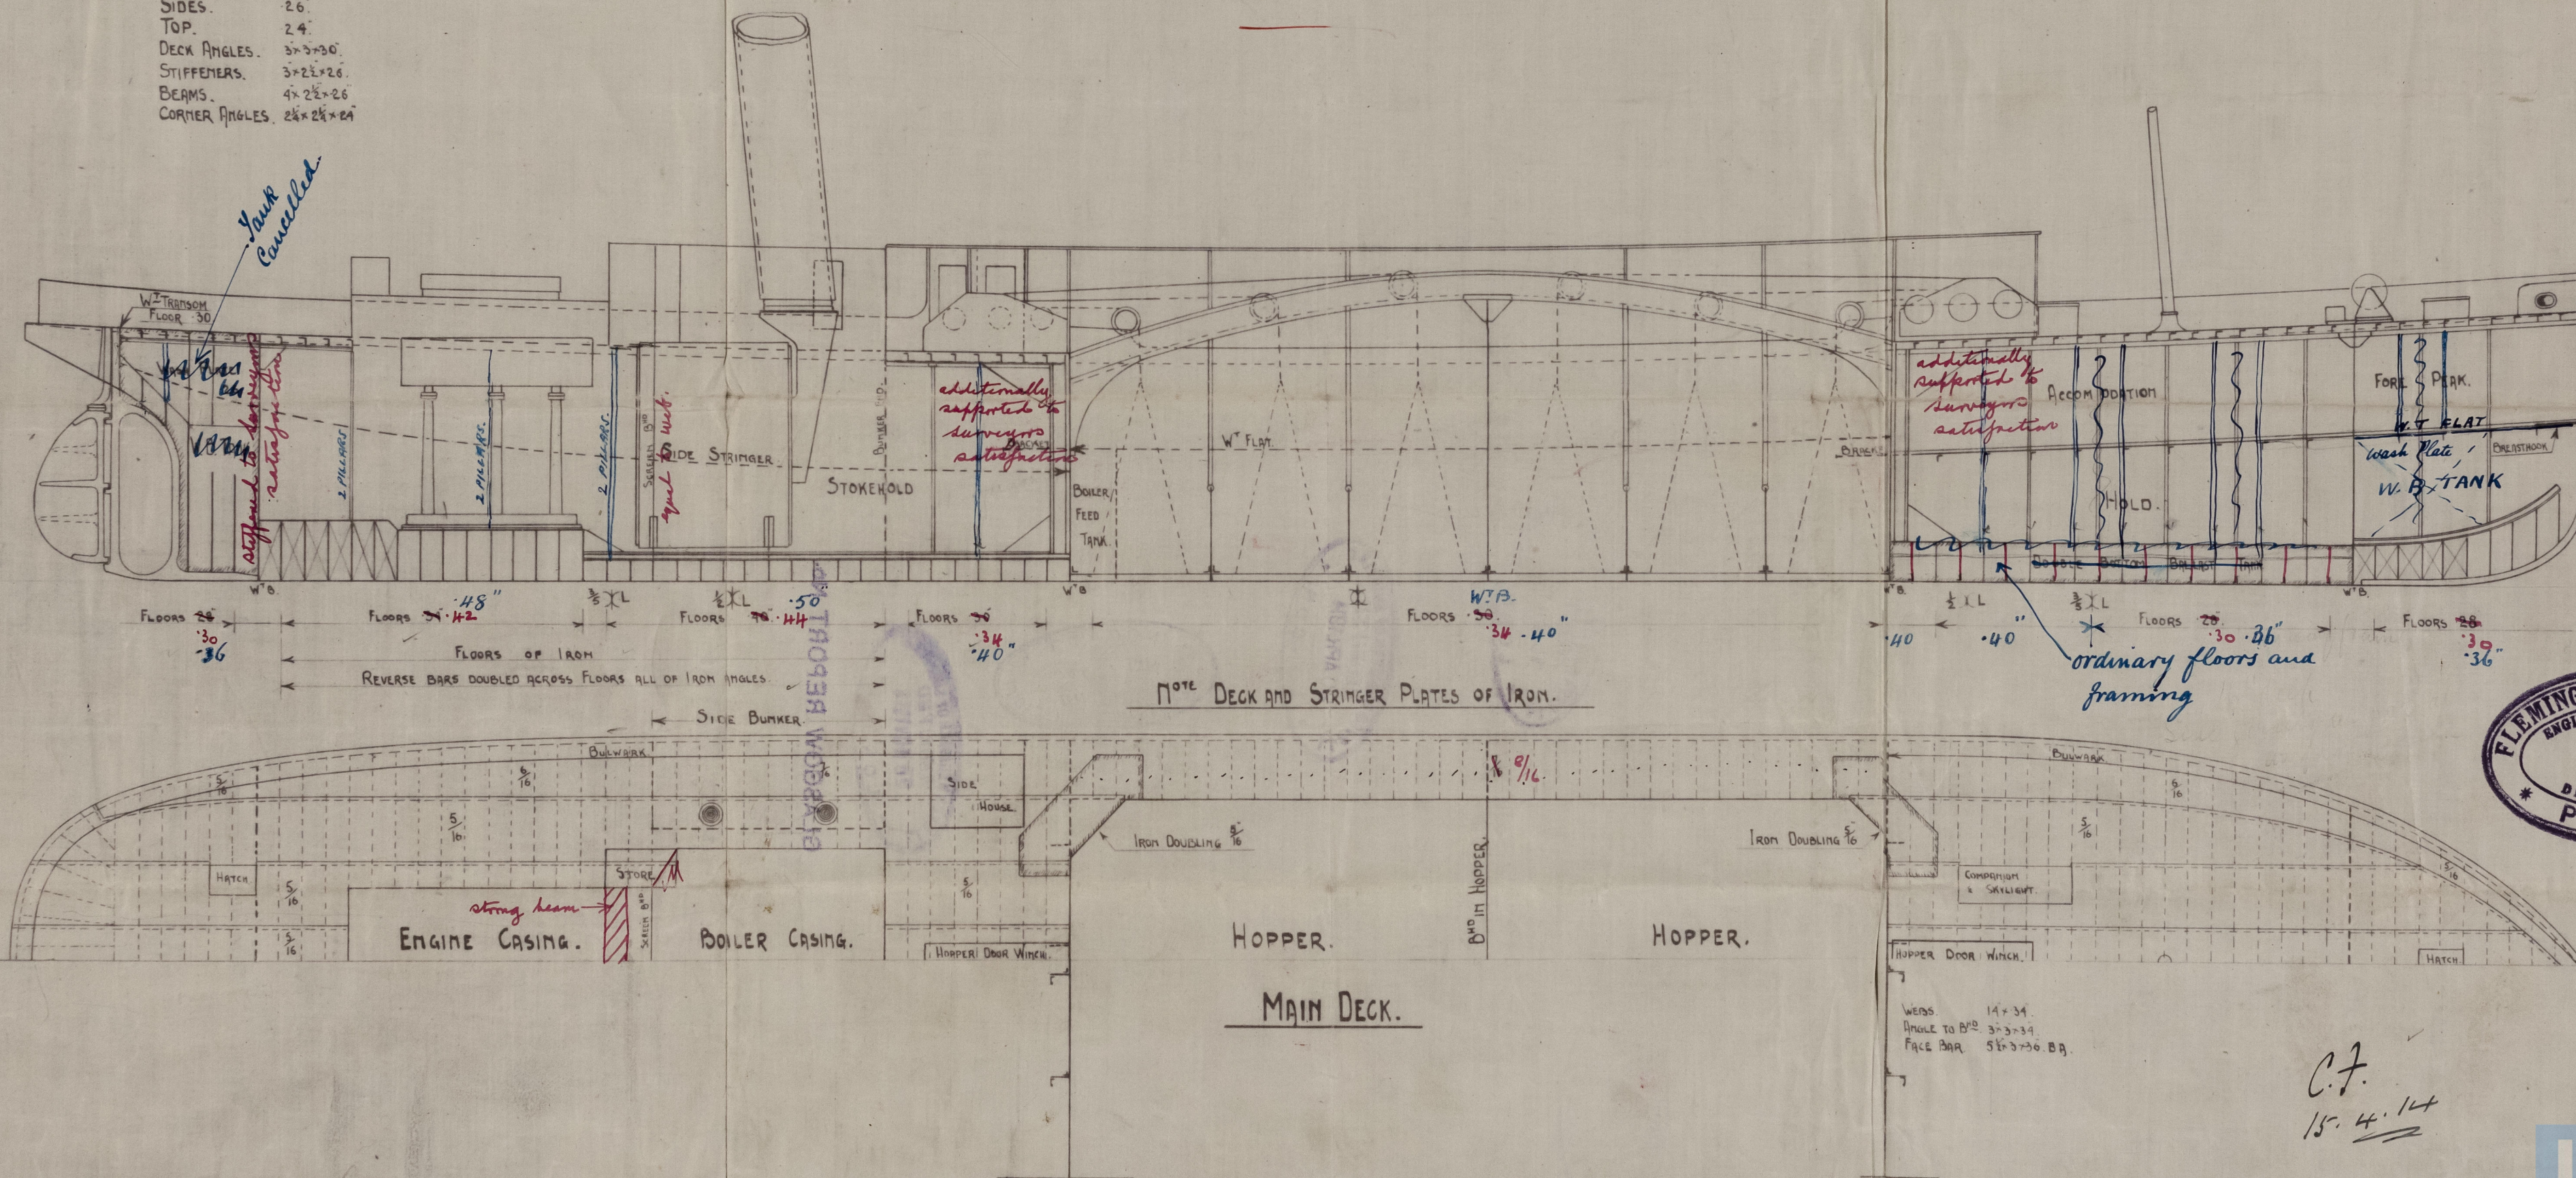


C.F.
15.4.14

Fleming & Ferguson Ltd
Hopper Barge.

No. 428

Profile Deck Plan.
Joseph F. Smith

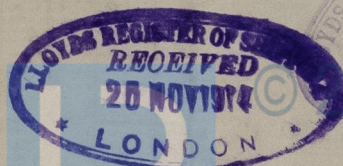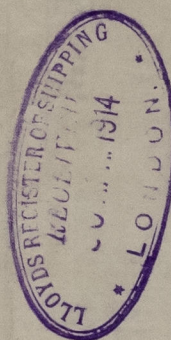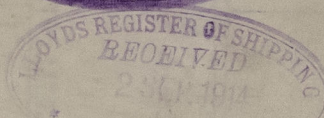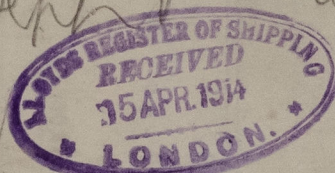

GLASGOW REPORT No. 34609.

014738-014750-0057