

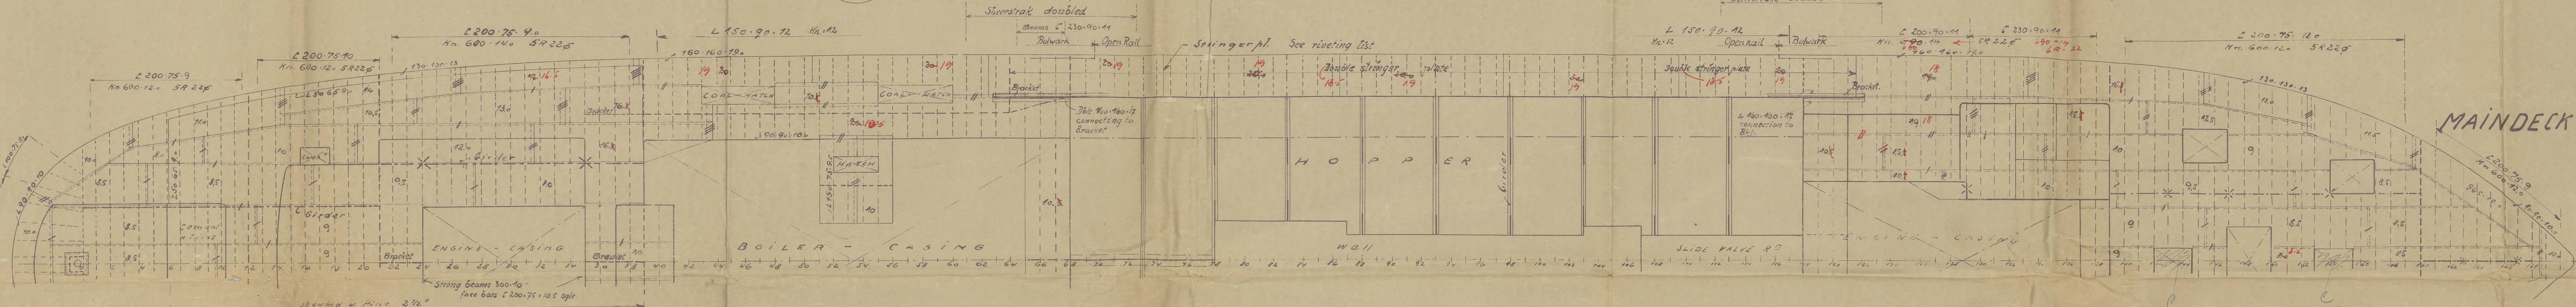


BOAT DECK

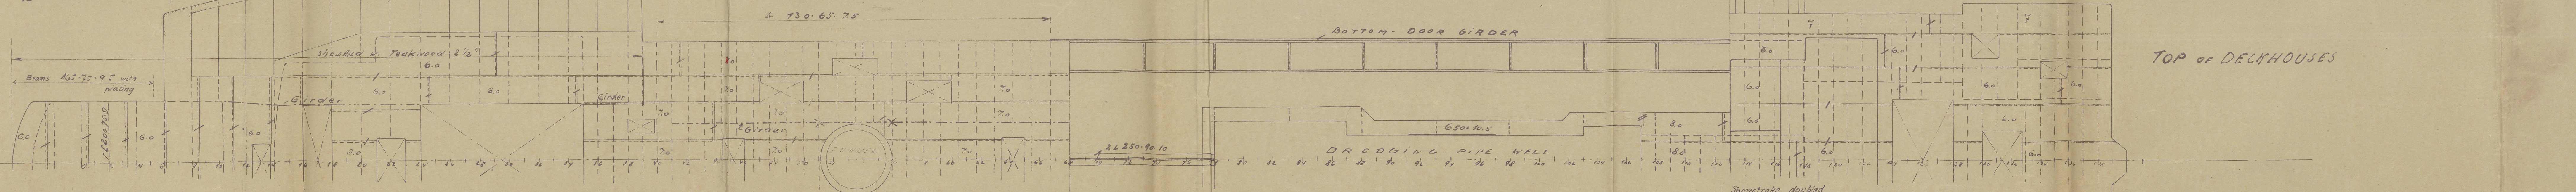


MAINDECK

CLASS: Lloyds Register +100 A1 Hopper Dredger  
 Length betw perp. 360'0" = 109.726 m  
 Breadth mid 60'0" 18.288 m  
 Depth 26'6" 8.077 m  
 Draught 18'0" 5.486 m

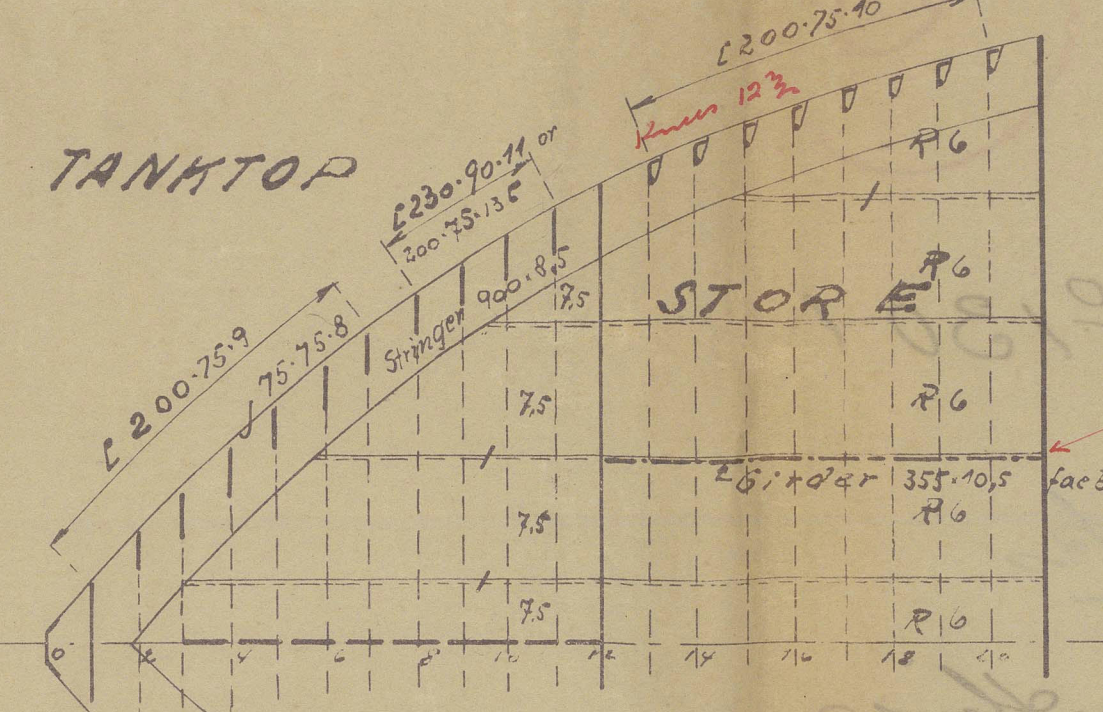

TANKTOP

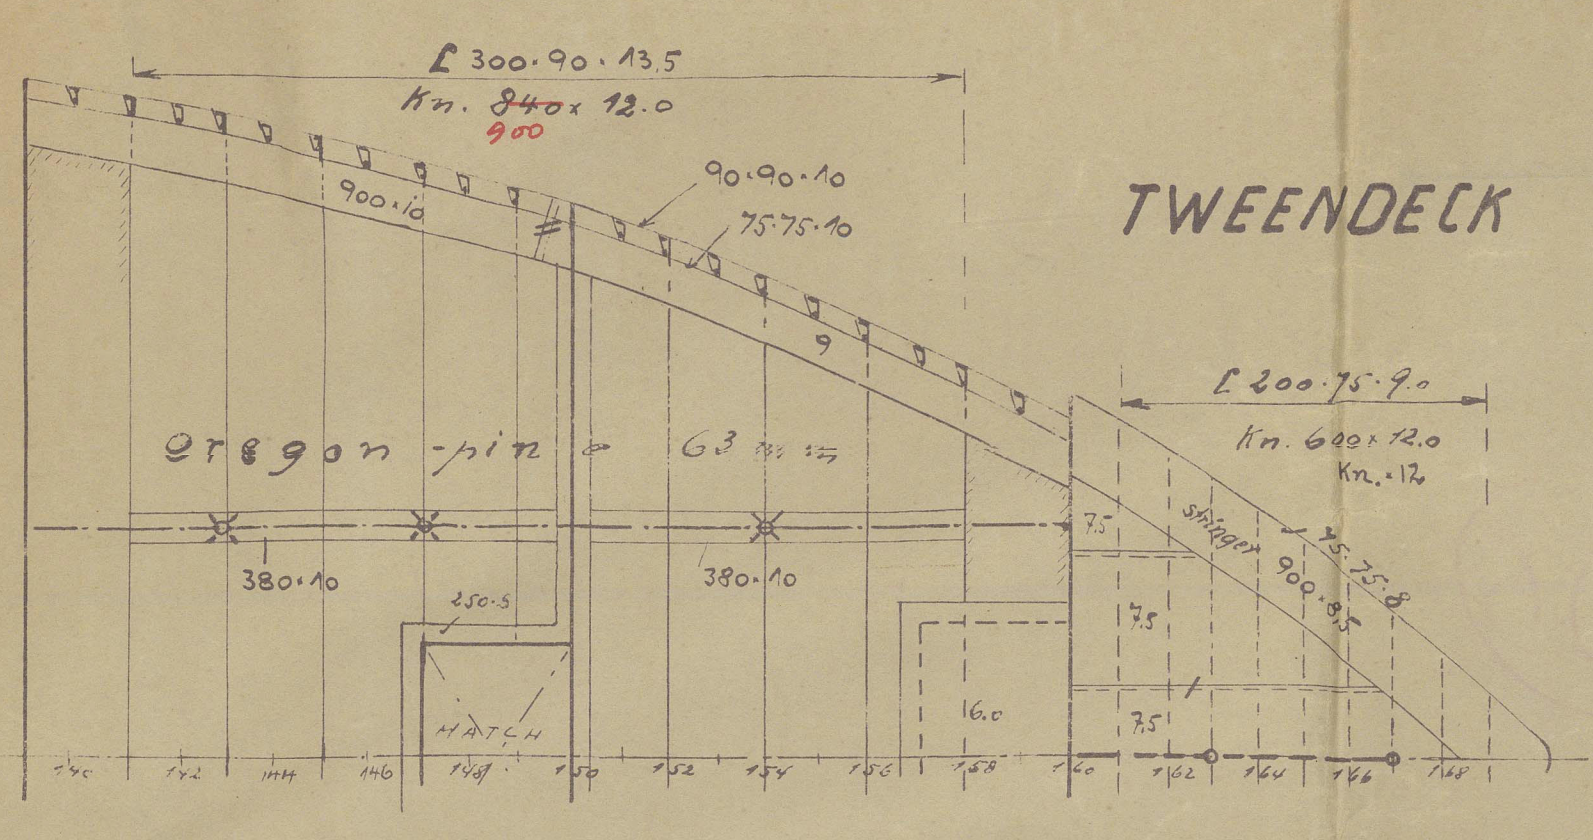


TWEENDECK

S. 1301

TWIN-SREW-STEAM-SUCTION-  
HOPPER-DREDGER.

LONGITUDINAL PLAN OF SCANTLINGS.  
SCALE 1:100.

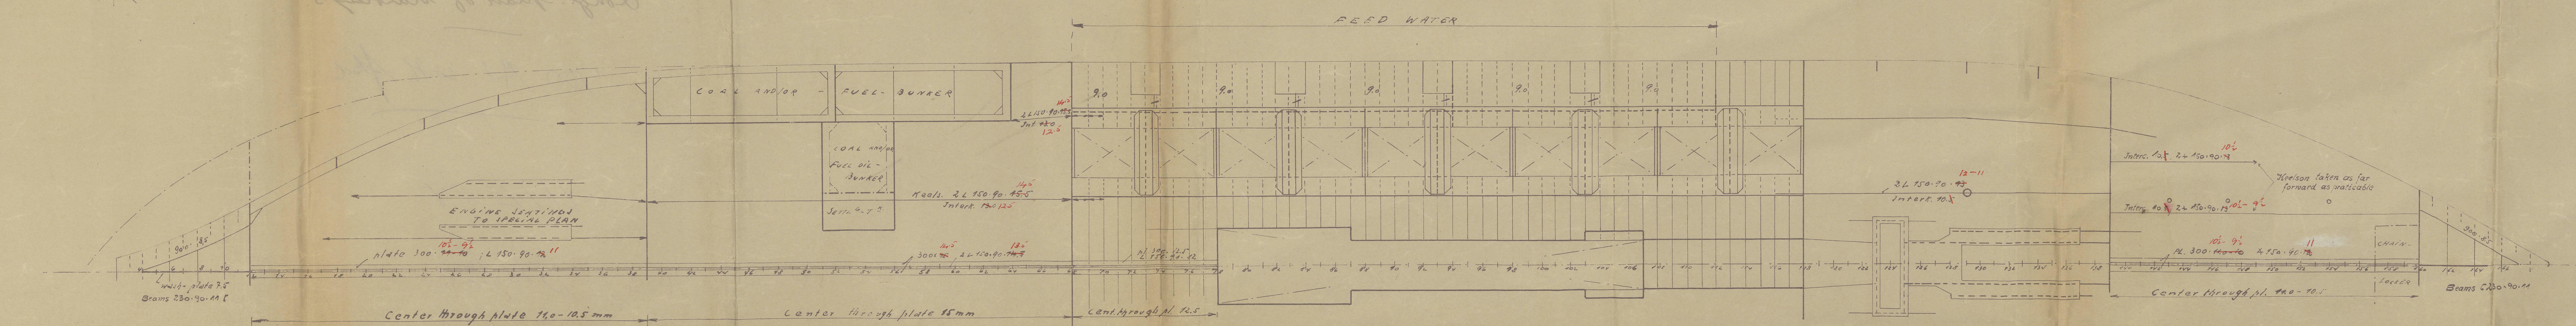

F. Schichau G. m. b. H. Elling  
 Abt. Schiffbau zu Danzig

19.11.33

PLAN 1301/3



GEN. BOX NO

749

SEICHAN

1301

(38)

"CHIEN SHE"

Longl. plan B  
searchings -

100 A.1  
with fhd.

1500-964710-154710



© 2021

Lloyd's Register  
Foundation



31.1.1949

749

6

SCHICHAU N<sup>o</sup> 1301

Profile & Dks  
Longl. plan of scarpings.

100 A1. with Ahd.

CHILEN

SHÉ



© 2021

Lloyd's Register  
Foundation