


110

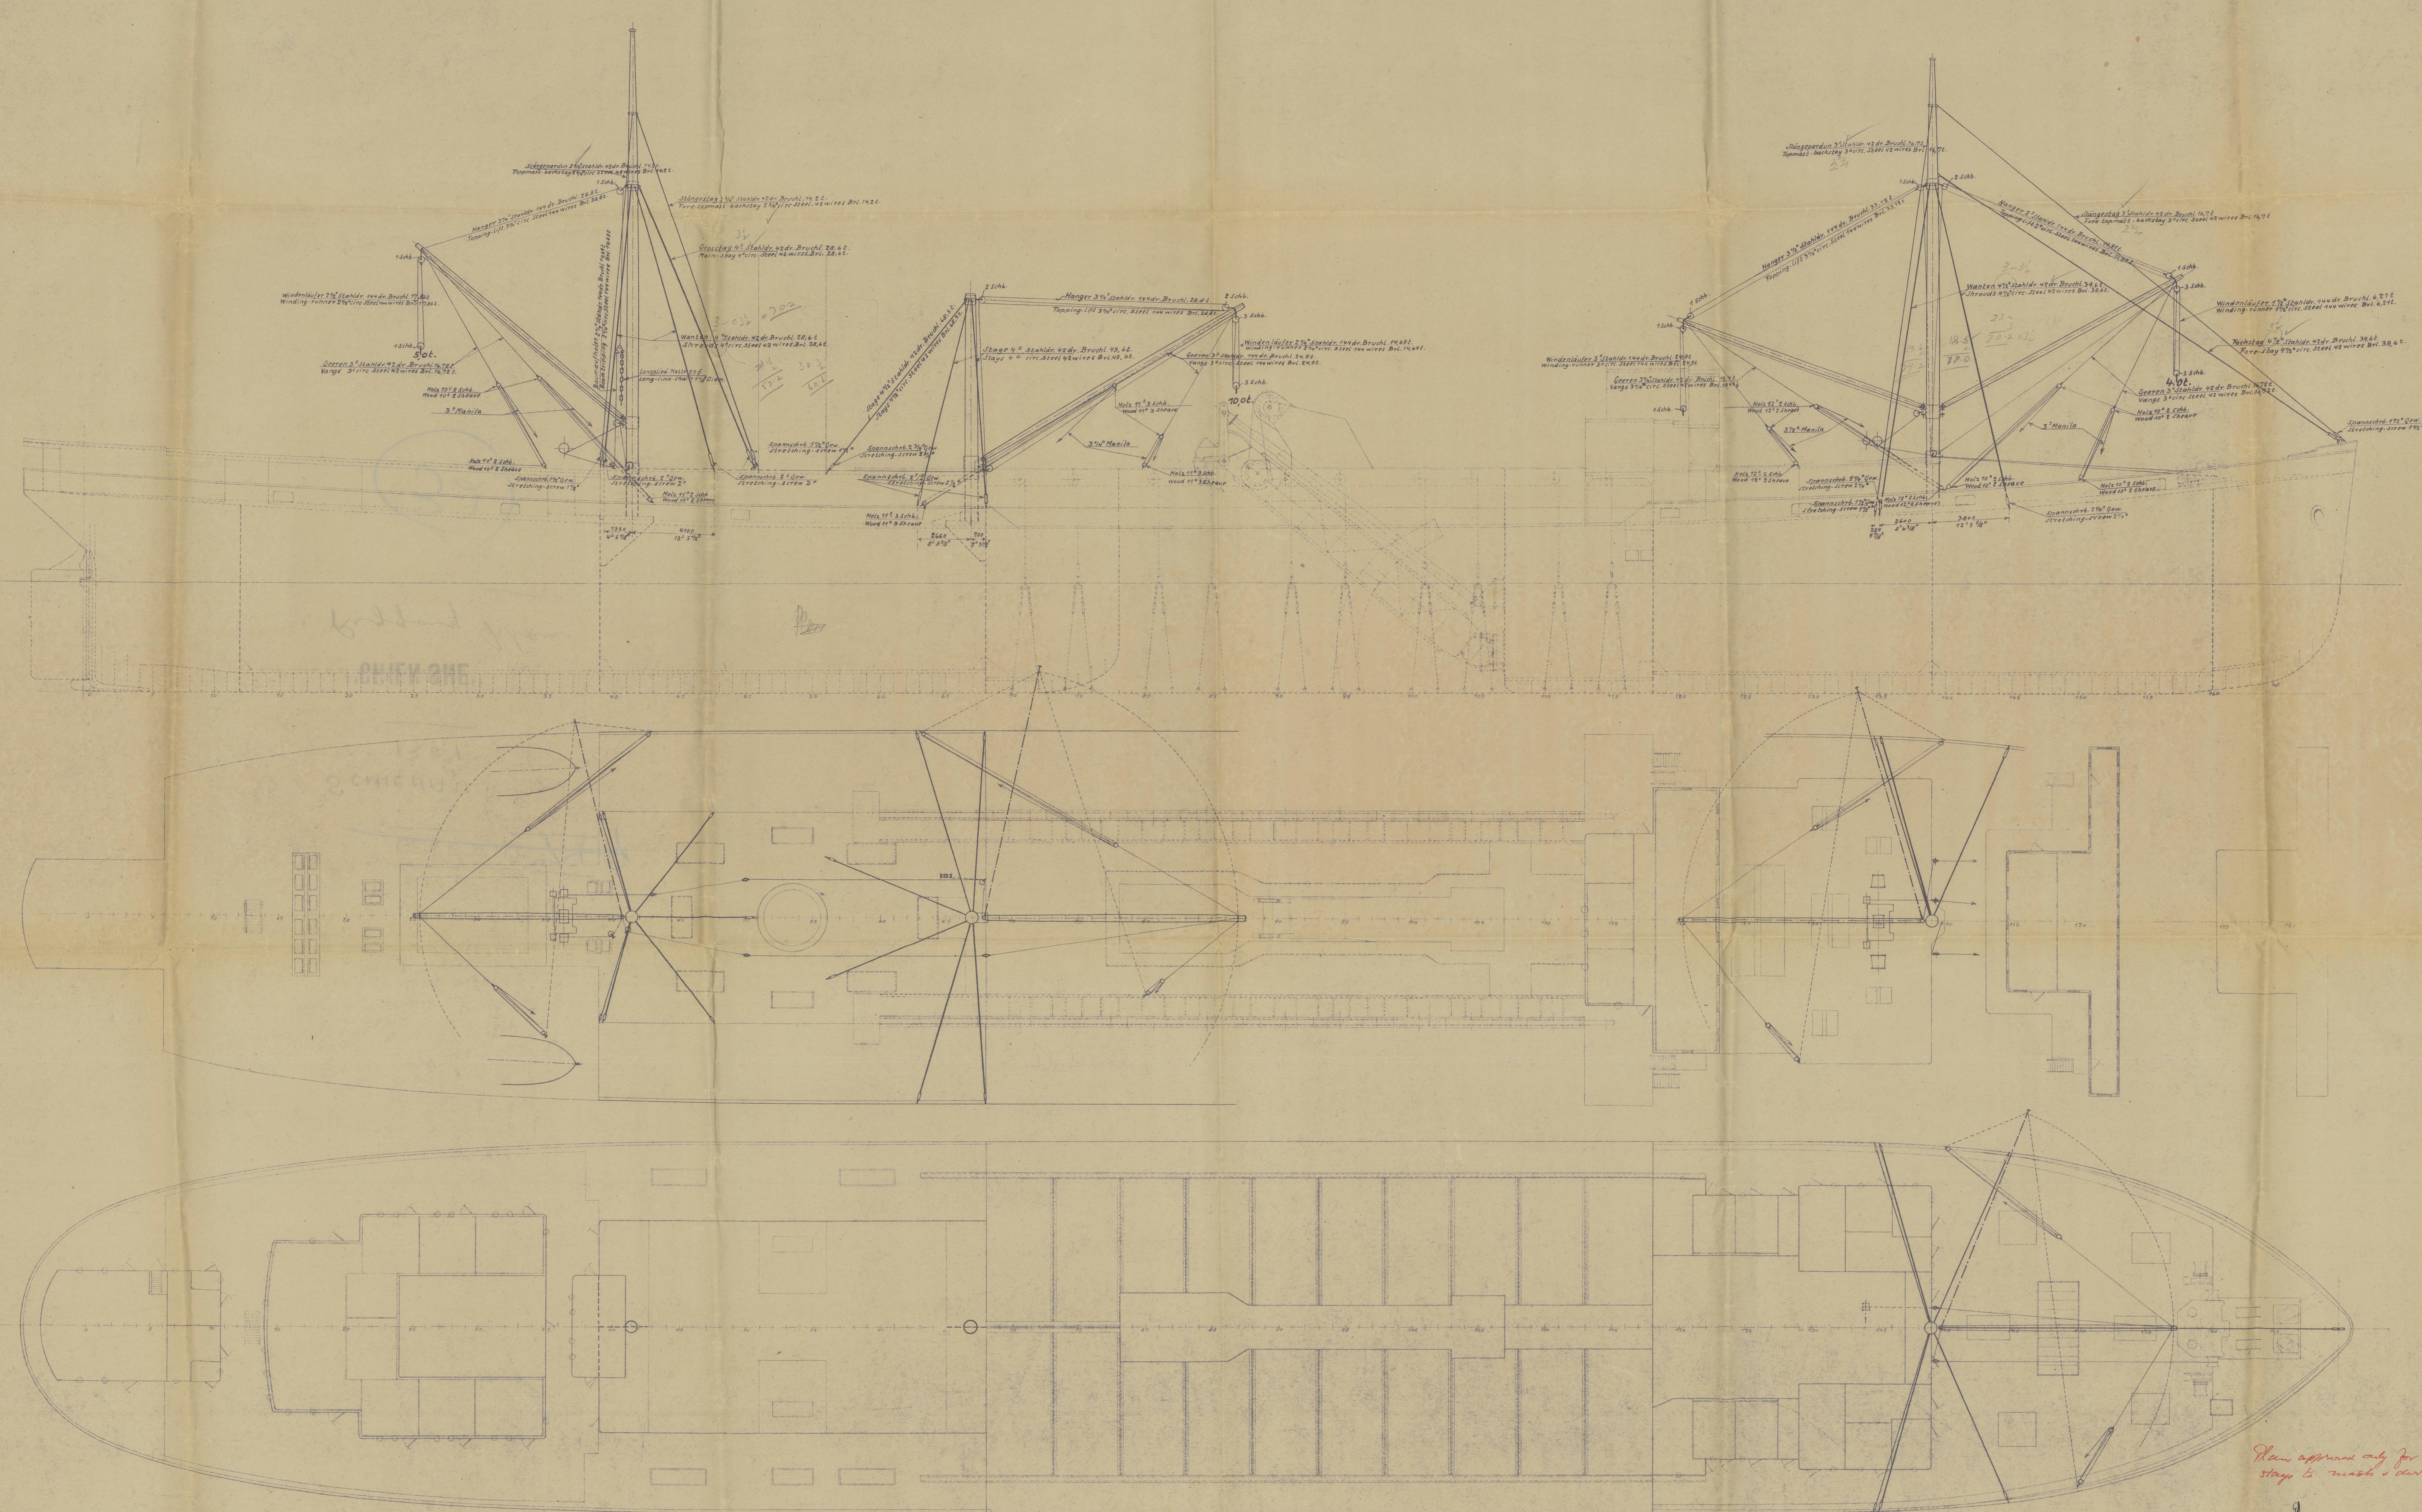

S.1301
Takelriss.
Rigging-plan.
1:100



H.2765
366

Plan approved only for
stage to mast & cannot put

11. 11. 04

GEN BOX NO

749

SCHICHAU

1301

"CHIEN SHE"

Ruggvay Ham

32



© 2021

Lloyd's Register
Foundation

9E00-9EE710-1EE710