





TO LLOYD'S REGISTER OF SHIPPING


RECORDS DEPT.  
LONDON

8


Patricia  
Const Profile & Deck  
(2)

Kobe Rpt. No. 1364

As fitted

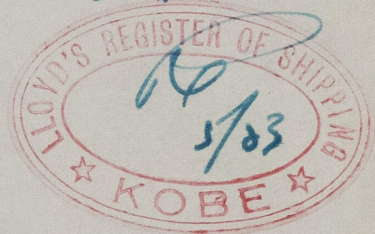

016784-014743-0231

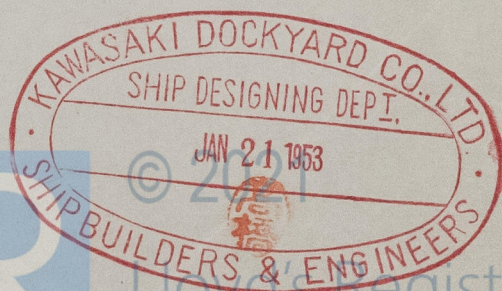

Lloyd's Register  
Foundation

JAN 28 1953  
JAN 21 1953