STEEL S.S. STEAM TUG "JAGOCHA"

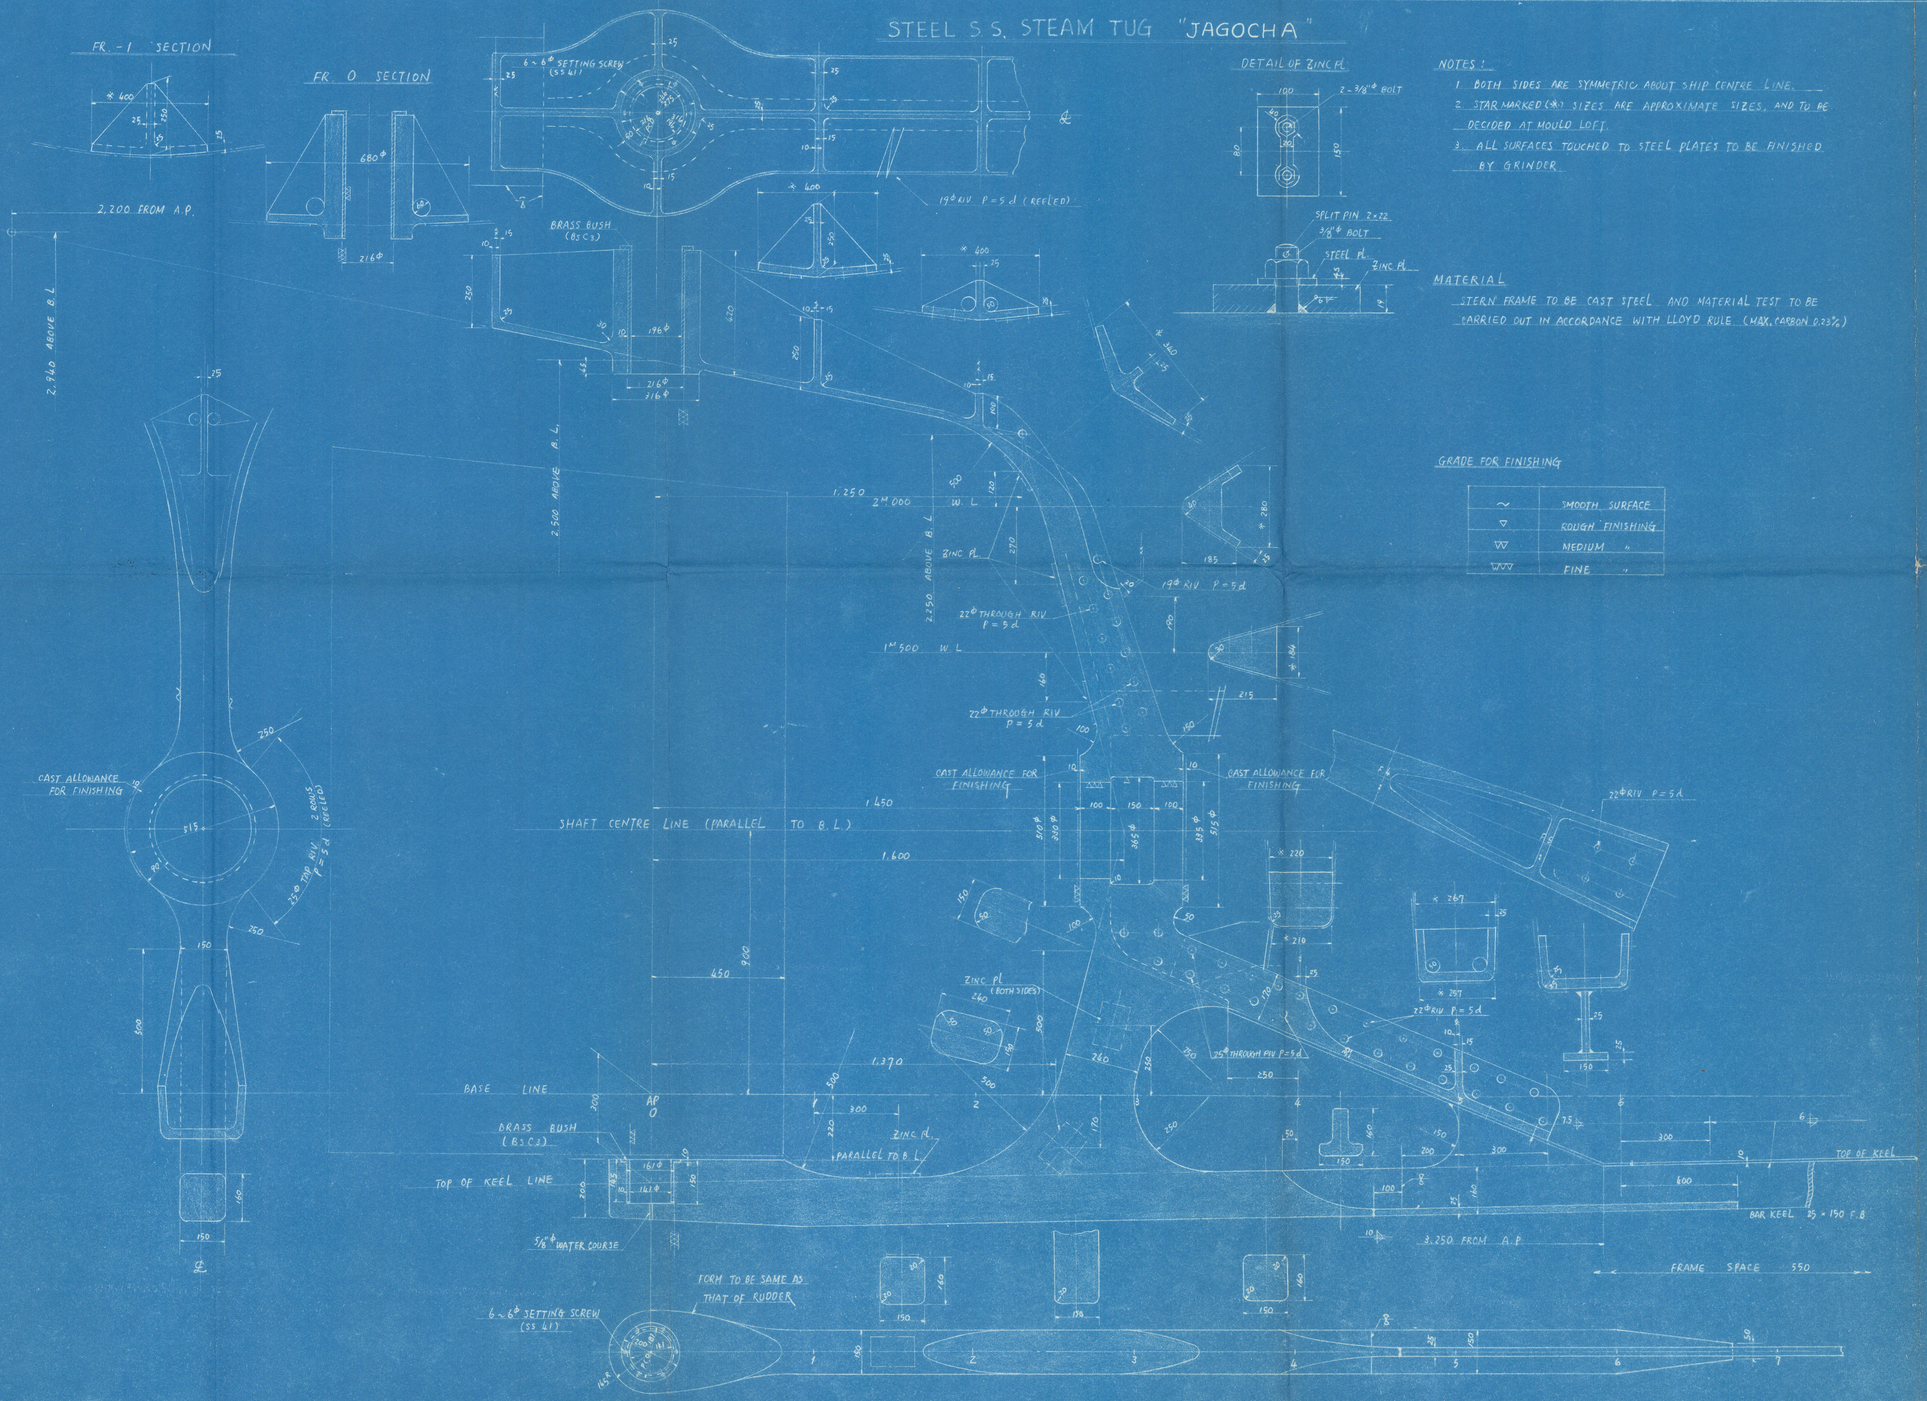

NOTES:

1. BOTH SIDES ARE SYMMETRIC ABOUT SHIP CENTRE LINE.
2. STAR MARKED (*) SIZES ARE APPROXIMATE SIZES, AND TO BE DECIDED AT MOULD LOFT.
3. ALL SURFACES TOUCHED TO STEEL PLATES TO BE FINISHED BY GRINDER.

MATERIAL

STERN FRAME TO BE CAST STEEL AND MATERIAL TEST TO BE CARRIED OUT IN ACCORDANCE WITH LLOYD RULE (MAX. CARBON 0.23%)

GRADE FOR FINISHING

~	SMOOTH SURFACE
▽	ROUGH FINISHING
▽▽	MEDIUM "
▽▽▽	FINE "

AS BUILT

LLOYD'S REGISTER OF SHIPPING KOBE 21/8/56

B/A No. OF MNFS	PART No.	NAME OF PART	MATERIAL	UNIT WEIGHT KG	REMARK

ЯГОЧА — B/O "СУДОИМПОРТ" СССР.

STERN FRAME

SCALE 1/10

HITACHI ... & ENGINEERING ... MUKAISHIMA SHIP ... SHIP DESIGNING SECTION

DATE MAR 22 '56 — DRAWING SECTION

MANUF No.

CODE No.

DRAWING No. 21278

© 2021 Lloyd's Register Foundation

014849-014858-0241