



CAST STEEL STERNFRAME

S.M.V. No 985-6.

SCALE 1" = ONE FOOT.
DETAILS - SCALE AS INDICATED.

MATERIAL:- BEST QUALITY STEEL CASTING.

DIMENSIONS:- 425.0" BP. (ON L.W.L.) x 57.5" H.P. x 25.1" ALD. TO 21" DECK - 30.2" H.P. TO UPPER DECK.
TO CLASS 100A11 WITH FREEBOARD AT LLOYD'S SPECIAL SURVEY, C.S. VESSEL WITH CRUISER STERN.
FIRST LONGITUDINAL NUMBER L.D. = 15760. RULE STERNFRAME 10 1/2 x 8.
CASTING NOT TO EXCEED GIVEN SCANTLING, EXCESS OVER ESTIMATED WEIGHT WILL NOT BE PAID.
STERNFRAME TO BE RIVET HOLE BORED, WITH HOLES SPACED AS SHOWN.
NO RIVET HOLES TO BE BORED IN PROPELLER BOSS.
RIVET HOLES TO BE BORED PLUMB THROUGH POST.
CENTRE LINE OF STERNFRAME TO BE MARKED BY SHIPBUILDERS DESIGNER BEFORE CASTING.
PATTERN OF STERNFRAME TO BE APPROVED BY SHIPBUILDERS DESIGNER BEFORE CASTING.
STERNFRAME DESIGNED TO FIT DOUBLE PLATE STREAMLINE RUBBER.
DIA. OF RUDDER STOCK 11 1/2" + 1" DIA. INCREASE ✓ 12 1/2" DIA. STOCK.

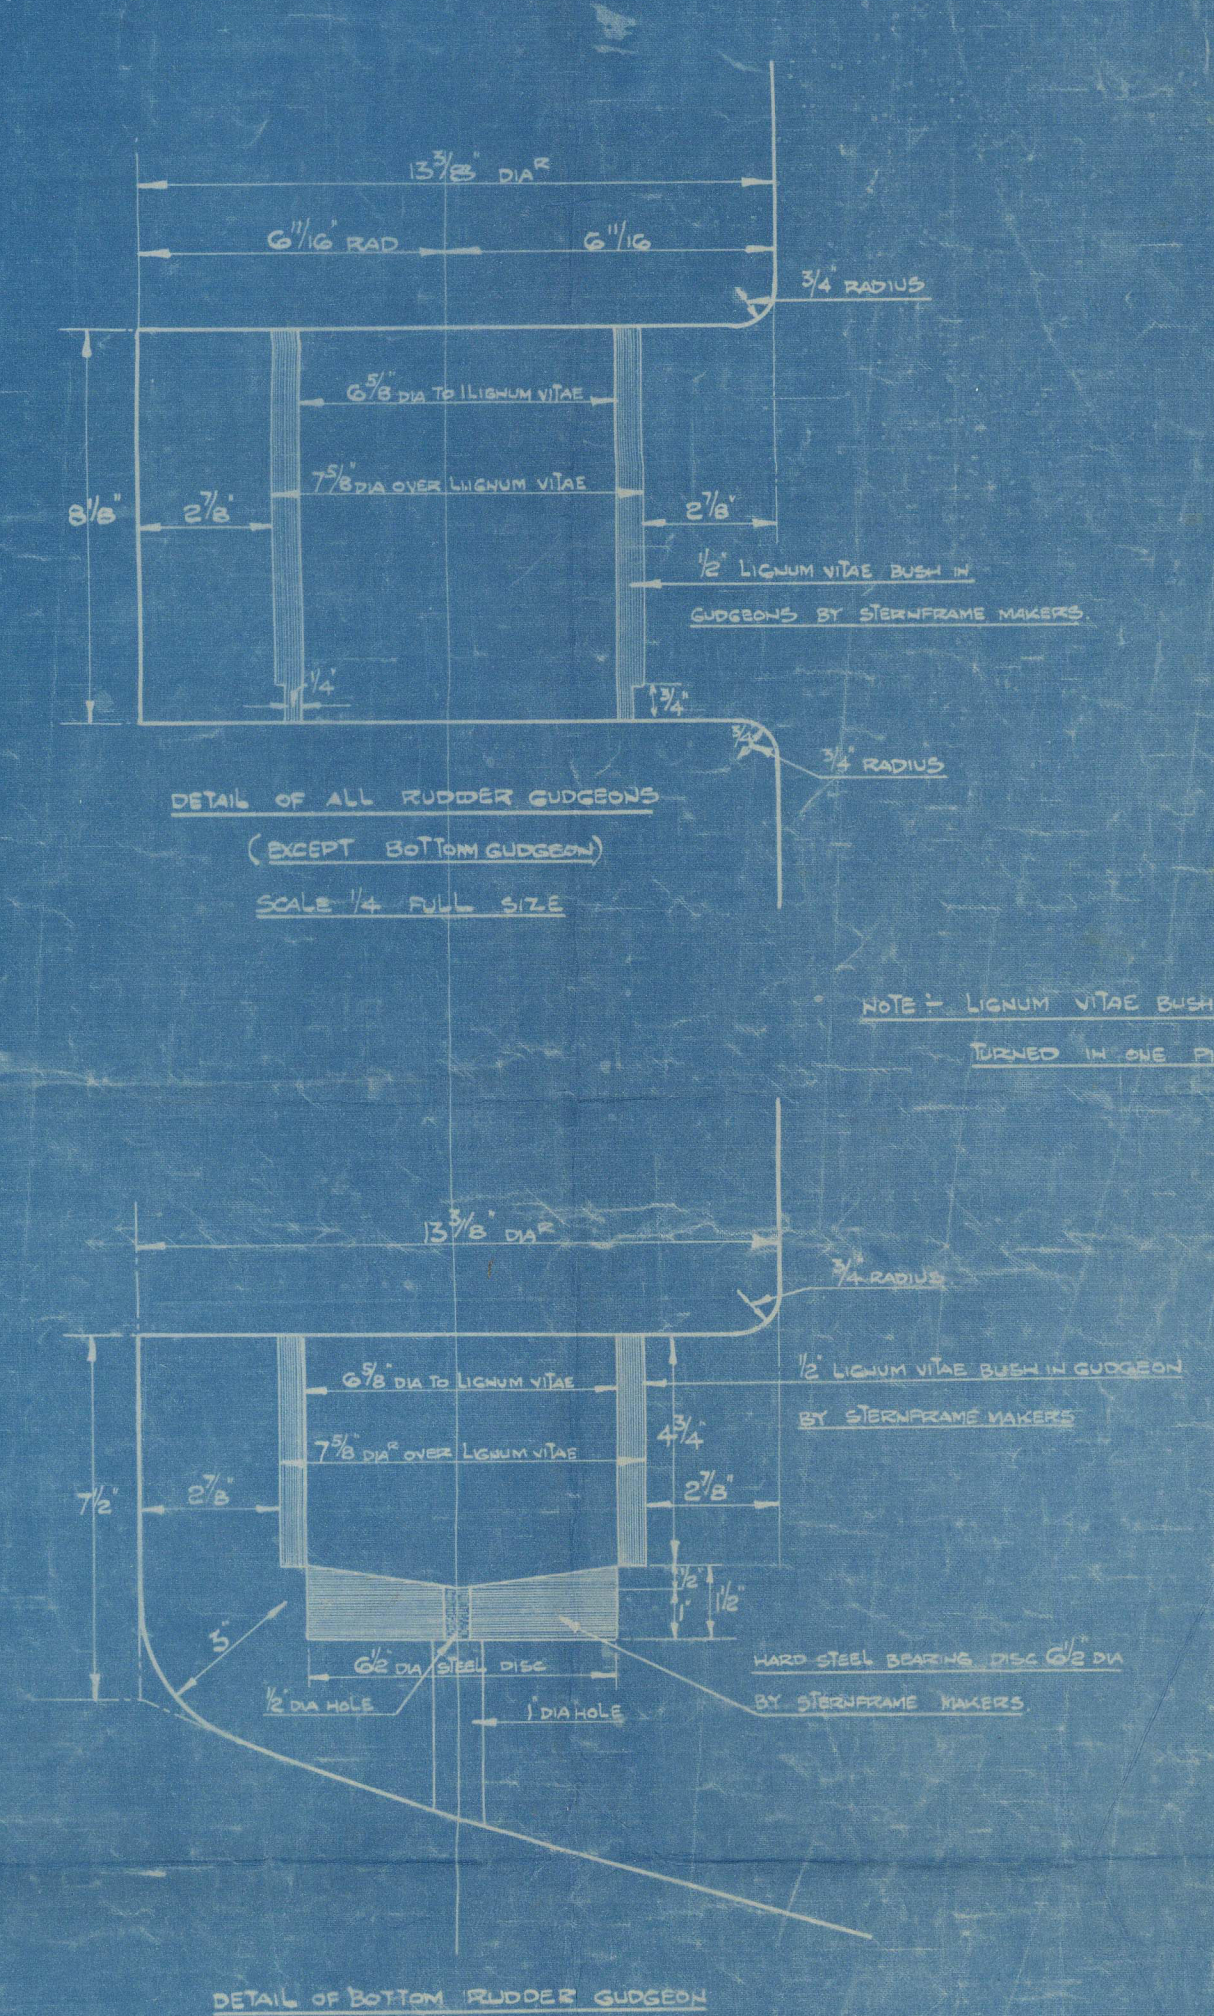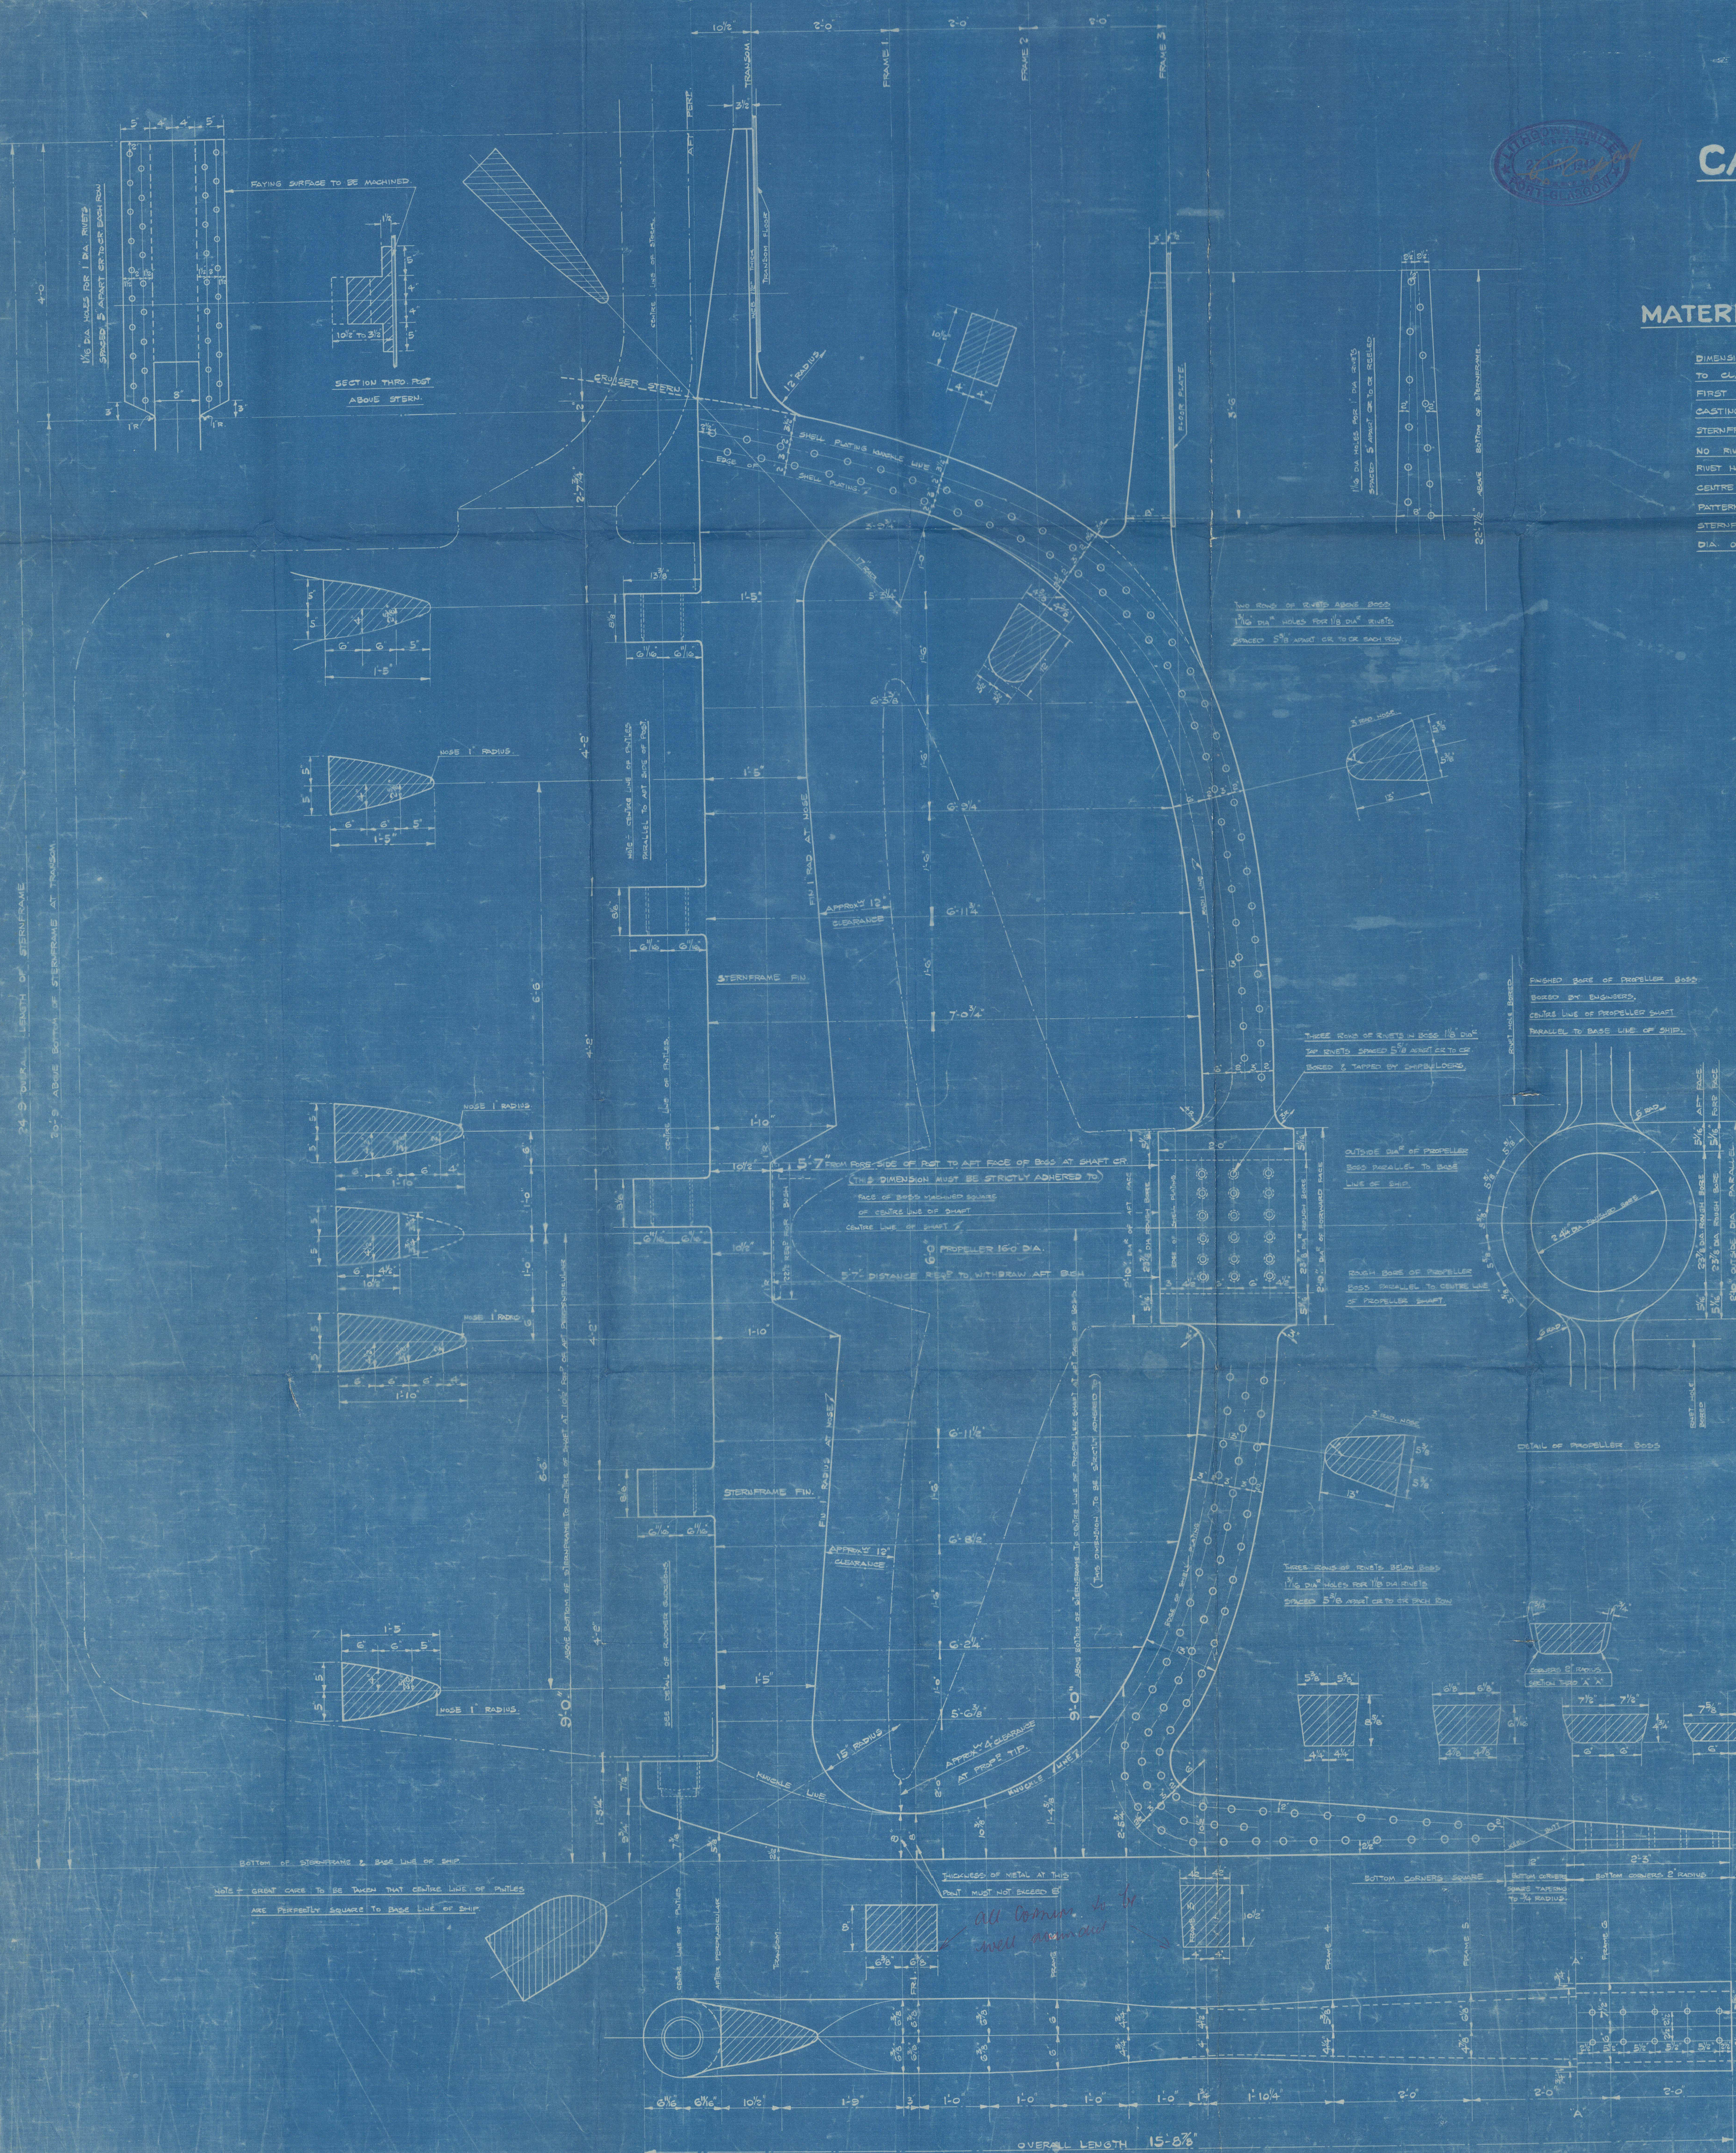

LLOYD'S REGISTER OF SHIPPING
James & Clark
2/16/12

LITHGOWS LTD
No 985-6

STERM
FRAME

"AVISBROOK"

985

EX
"TREVANION"

GRIC. FIRST ENTRY REPORT No. 22560

986

"TREVIDER" N/A BALKAN

GRIC. FIRST ENTRY REPORT No. 22688

014887 - 014898 - 0309

2 1/2
20 1/2
11 1/2
A 1/2
A 1/2

014887 - 014898 - 0309



© 2021

Lloyd's Register
Foundation