
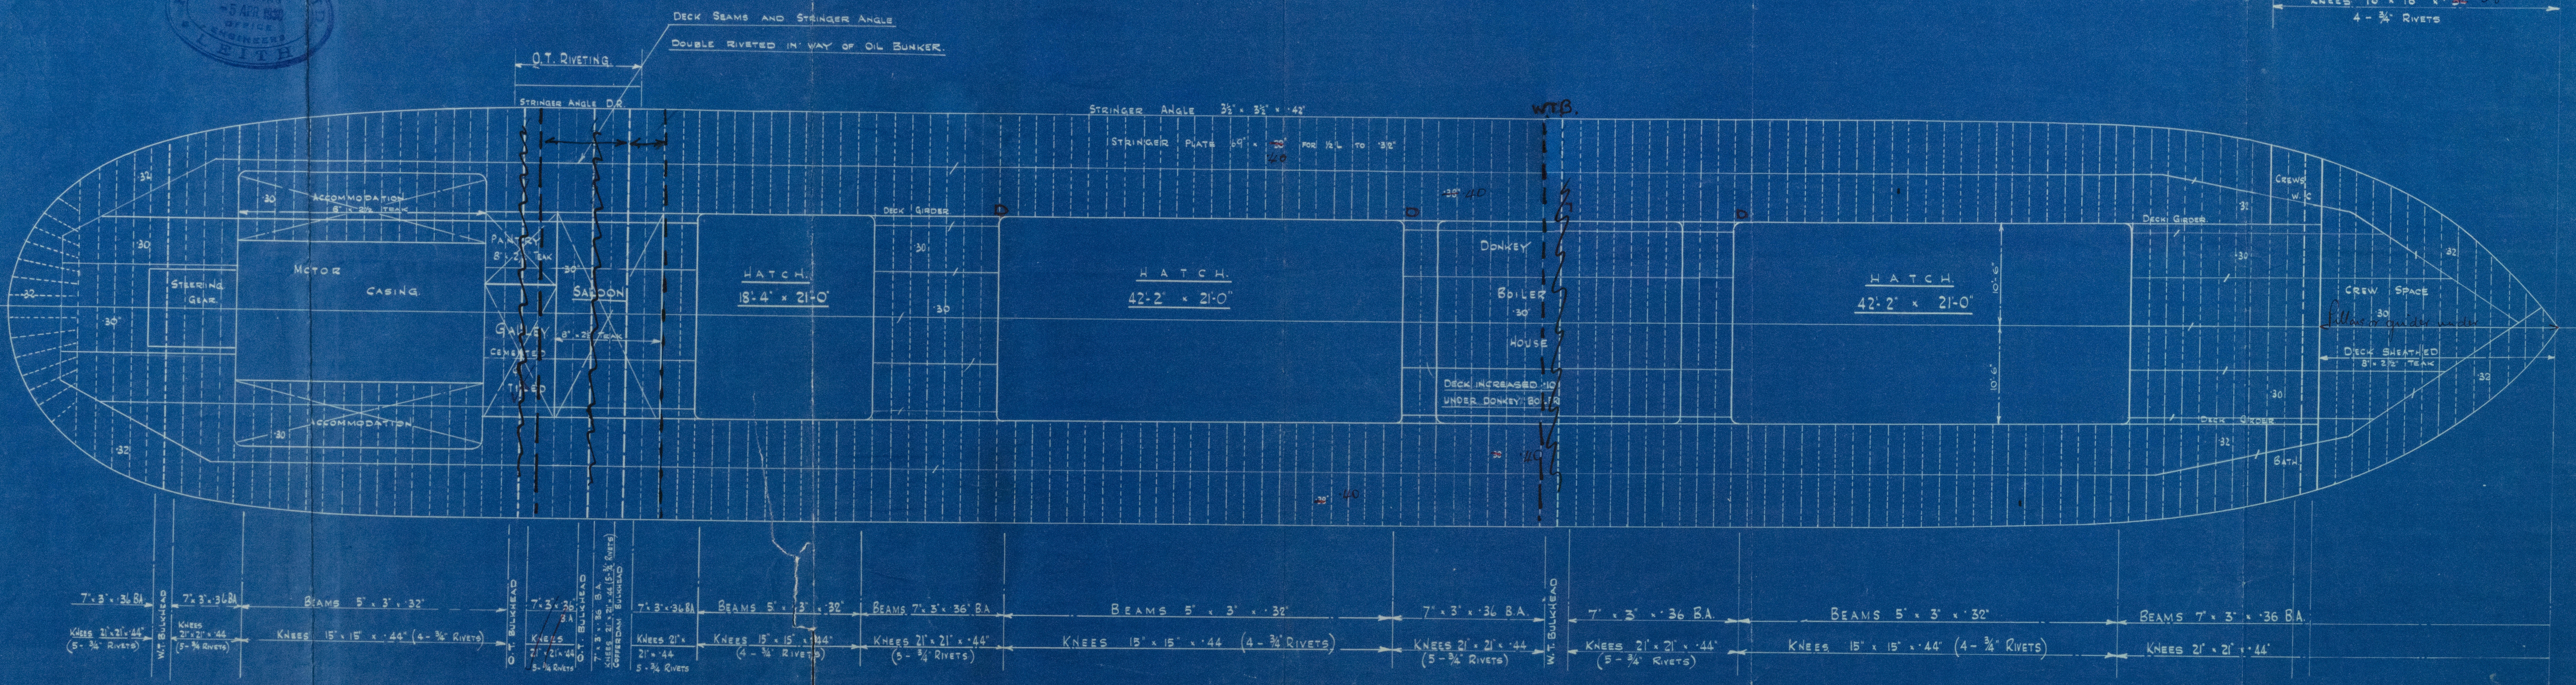


T. S. MOTOR VESSEL. N^o 181.
 PROFILE AND DECK PLAN
 DIM^s 260'-0" x 42'-0" x 13'-0" M^{LD}
 SCALE 1/8" = ONE FOOT.


CLASS: - A 1 - 5 - SEASIDE OR THE RIVER PLATE LIMITING PORTS TO
 SEAWARDS MONTE VIDEO, AND PIEDRAS

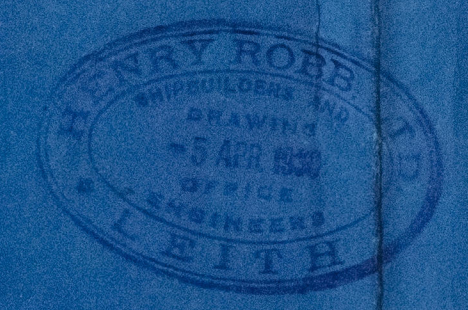

DRAWING N^o 2/181.

18. 11. 30

014349-014341-0062

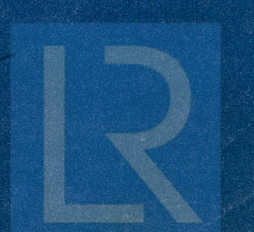

H Robt Lea

Nº 181

PROFILE & DECK

M. V. "Aguila"

Lth. Ryt. 17948.

014399-014911-0062



© 2021

Lloyd's Register
Foundation

0062

100	3
250	4



© 2021

Lloyd's Register
Foundation