


DON

5.9.35.

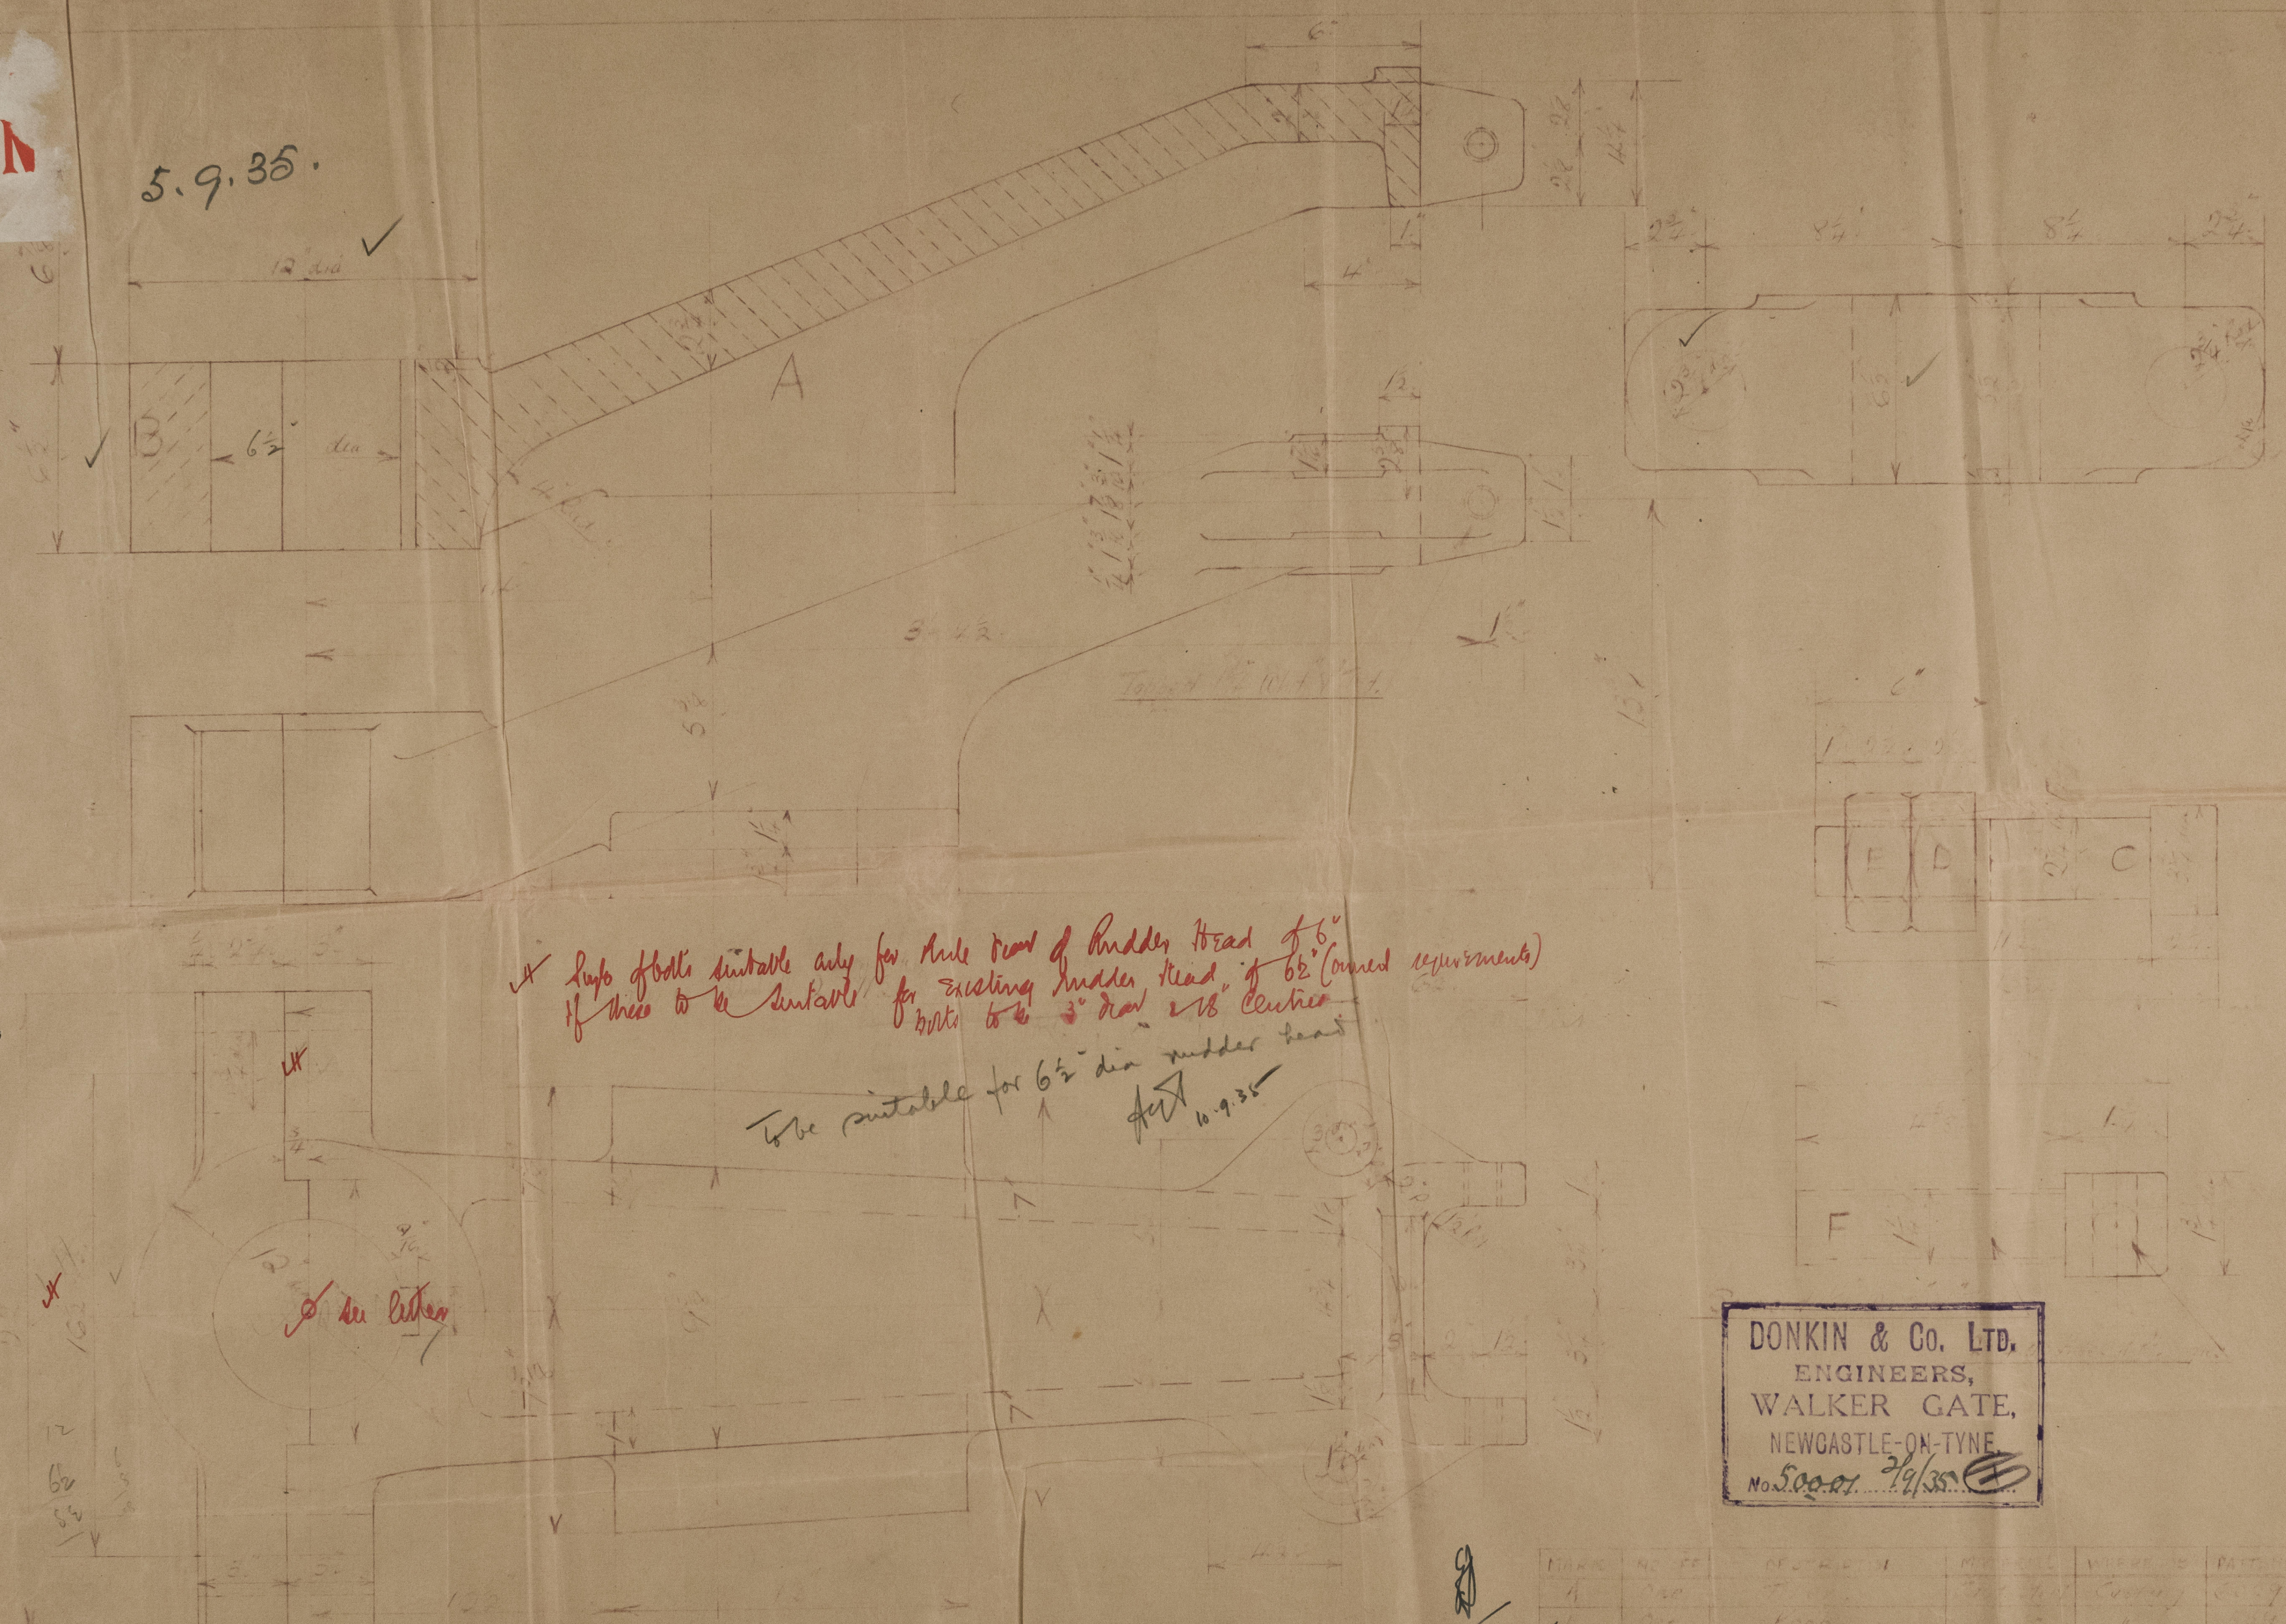

014899-014911-0131

Aguilla II

B as 14523.

Milen



© 2021

Lloyd's Register
Foundation