



T. S. S. CARDENA.  
PROFILE, DECKS, ETC.  
SCALE 1/8" = 1 FOOT.

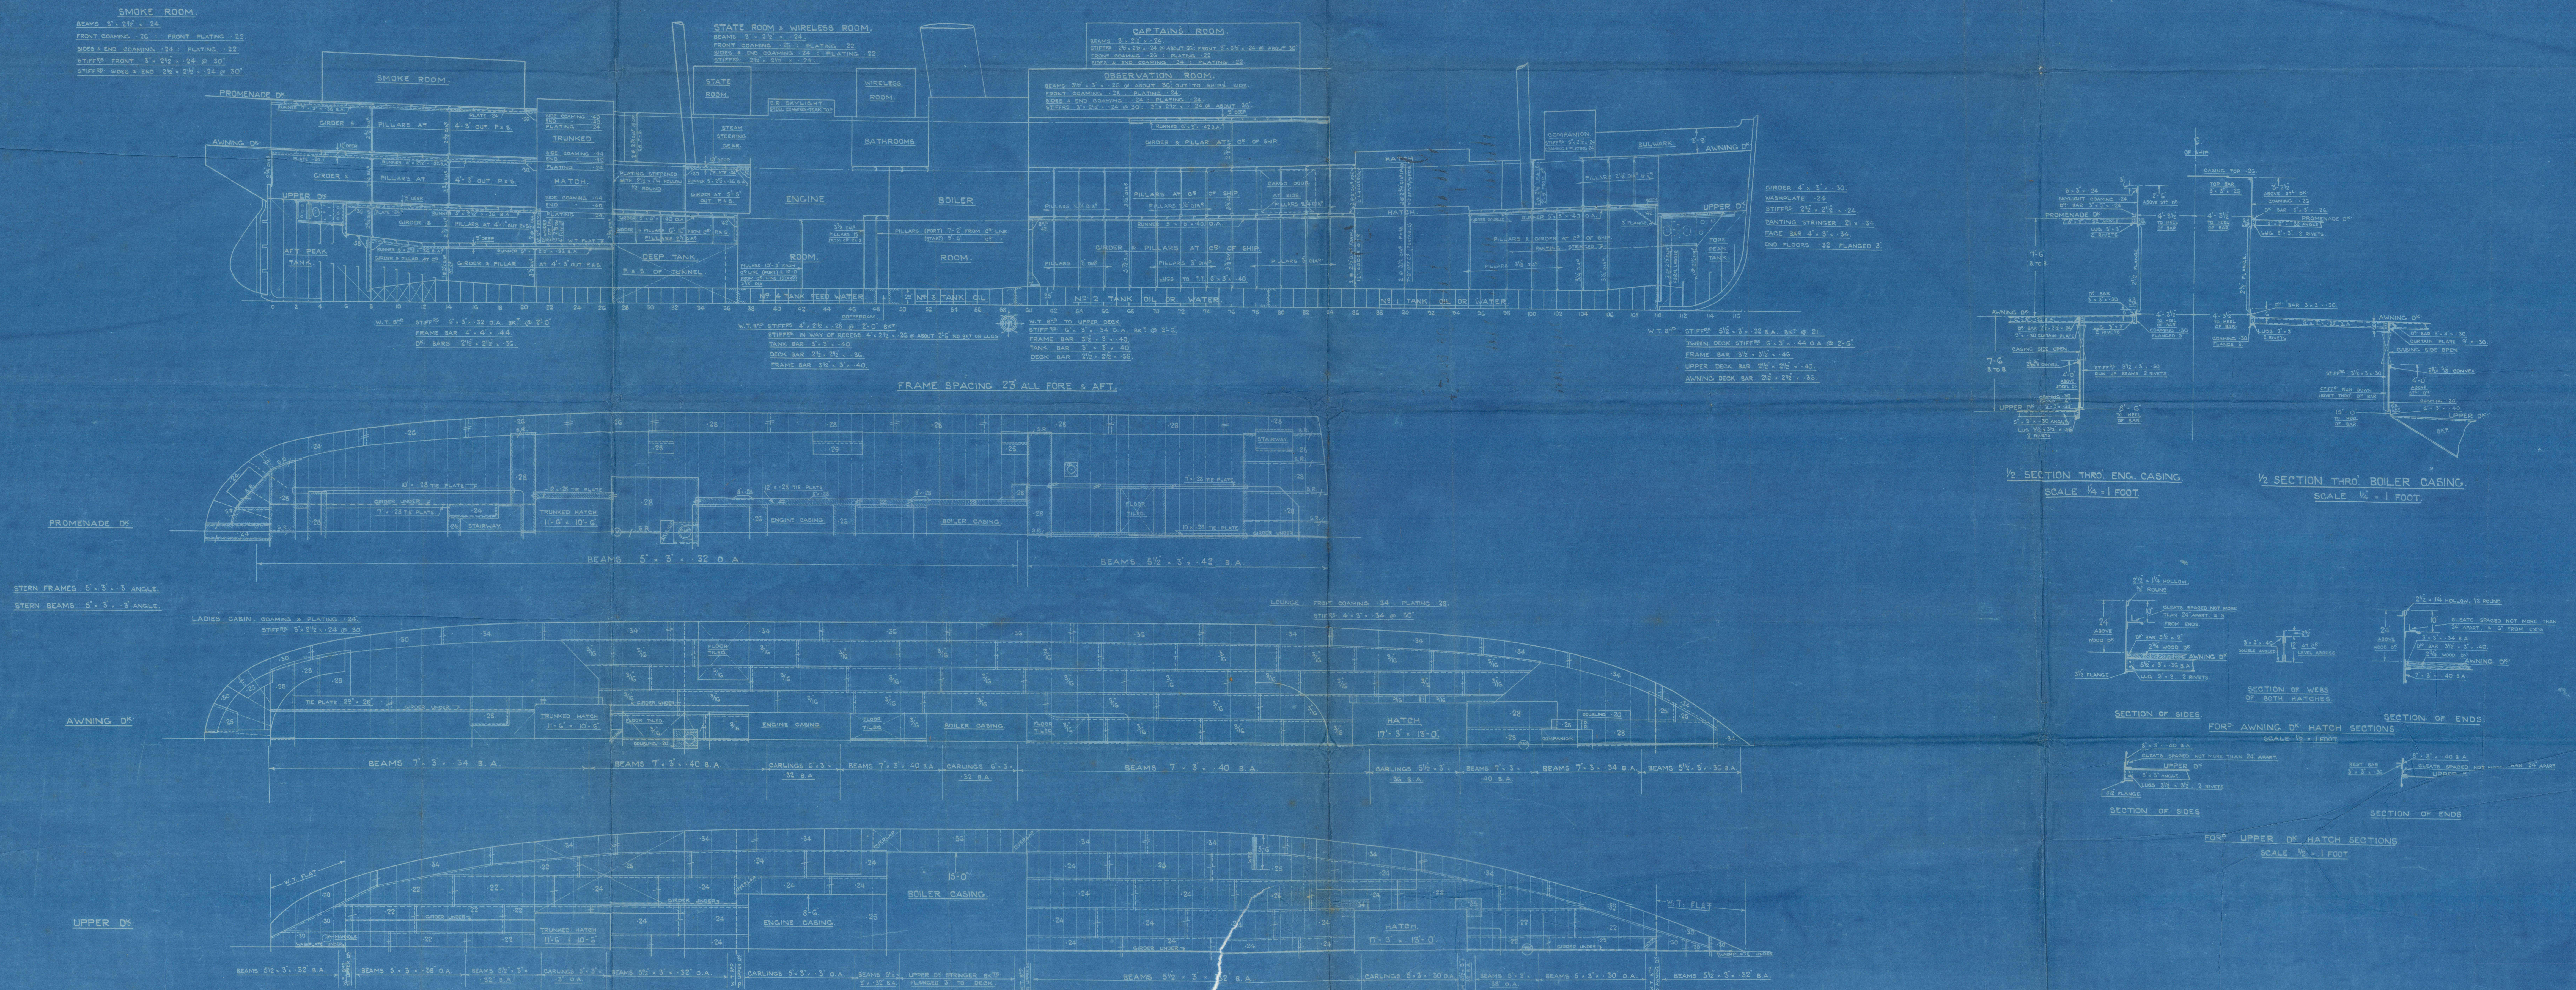

1/2 SECTION THRO' ENG. CASING.  
SCALE 1/4" = 1 FOOT.

1/2 SECTION THRO' BOILER CASING.  
SCALE 1/4" = 1 FOOT.

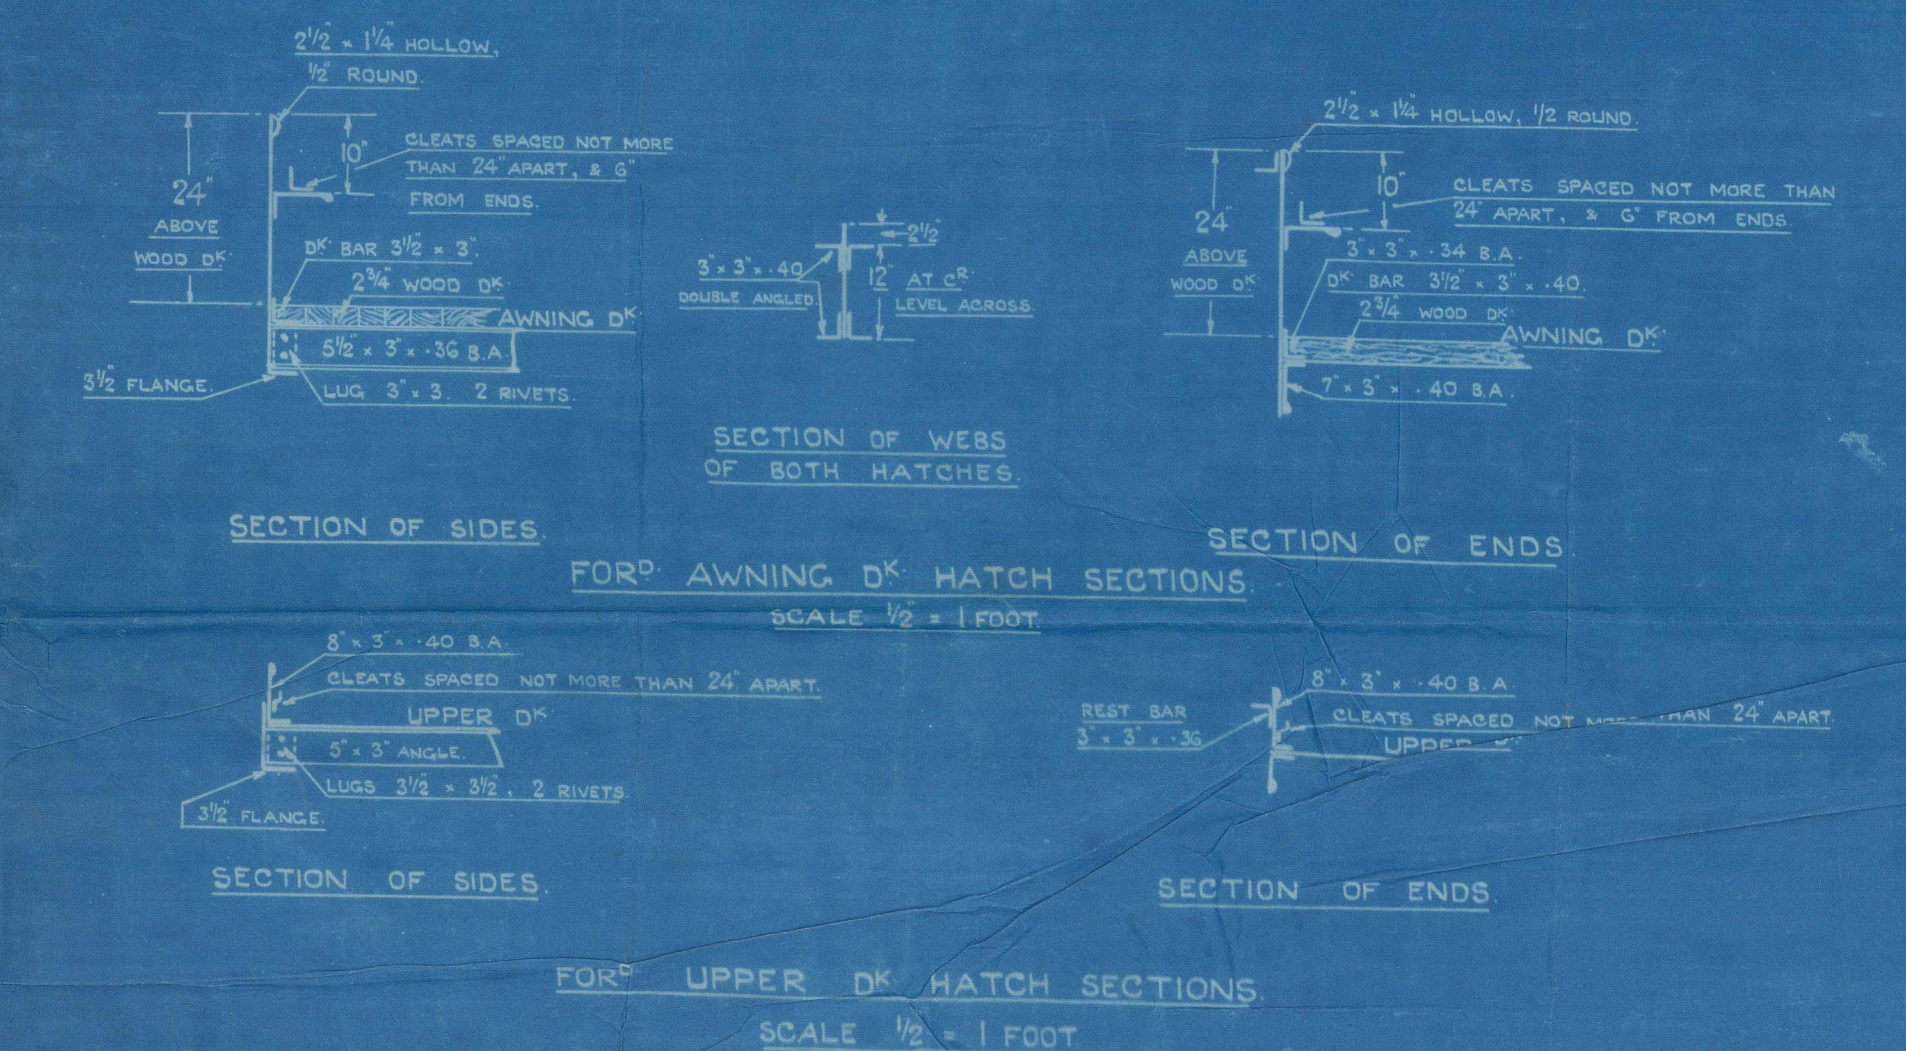



29

copy of plan No. 24.

Profile & Deck. [AS BUILT.]

Napier & Miller Ltd.

No. 227.

Reference.

T. 3/2 "CARDENA"



© 2021

Lloyd's Register  
Foundation

014912-014924-0051

29



Cardena

Profile dks.

Cardena

Profile dks.

27



© 2021

Lloyd's Register  
Foundation