


Carol I^{er}

9-2-03


~ No 500 ~

SKETCH SHEWING CONNECTION OF
SIDE STRINGERS TO REVERSE FRAMES


~ SCALE $\frac{1}{2}$ " = 1 FOOT ~

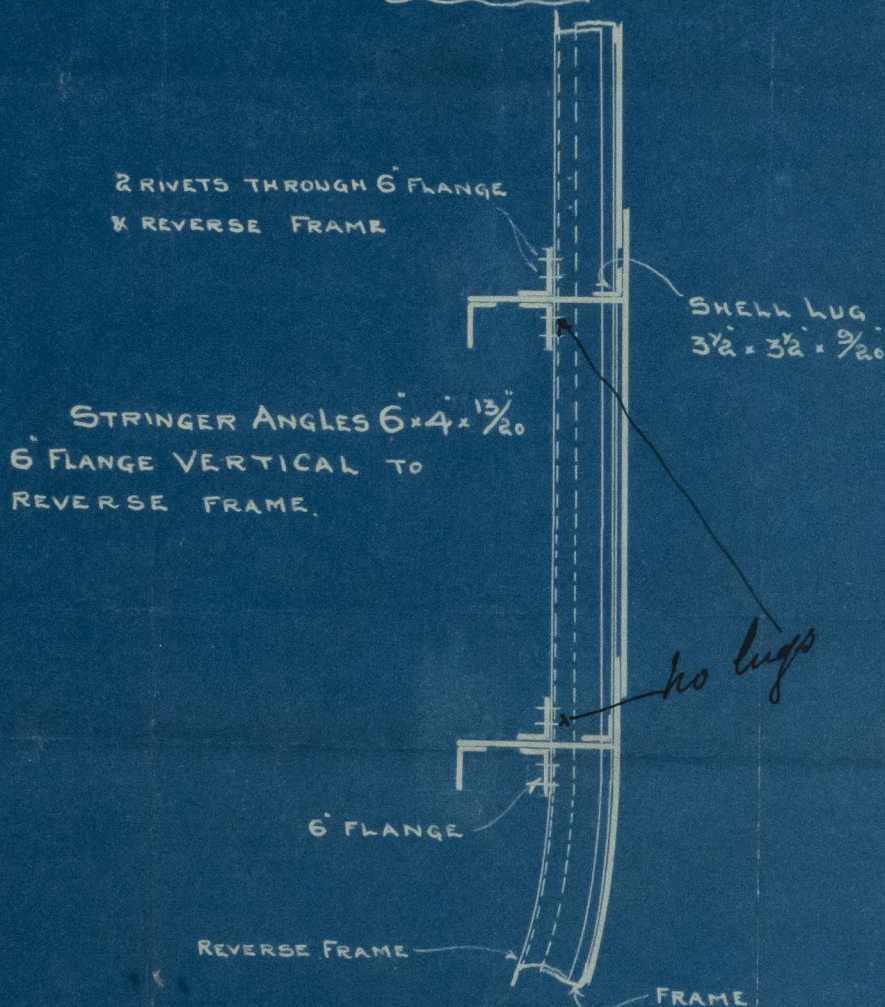

C.B.
9-2-03.

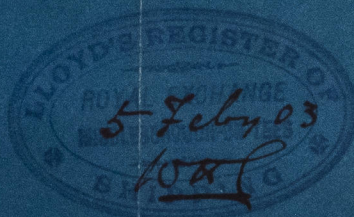

No 500

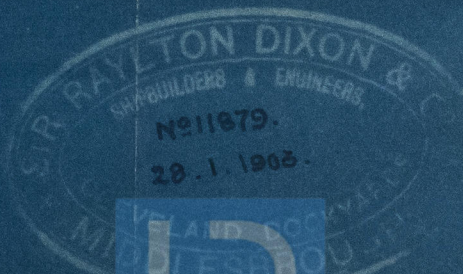


Lloyd's Register
Foundation

014935-014945-0213.1

Sir R. Dixon & Co
No 500

Amended
Connection of side
Shingles to reverses

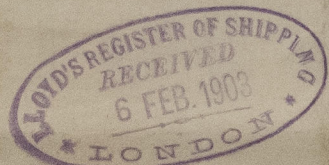

"Barol Ter"
Mdb Report No



© 2021

Lloyd's Register
Foundation

014935 014945 02131