




—RUDDER—

SCALE $\frac{1}{2}$ " = 1 FOOT

POST + ARMS TO BE OF FORGED IRON.
ARMS SHRUNK + KEYED TO POST

PLAN OF COUPLING

SCALE $\frac{3}{4}$ " = 1 FOOT

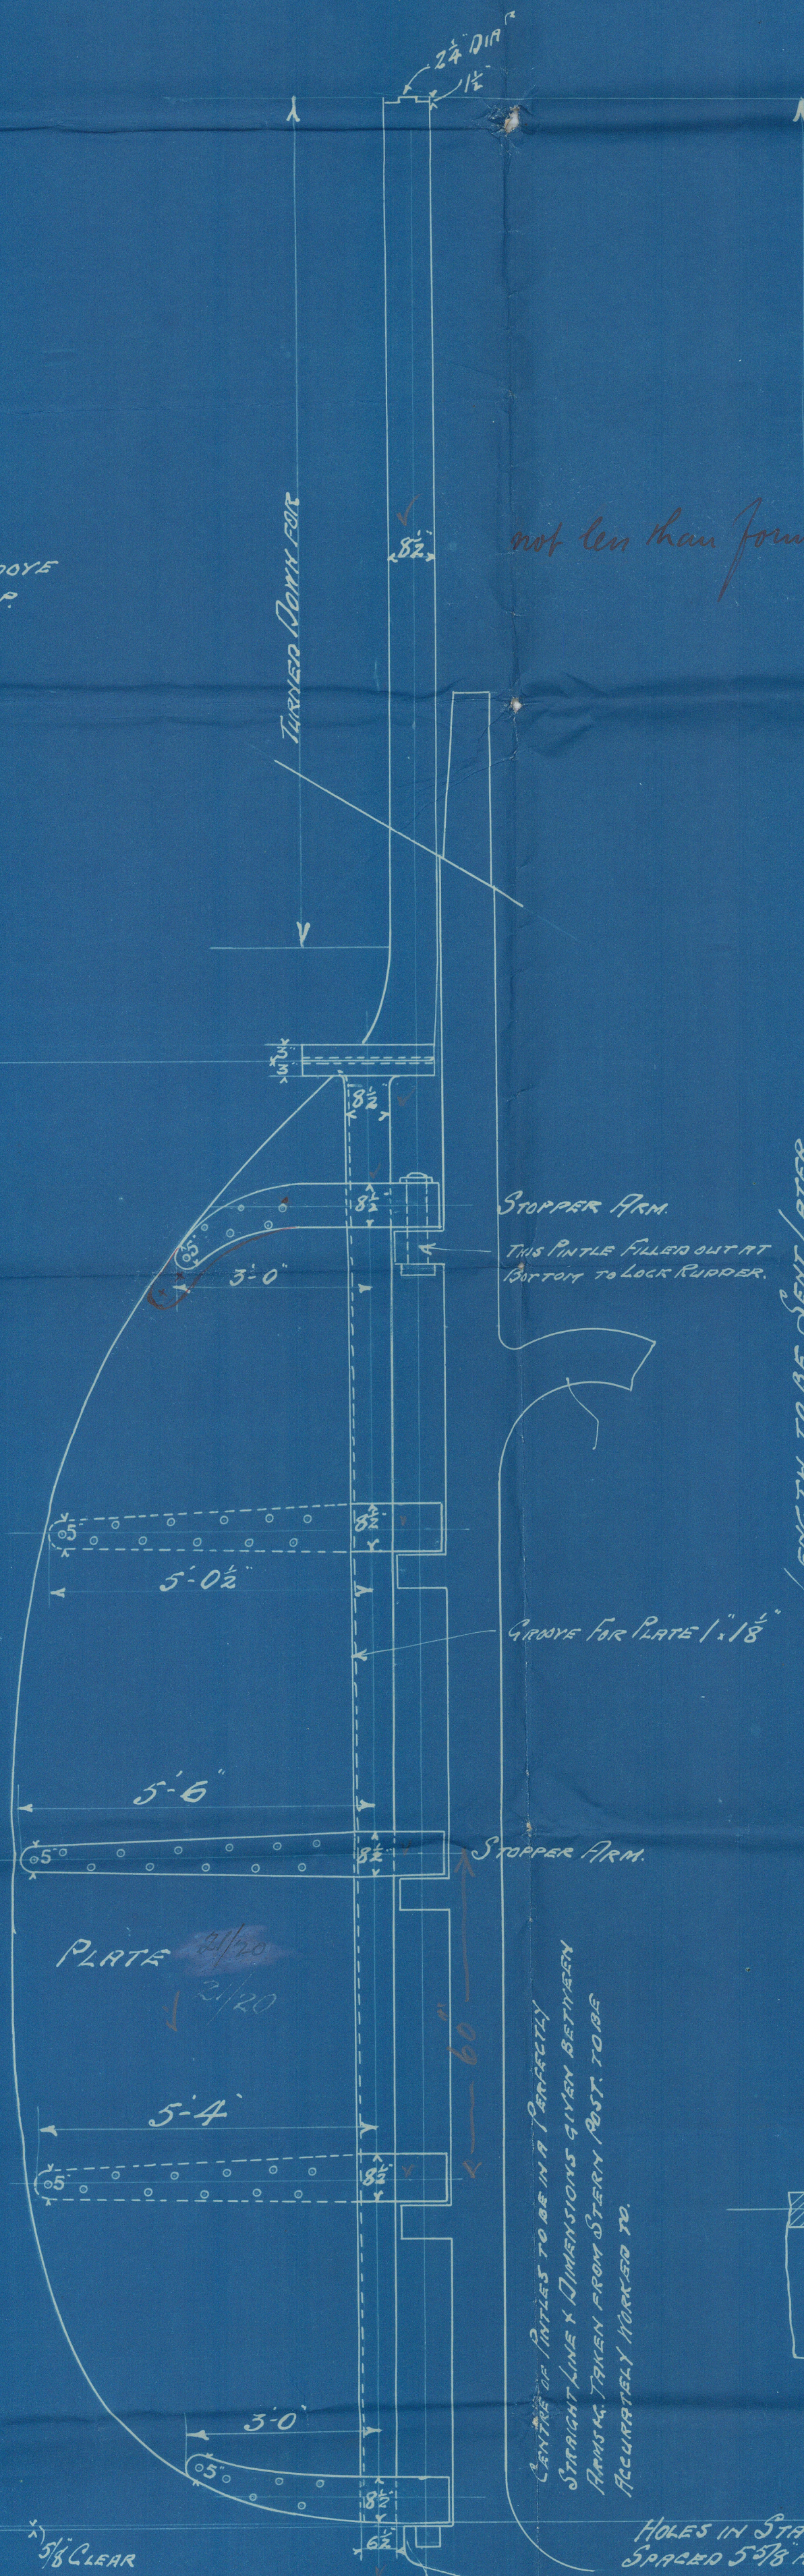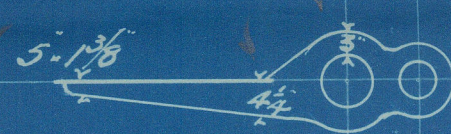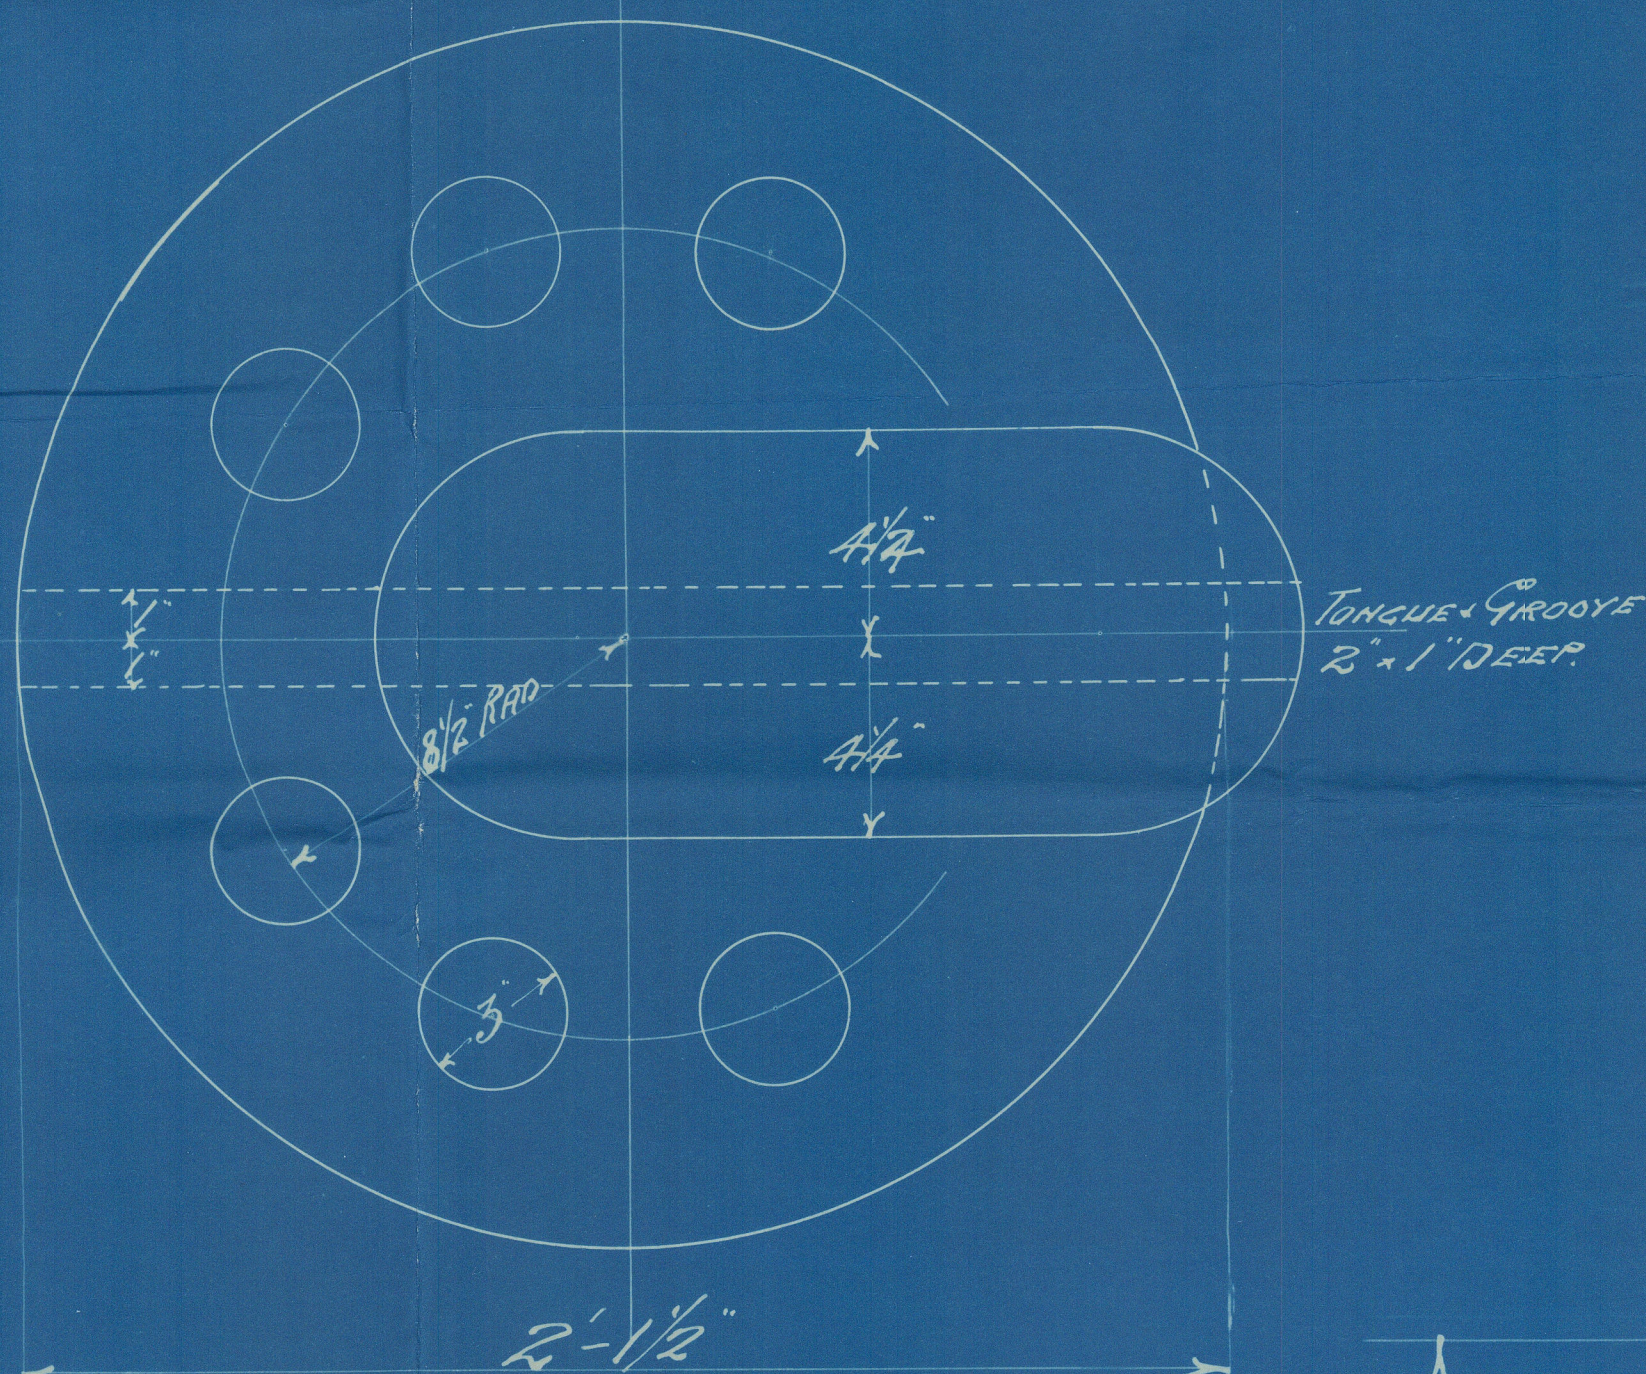


—FORGING—

TO PASS LLOYD'S.


PLAN OF NUT VC.

3" SCALE

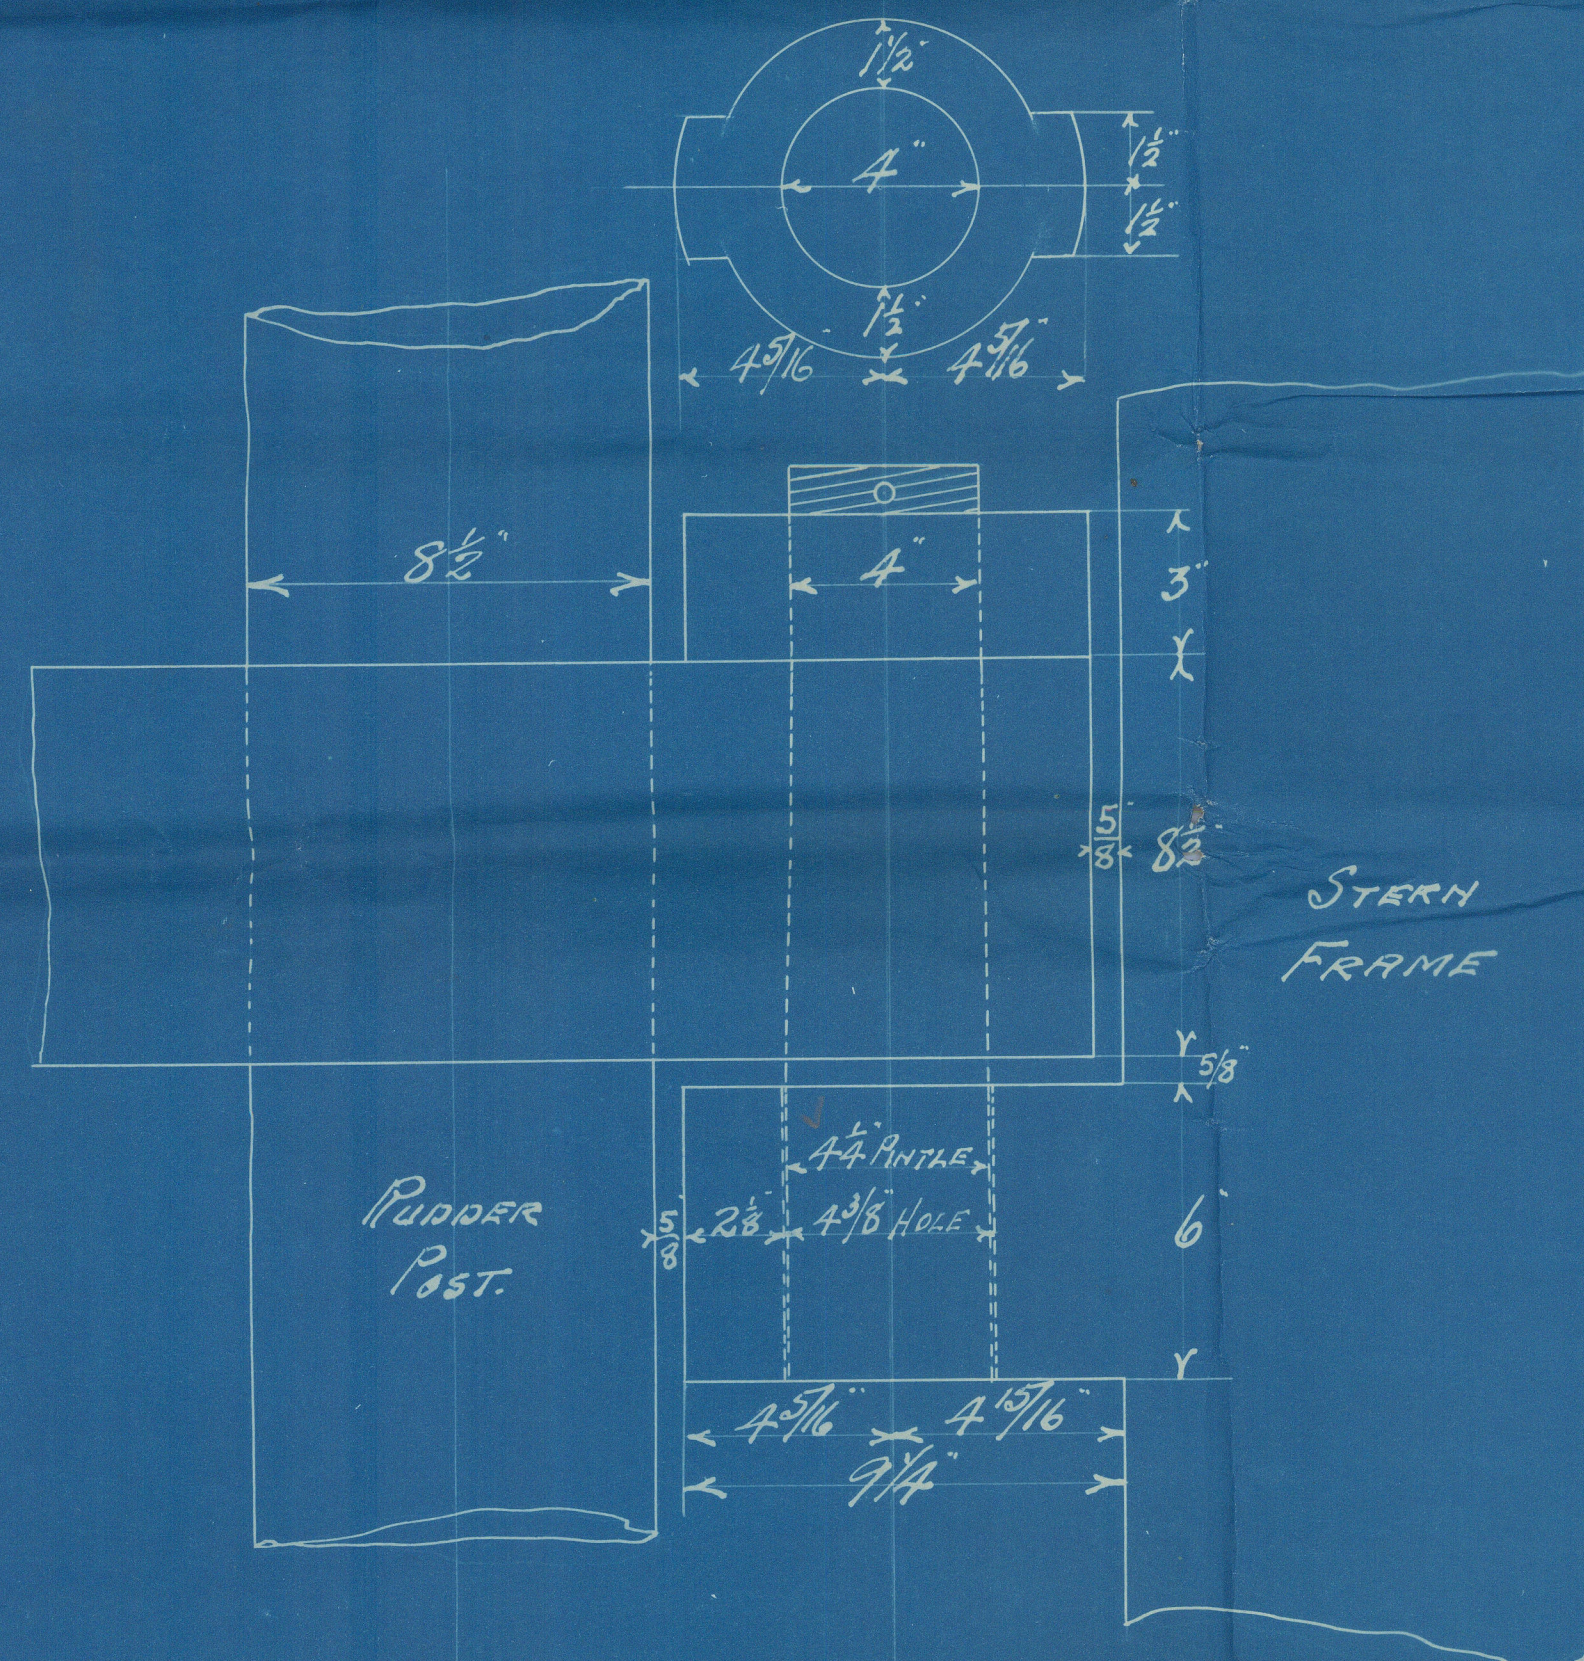

PLAN OF STOPPERS.


3" SCALE

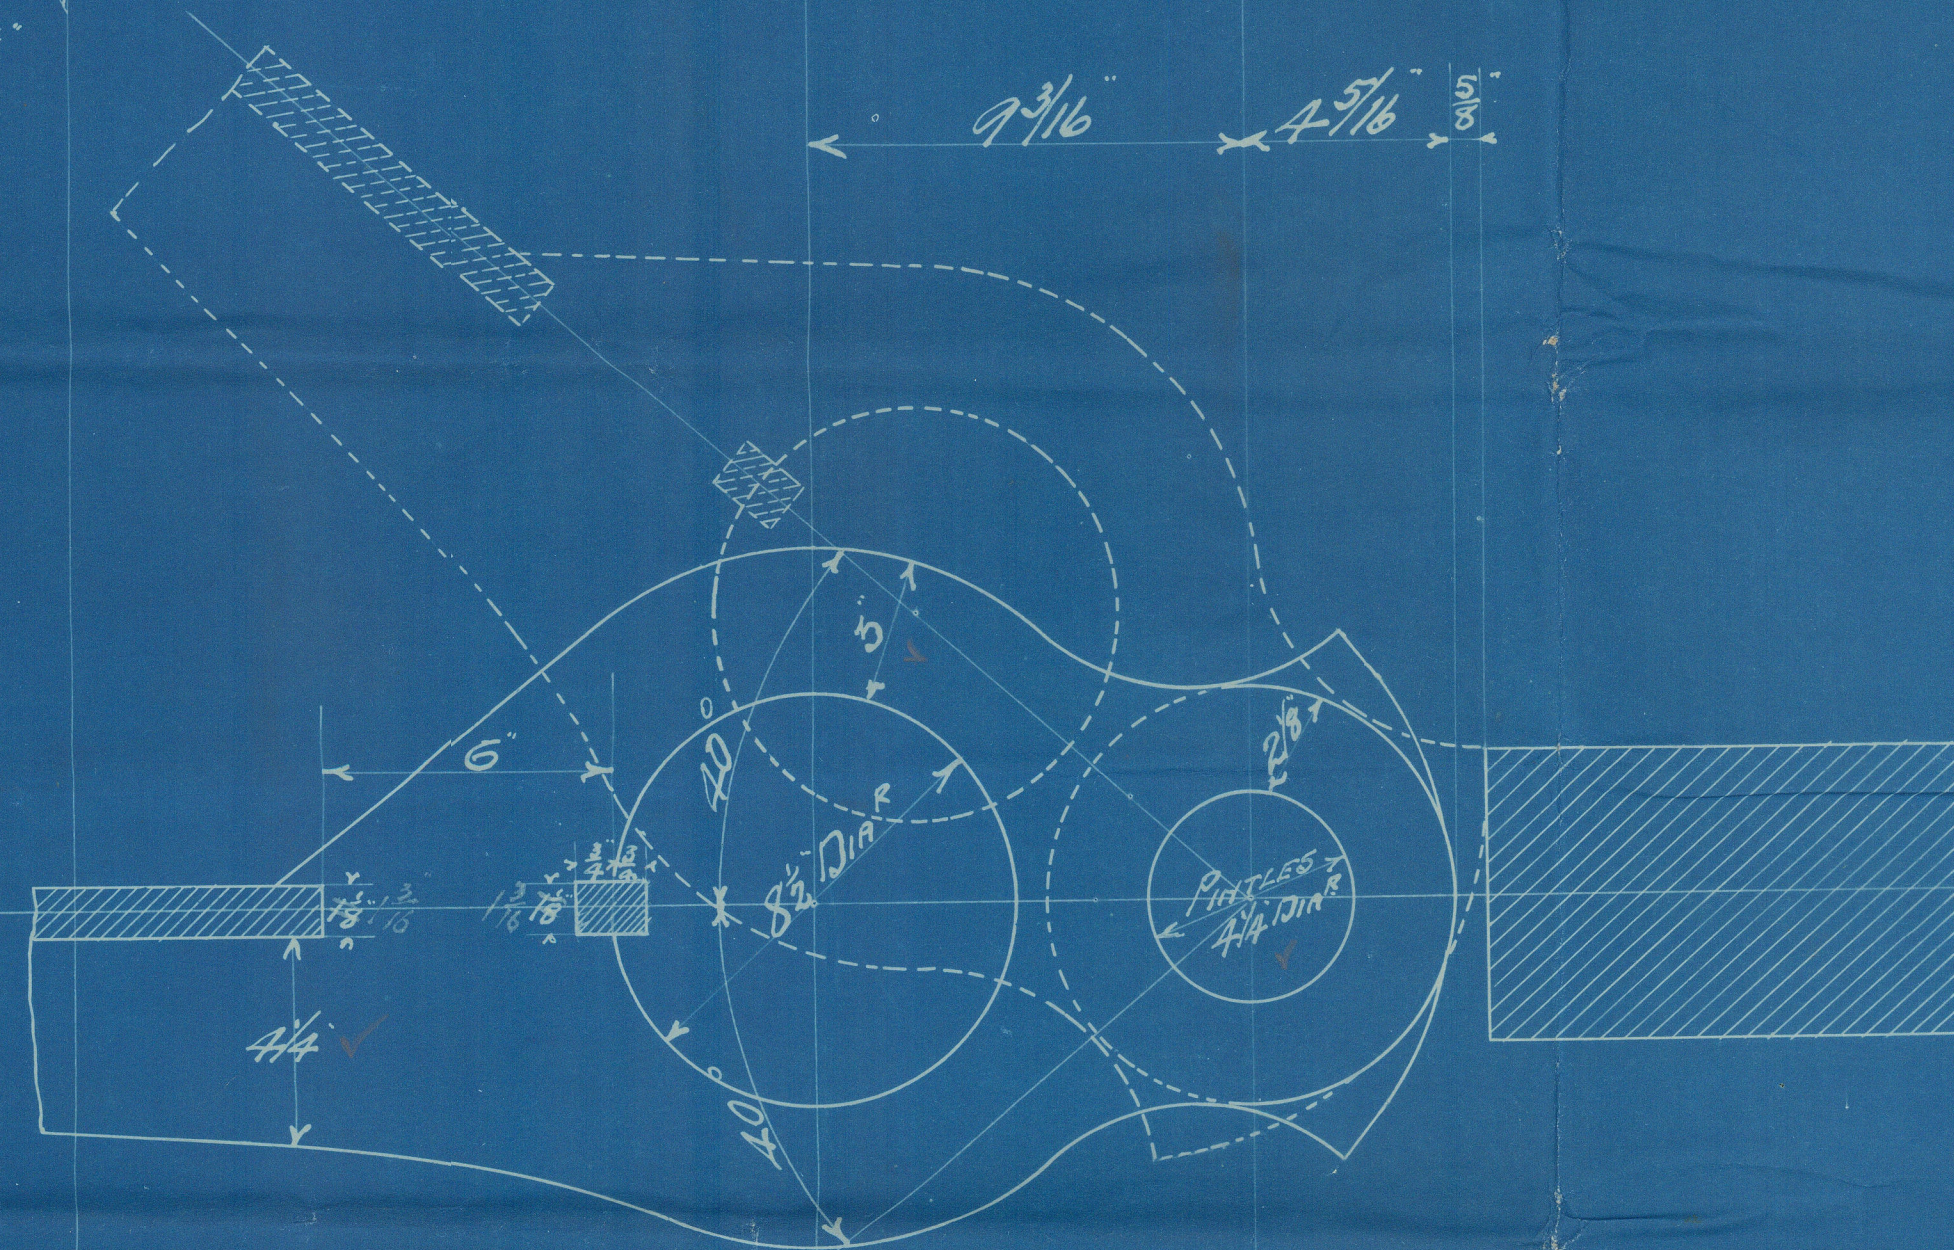

—N^o 500—

Plating 110 (30th Rule)
29263

17.1.03.

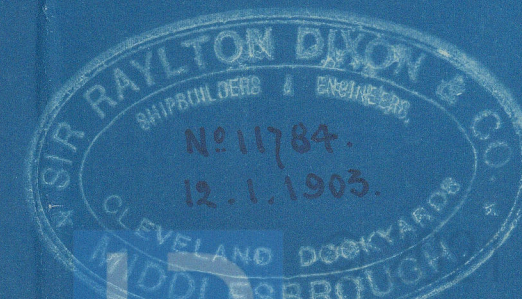

Lloyd's Register
011435-014943-0214

Sir R. Dixon & Co

No 500

Coupled single plate
rudder —



"Carol Ier"

Mdb. 3653



© 2021

Lloyd's Register
Foundation

014935-014945-0214