


$$\frac{L}{D} = 9.93$$

SCALE  $\frac{1}{2}$ " = 1 FOOT.

DIMENSIONS:- 13'-0" BP x 23'-0" EX x 13'-1" MD DEPTH x 12'-3" HOLD ✓

60 " 5' WARP ✓

STEAM TRAWLER

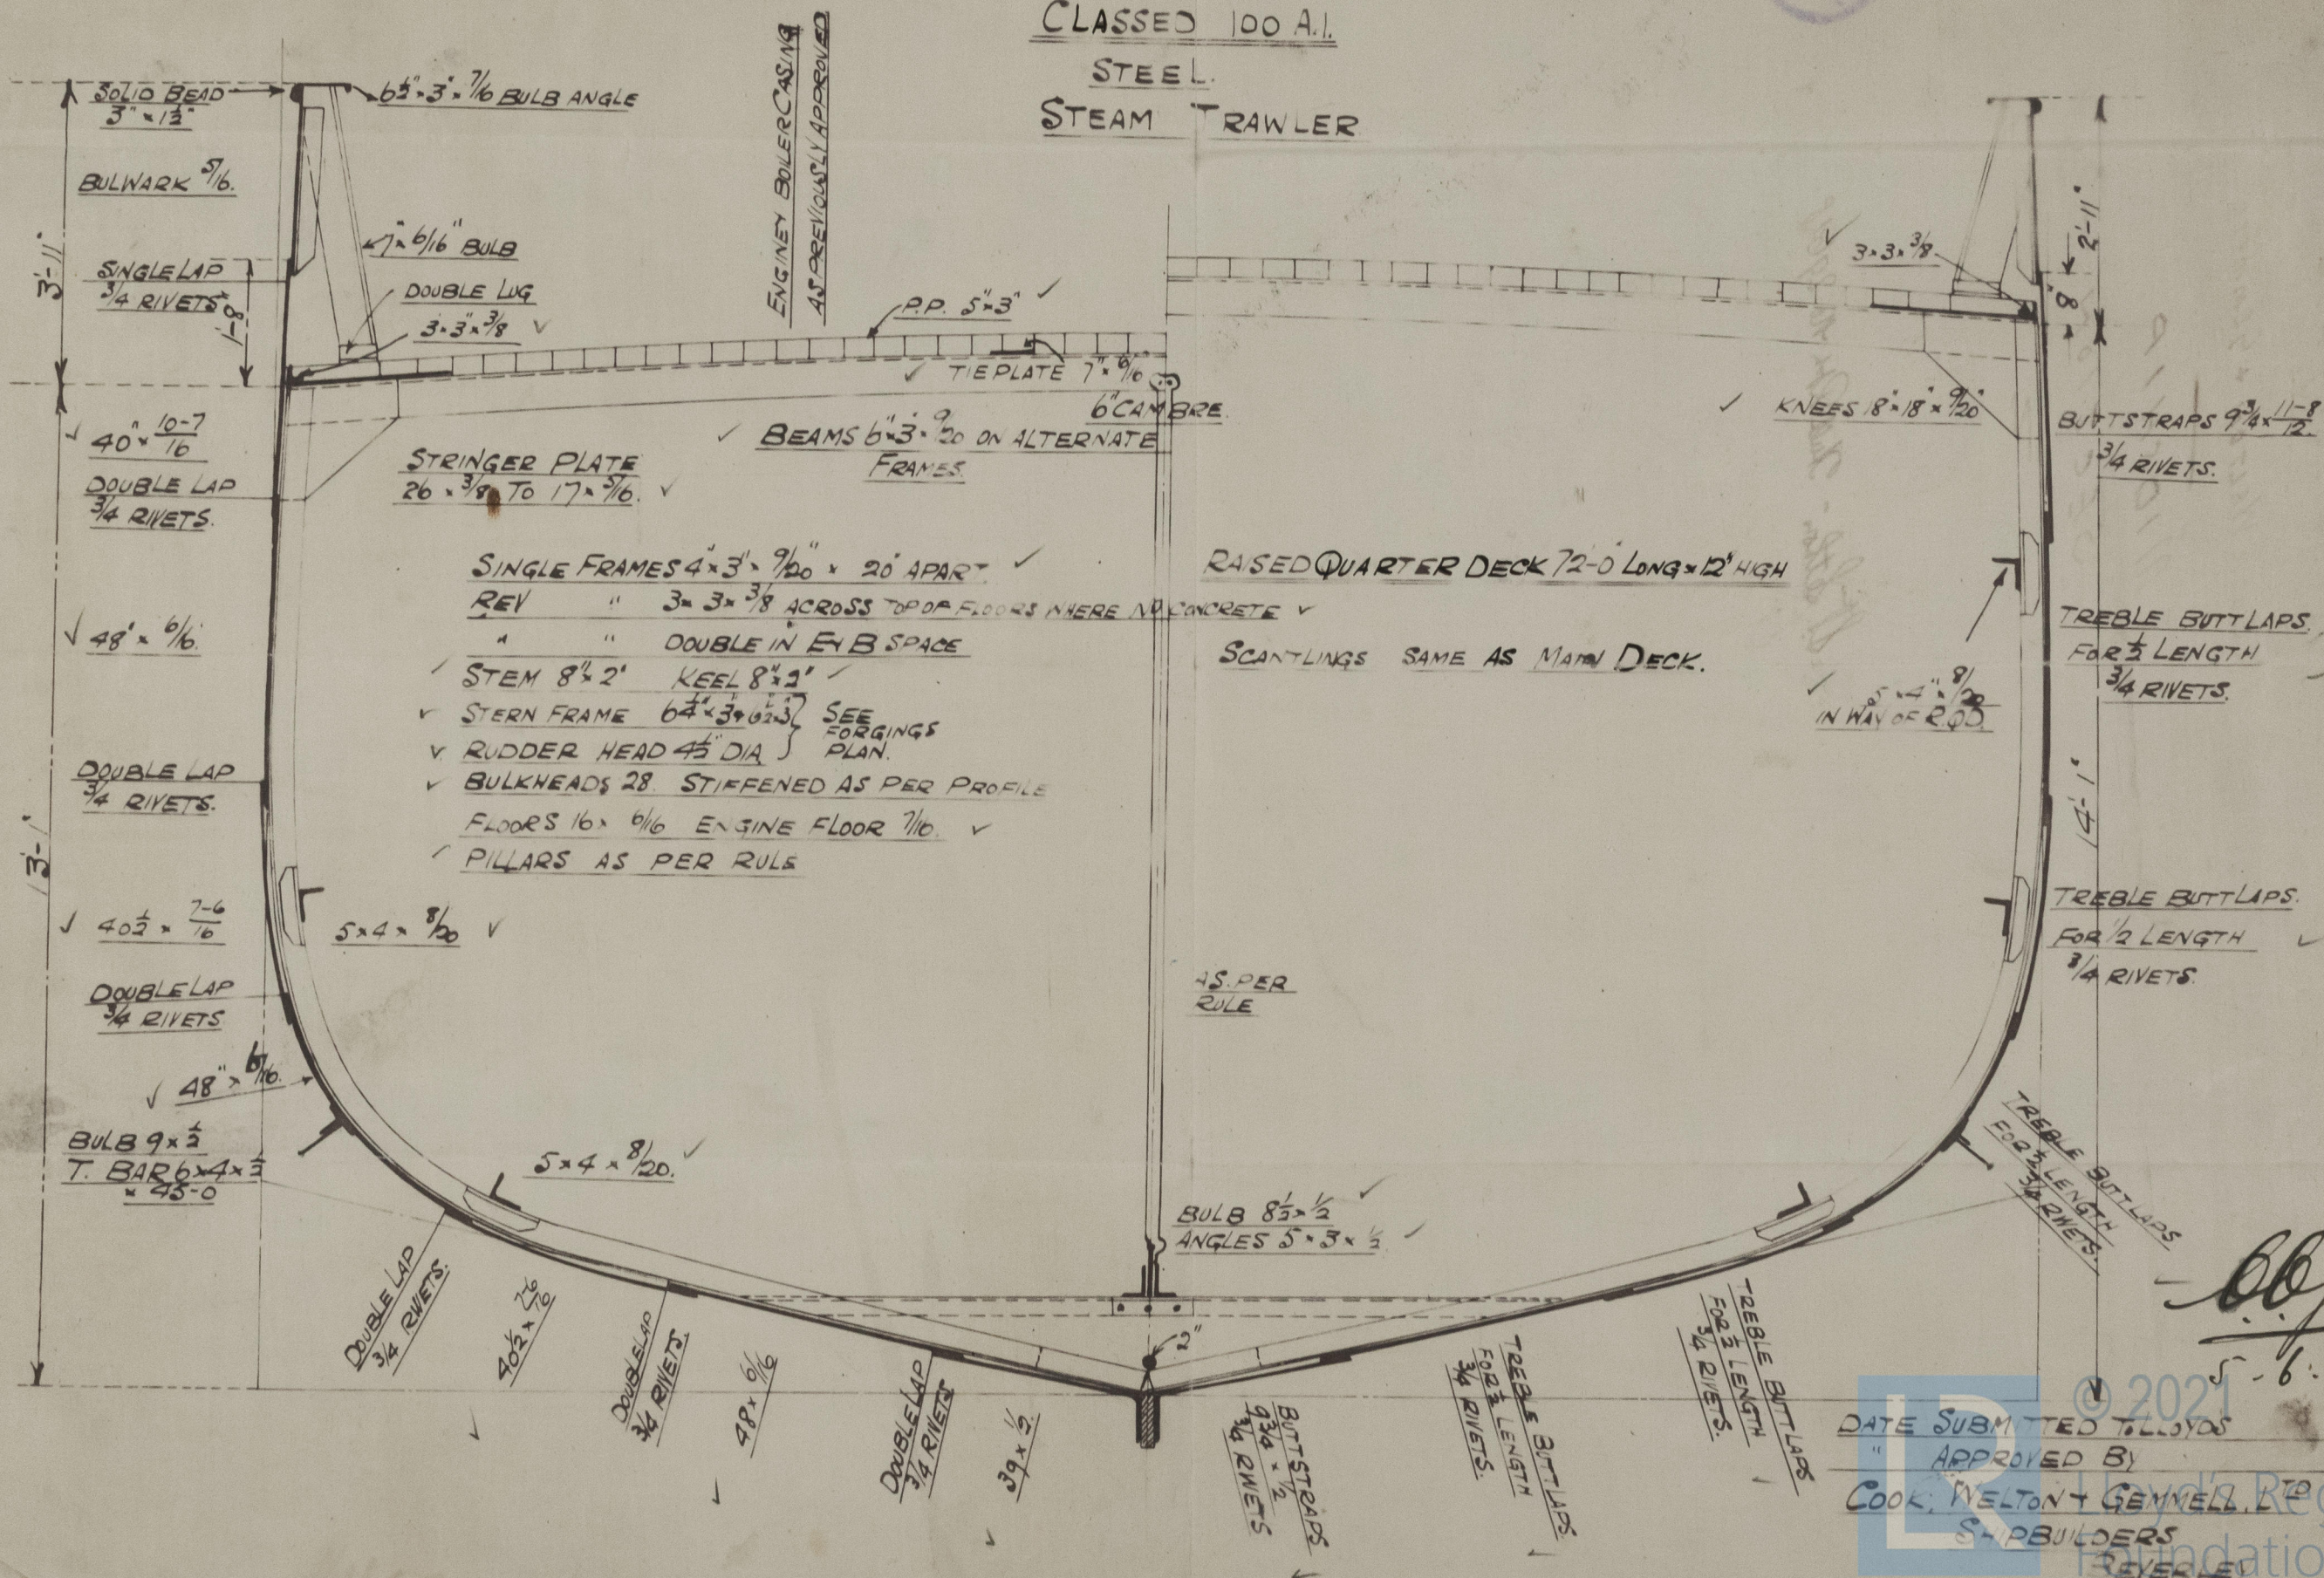

## SHIPBUILDERS

014935-014945-0284



45 P. R.  
P. R.



N<sup>o</sup> 345-6-9+50

COOK WELTON + GEMMELL


MIDSHIP  
SECTION  
=



St. Ethon - Tull Rte No 29618.  
St. Seddon DO 29658.  
St. Nadra DO 29750  
St. Mavi DE 29849.

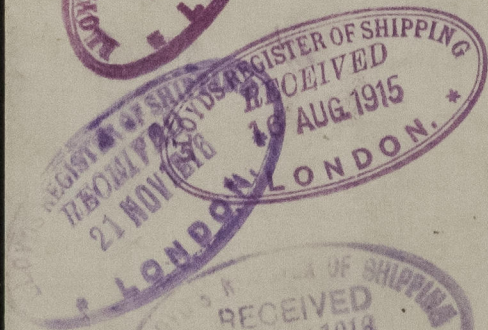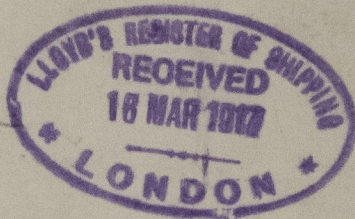

014935-014945-0284

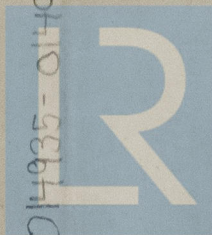

© 2021

Lloyd's Register  
Foundation