

PROPOSED AUXILIARY MOTOR KETCH.

SCALE 1/4" = 1 FOOT.


21.12.09.

PRINCIPAL DIMENSIONS

LENGTH --- 83'-0"

BREADTH --- 20'-0"

DEPTH --- 9'-11"

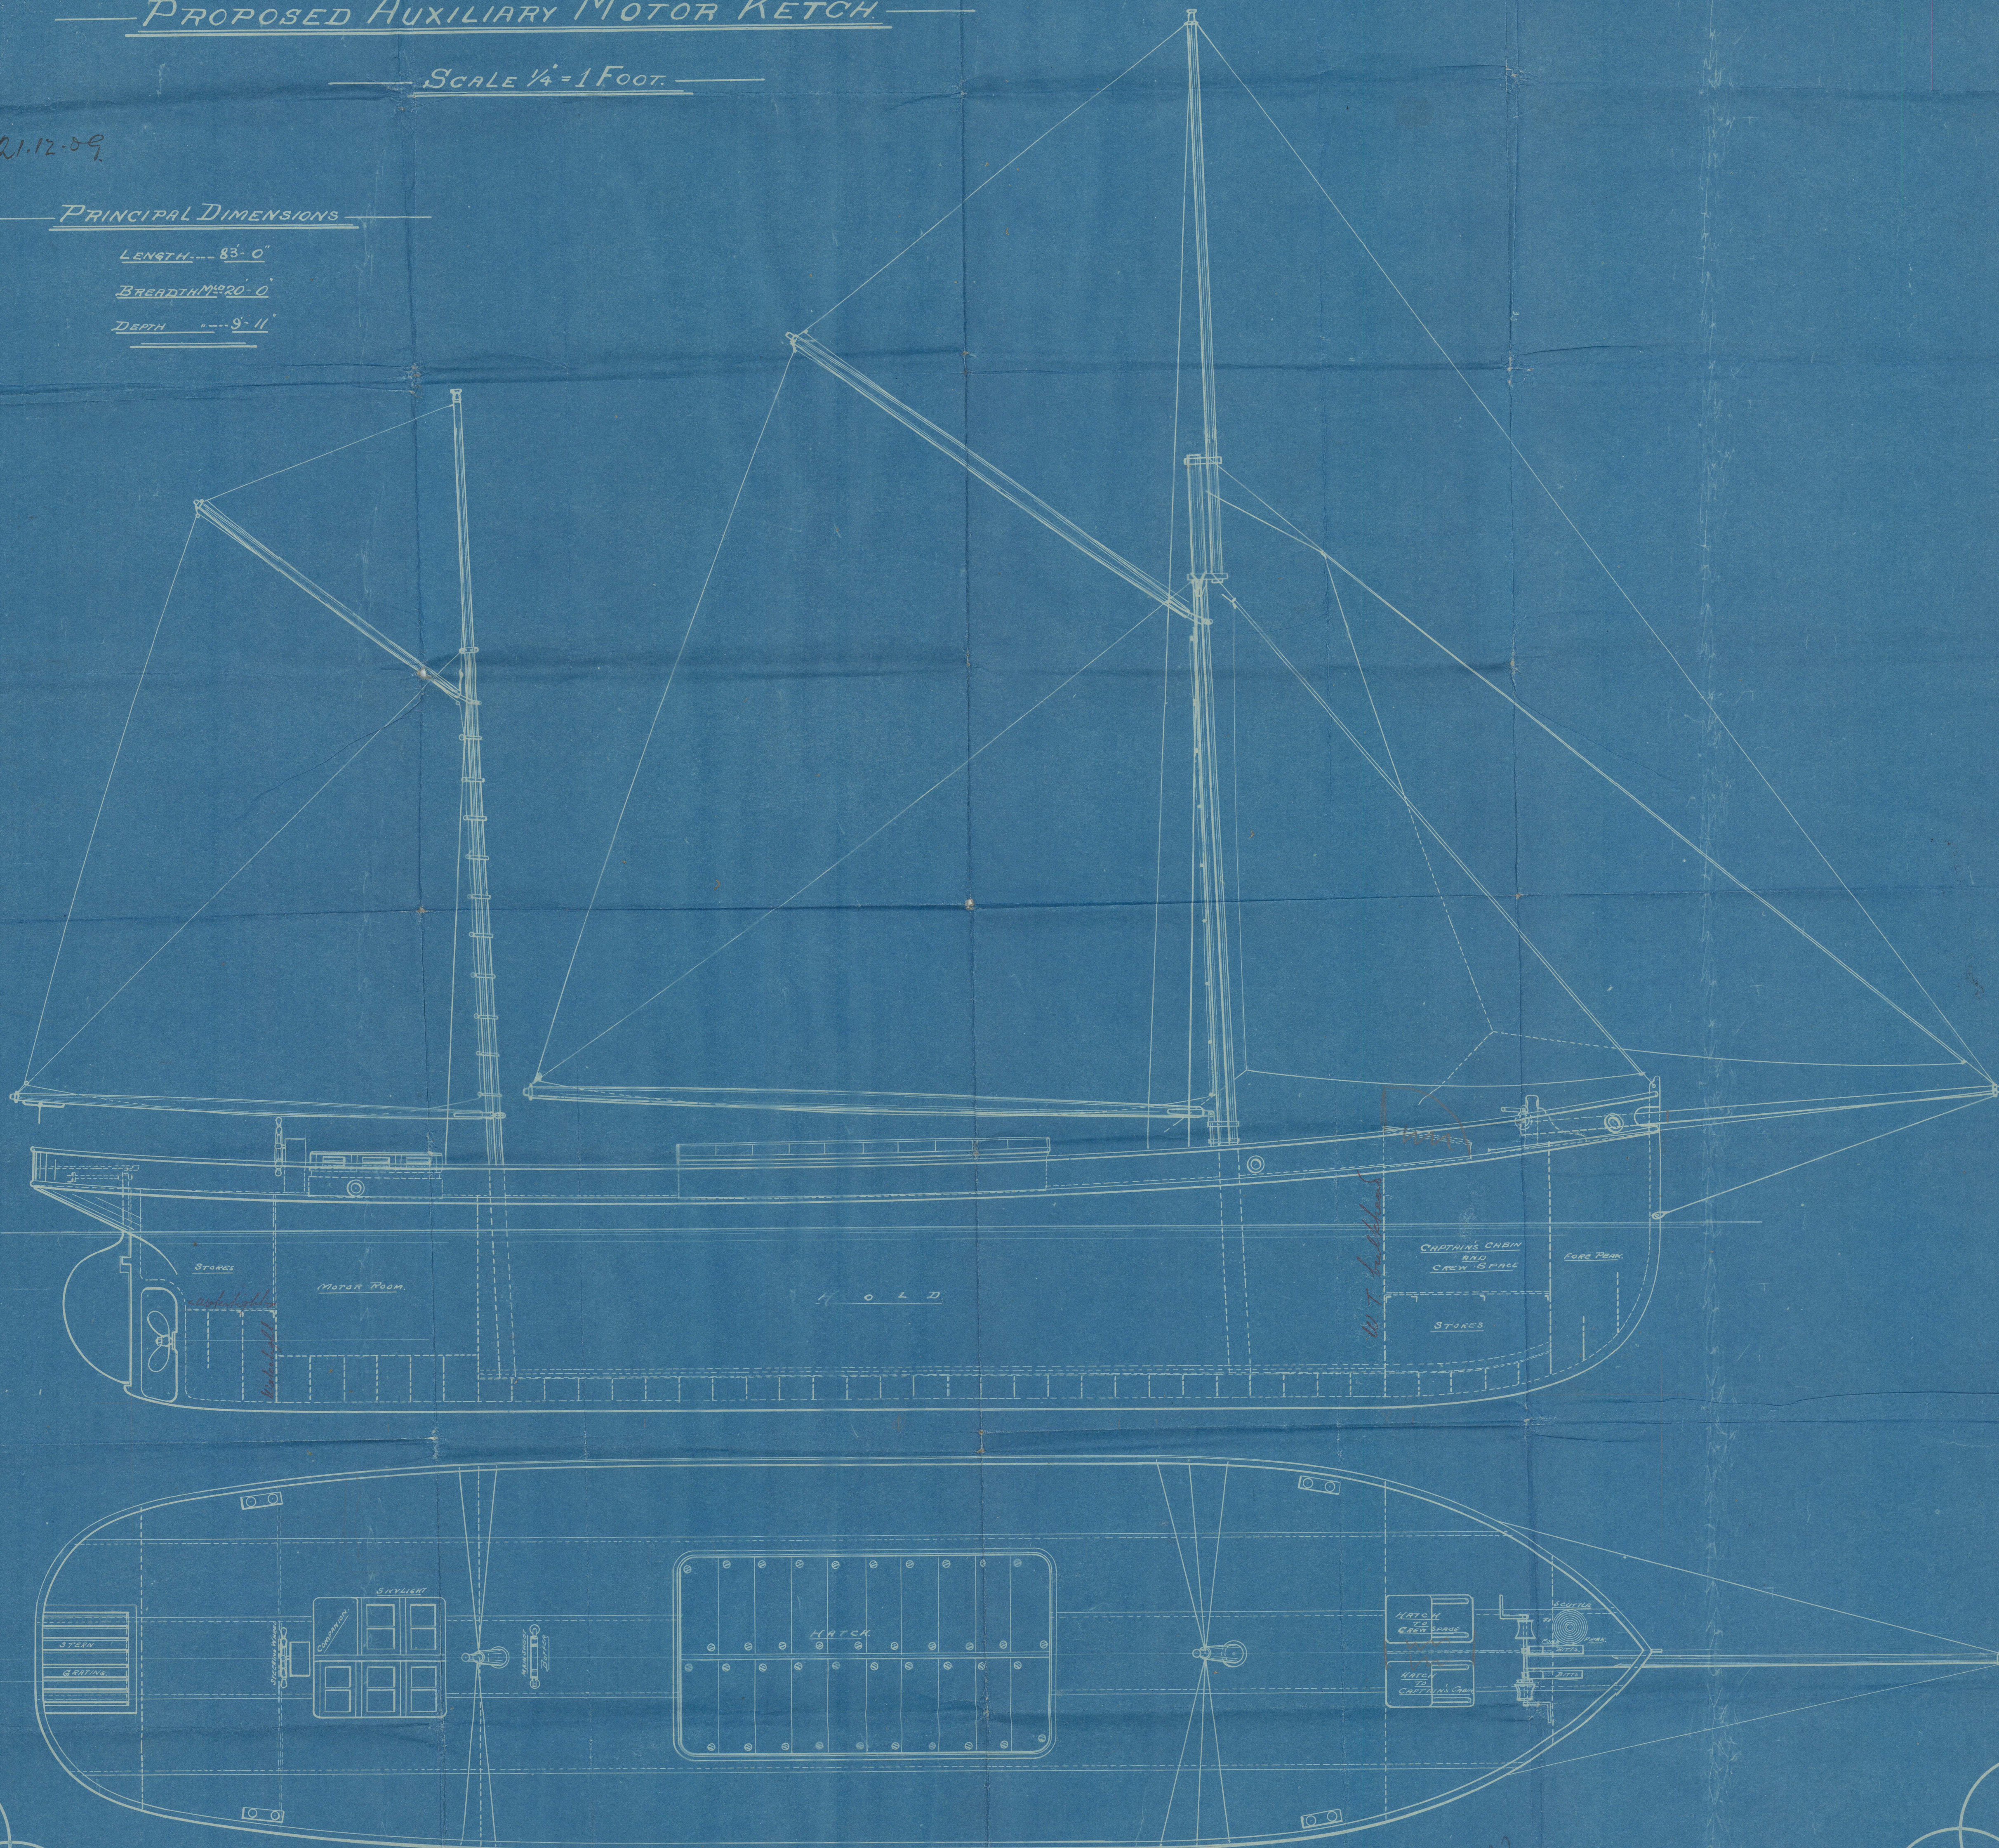


N^o 6496
29.11.09.



© 2021
Lloyd's Register
Foundation

"The Masketch

for rpt. 72845-

Proper
Florette 



© 2021

Lloyd's Register
Foundation
014946-014960-0191