

# MIDSHIP SECTION


TO BE CLASSED 100 A1 FOR COASTING PURPOSES

SCALE 1" = 1 FOOT

1<sup>ST</sup> NUMBER 20.00  
9.92  
29.92

2<sup>ND</sup> NUMBER 29.92  
78  
23936  
20944  
233376

21.12.09

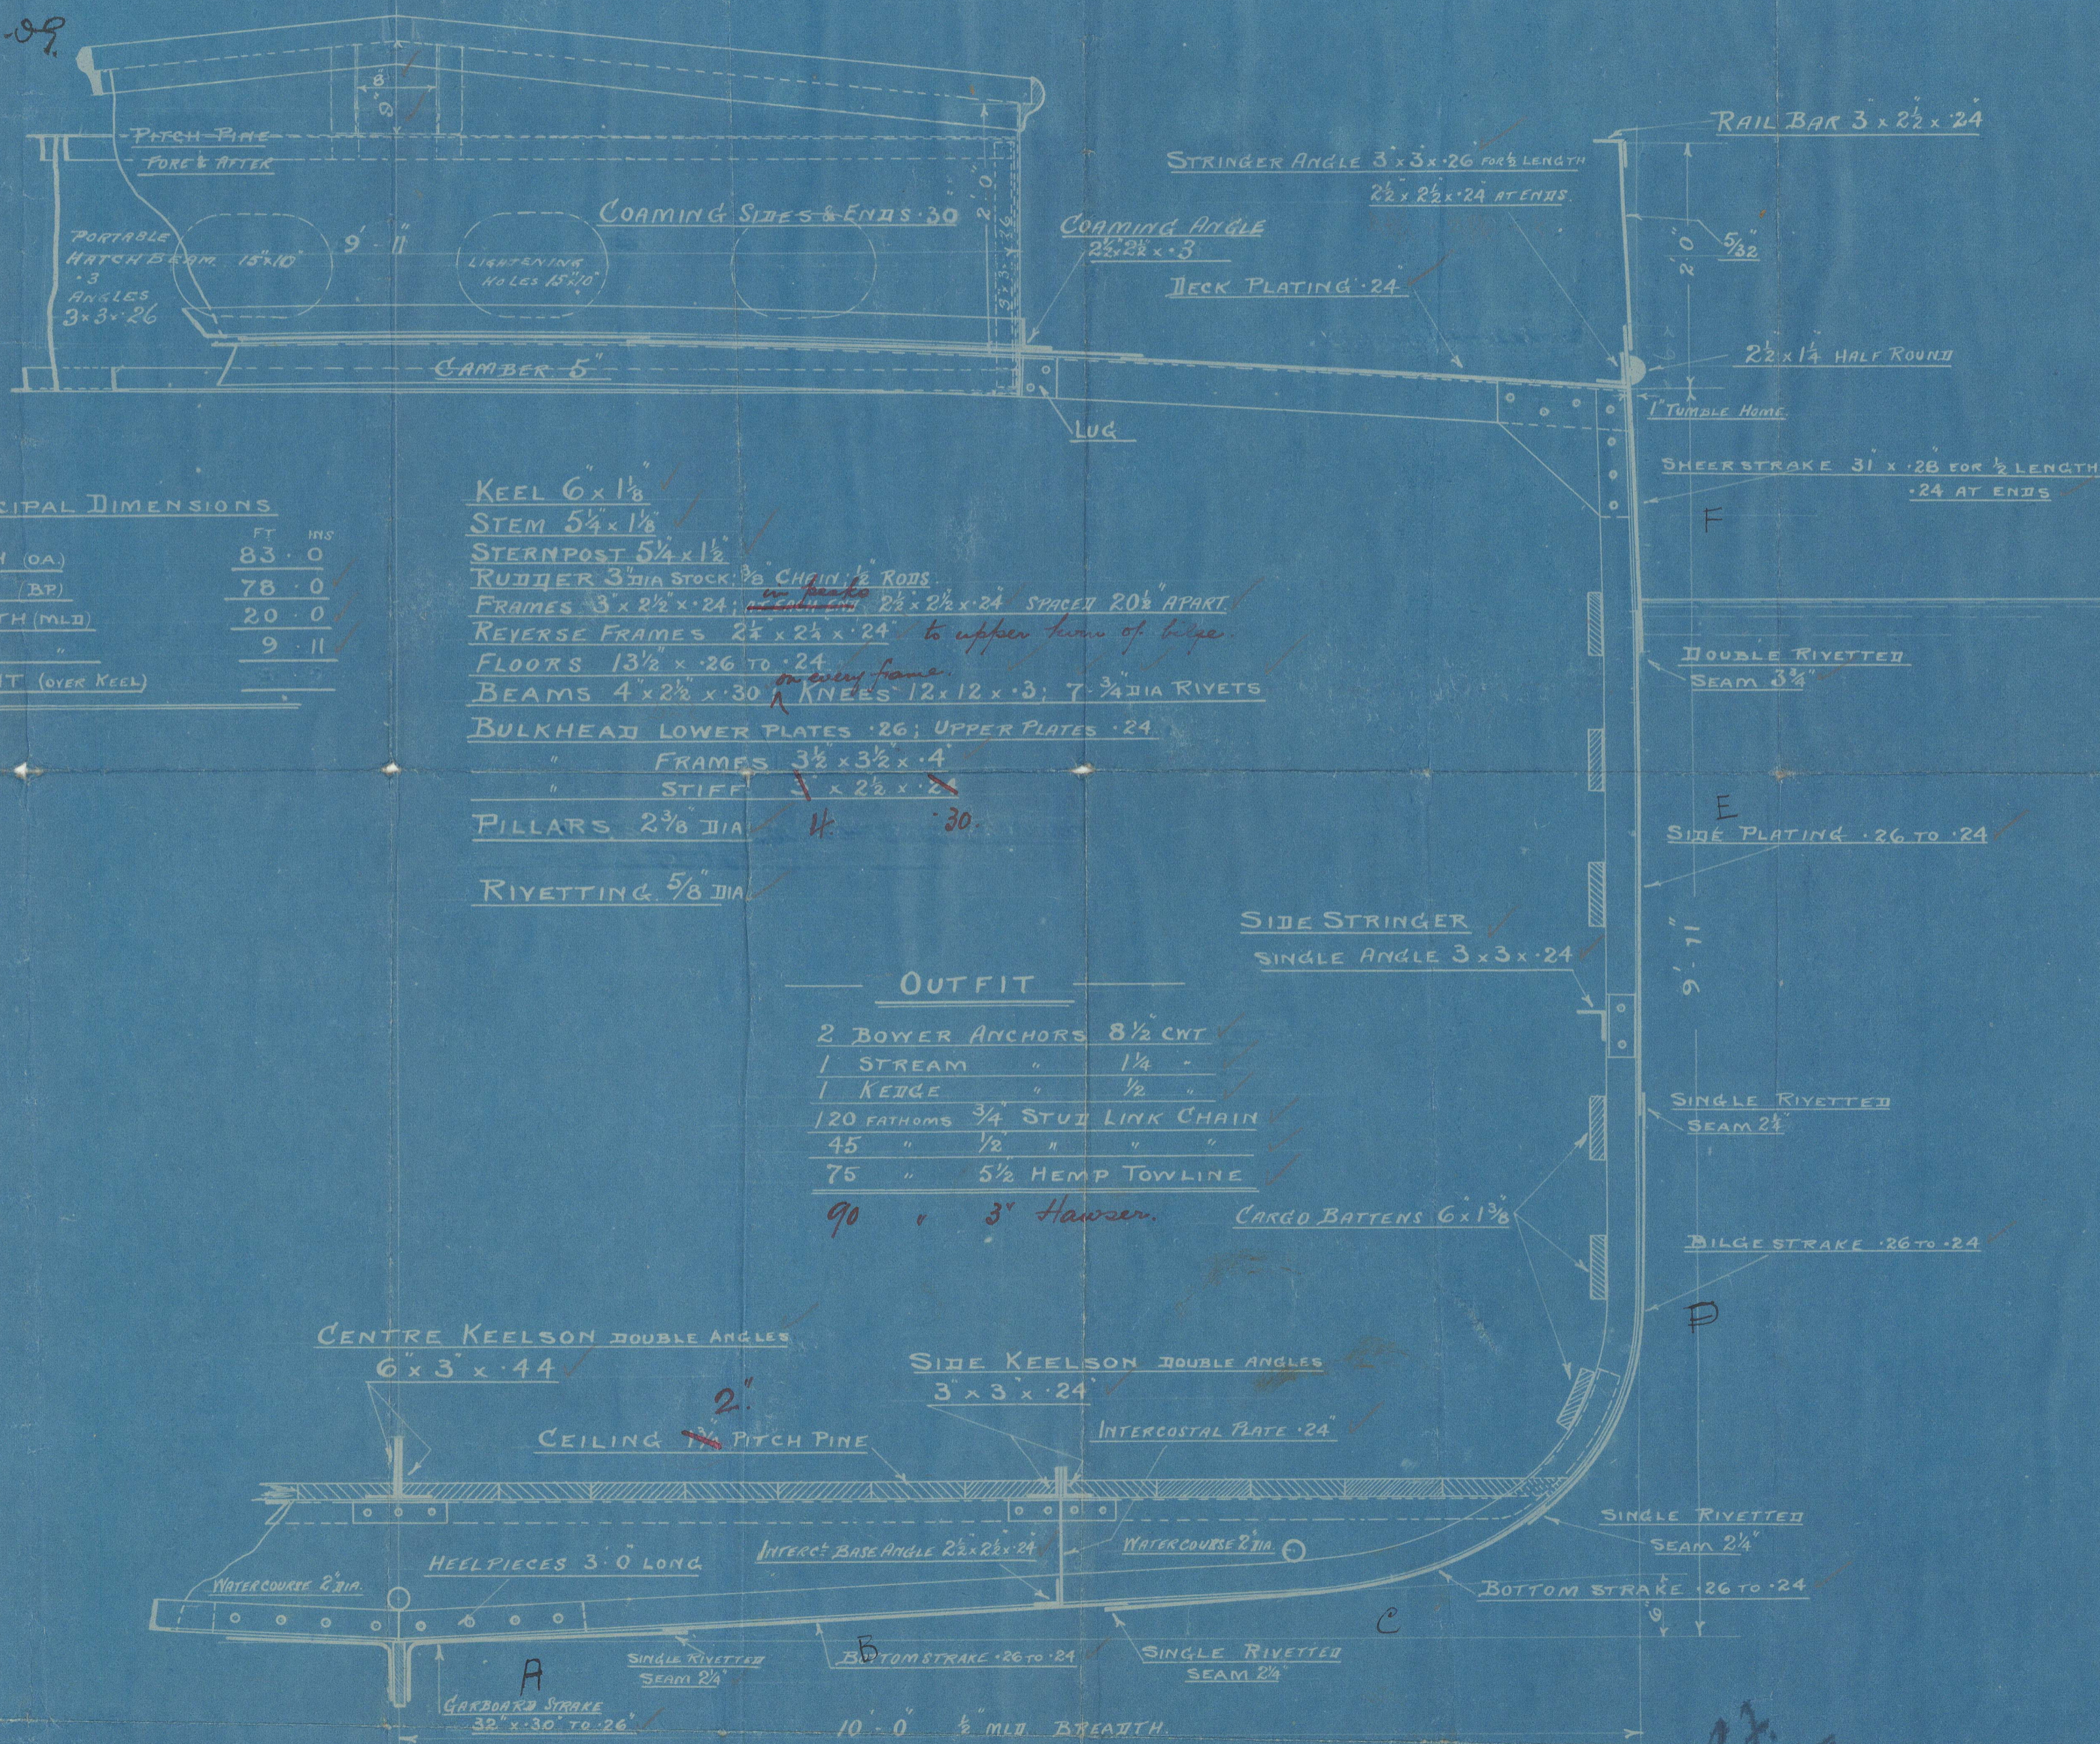

## PRINCIPAL DIMENSIONS

	FT	INS
LENGTH (OA)	83	0
" (BP)	78	0
BREADTH (MLD)	20	0
DEPTH	9	11
DRAUGHT (OVER KEEL)		

KEEL 6 x 1 1/8  
STEM 5 1/4 x 1 1/8  
STERNPOST 5 1/4 x 1 1/8  
RUDDER 3 1/2" DIA STOCK, 3/8" CHAIN, 1/2" ROPS  
FRAMES 3 x 2 1/2 x 24, 2 1/2 x 2 1/2 x 24 SPACED 20" APART  
REVERSE FRAMES 2 1/4 x 2 1/2 x 24 to upper turn of bilge  
FLOORS 13 1/2 x 26 TO 24  
BEAMS 4 x 2 1/2 x 30 KNEES 12 x 12 x 3; 7 3/4" DIA RIVETS  
BULKHEAD LOWER PLATES 26; UPPER PLATES 24  
" FRAMES 3 1/2 x 3 1/2 x 4  
" STIFF 3 x 2 1/2 x 2  
PILLARS 2 3/8" DIA 4 30  
RIVETTING 5/8" DIA

## OUTFIT

2 BOWER ANCHORS 8 1/2 CWT  
1 STREAM " 1 1/4  
1 KEDGE " 1/2  
120 FATHOMS 3/4" STUPE LINK CHAIN  
45 " 1/2 " " "  
75 " 5/8" HEMP TOWLINE  
90 " 3" HAWSER

CARGO BATTENS 6 x 1 1/2"


C.A.  
21/12/09



© 2021  
Lloyd's Register  
Foundation

Aux. motor Ketch "The Motoketch"

Low. Rpt. 42845.

MS  
Fluette 

014946-014960-0192



© 2021

Lloyd's Register  
Foundation